156948

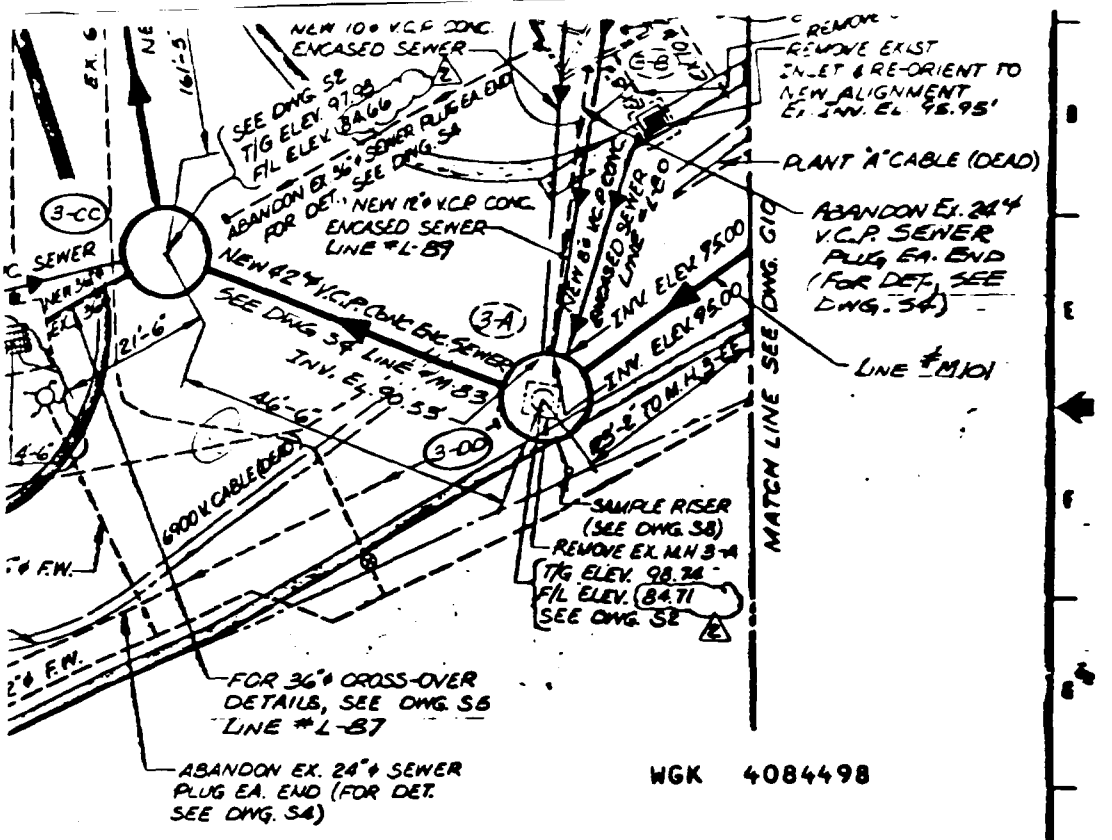

WGK 4084498

FOUNDATION EXPLORE

ACTUAL 42" INSTALL

E:
DERGROUND FACILITIES, STRUCTURES
D UTILITIES HAVE BEEN PLOTTED
OM SURVEYS AND RECORDS.
EREFORE THEIR LOCATION MUST
E CONSIDERED APPROXIMATE ONLY.

KEY PLAN
NDEX OF DWGS. AND GENERAL NOTES
REFERENCE DRAWINGS

REV	CEA	BY / DATE	DESCRIPTION	CHKD / APPD
2	3808	Ammons 10-30-84	REV. FLOW LINE ELEVS. & AS-BUILT DE-WATERING WELL #16	
1	3808	L.C. BECK 2-6-84	GENERAL REVISION	Ammons
0	3808	—	ISSUED FOR WELL CONSTR.	

Monsanto
MONSANTO COMPANY
CORPORATE ENGINEERING DEPT
ST. LOUIS, MISSOURI

COMPANY MIC PLANT KRUMMRICH

PLAN
TRACK #4 TO "D" STREET
MAIN SOUTH TRUNK SEWER

	BY	DATE	APPROVED	DATE	APPROVED	DATE
DRAWN	Ammons					
CHECKED	BECK					
APPROVED			SCALE 1"=10'			

B.E.S. NO.	PLANT	SIZE	SCALE	TYPE	NUMBER	REV
3808	03	D	00.000	C	8	2

EPA/CERRO COPPER/EIL/PCB ATTORNEY WORK PRODUCT / ATTORNEY CLIENT PRIVILEGE