AS-BUILT OF THE GEOTEXTILE ABOVE THE SECONDARY LINER SYSTEM AT THE SAUGET AREA 1 TSCA LANDFILL, CAHOKIA ILLINOIS

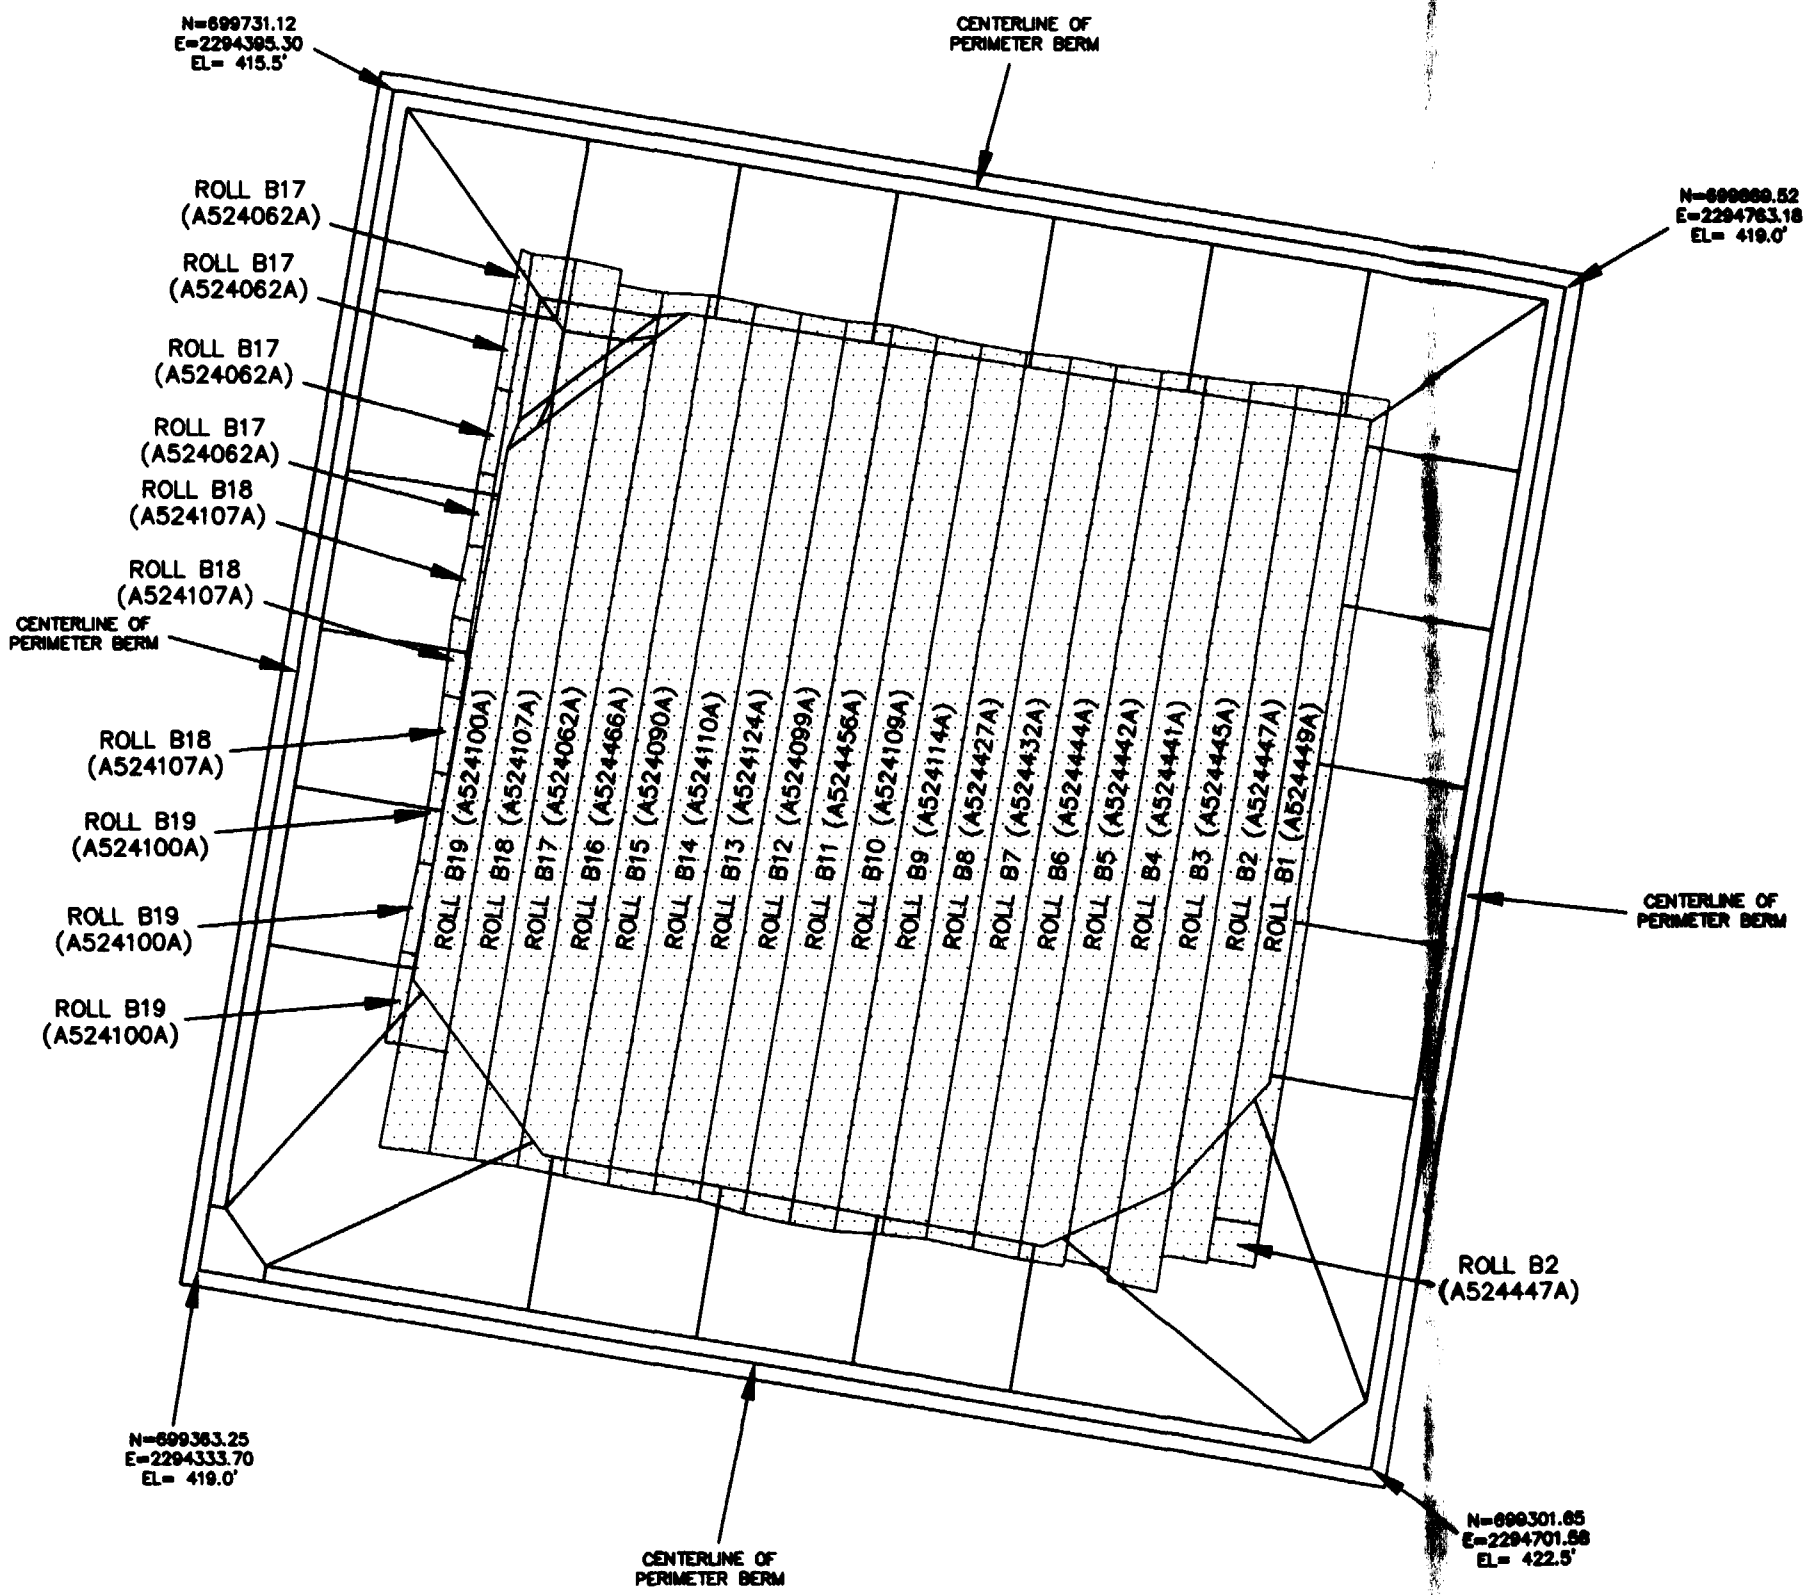

LEGEND:

ROLL 18 = ROLL NUMBER

(A524060A) = LOT NUMBER

= GEOTEXTILE

ENVIRONMENTAL PRECISION ASSOCIATES INC.

ENVIRONMENTAL, LAND AND CONSTRUCTION SURVEY SERVICES
105 PECAN STREET
P.O. BOX 514
TROY, ALABAMA 36081
TEL \ FAX (334) 807-0026
MOBILE: (334) 670-8232
PAGER: (800) 443-7243
D/# 012078

AS-BUILT OF THE GEOTEXTILE ABOVE THE SECONDARY LINER SYSTEM AT THE SAUGET AREA 1 TSCA LANDFILL, CAHOKIA ILLINOIS

DRAWN BY: W.H.S.
CHECKED BY: W.H.S.
SCALE: 1" = 60'
DRAWING DATE: 08/20/01
SURVEY DATE: 08/20/01
CLIENT FILE: 01-500
DRAWING FILE: SOGEOTWO
FLD. BK.: ELECTRONIC
PAGE(S):

166447