PORSF 11.3.31.5.1 v3

USEPA SF 1286396

WILLAMETTE RIVER

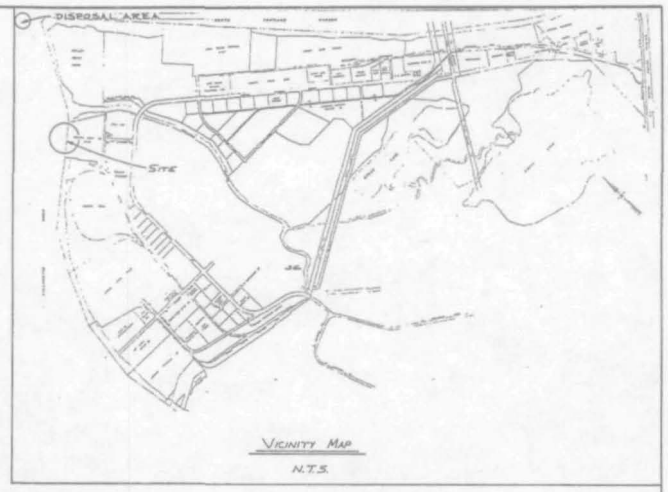

VICINITY MAP
N.T.S.

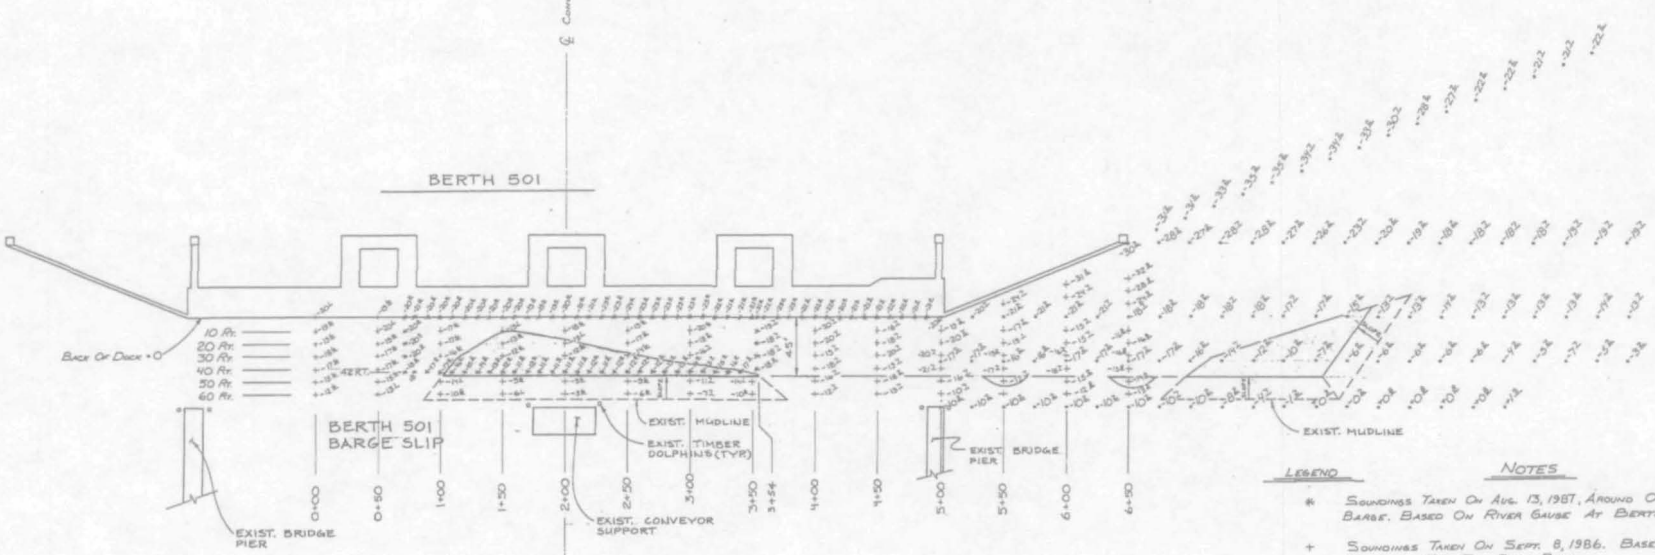

PLAN (1 / C-1)
SCALE: 1" = 50'

LEGEND

NOTES

* SOUNDINGS TAKEN ON AUG. 13, 1987, AROUND OUTLINE OF BARGE. BASED ON RIVER GAUGE AT BERTH 411.

\+ SOUNDINGS TAKEN ON SEPT. 8, 1986. BASED ON RIVER GAUGE AT T-4 FIRE BOAT BASIN.

* SOUNDINGS TAKEN AUG. 13, 1987. BASED ON RIVER GAUGE AT BERTH 411.

AREA TO BE DREDGED TO EL. -15

NO.	DATE	BY	REVISIONS	CK'D	APP'V'D	NO.	DATE	BY	REVISIONS	CK'D	APP'V'D
						1	1-5-88	T.T.	NO AS CONSTRUCTED INFORMATION AVAILABLE		

PORT OF PORTLAND
PORTLAND, OREGON

PROJECT MANAGER

DIRECTOR, ENG. SERVICES — DIRECTOR, MARINE

REGISTERED PROFESSIONAL ENGINEER — OREGON

DESIGNED BY	W.R. HAYNES
DRAWN BY	C.L. WILEY
CHECKED BY	D.L. CONWELL
DATE	AUG. 1987
SCALE	1" = 50'

TERMINAL No. 5

BERTH 501 - BARGE SLIP MAINTENANCE DREDGING
PREDREDGE SOUNDINGS

SUBMITTED BY: ENGINEERING MANAGER

DRAWING NO. T-5 87-2 1/1 (C-1)