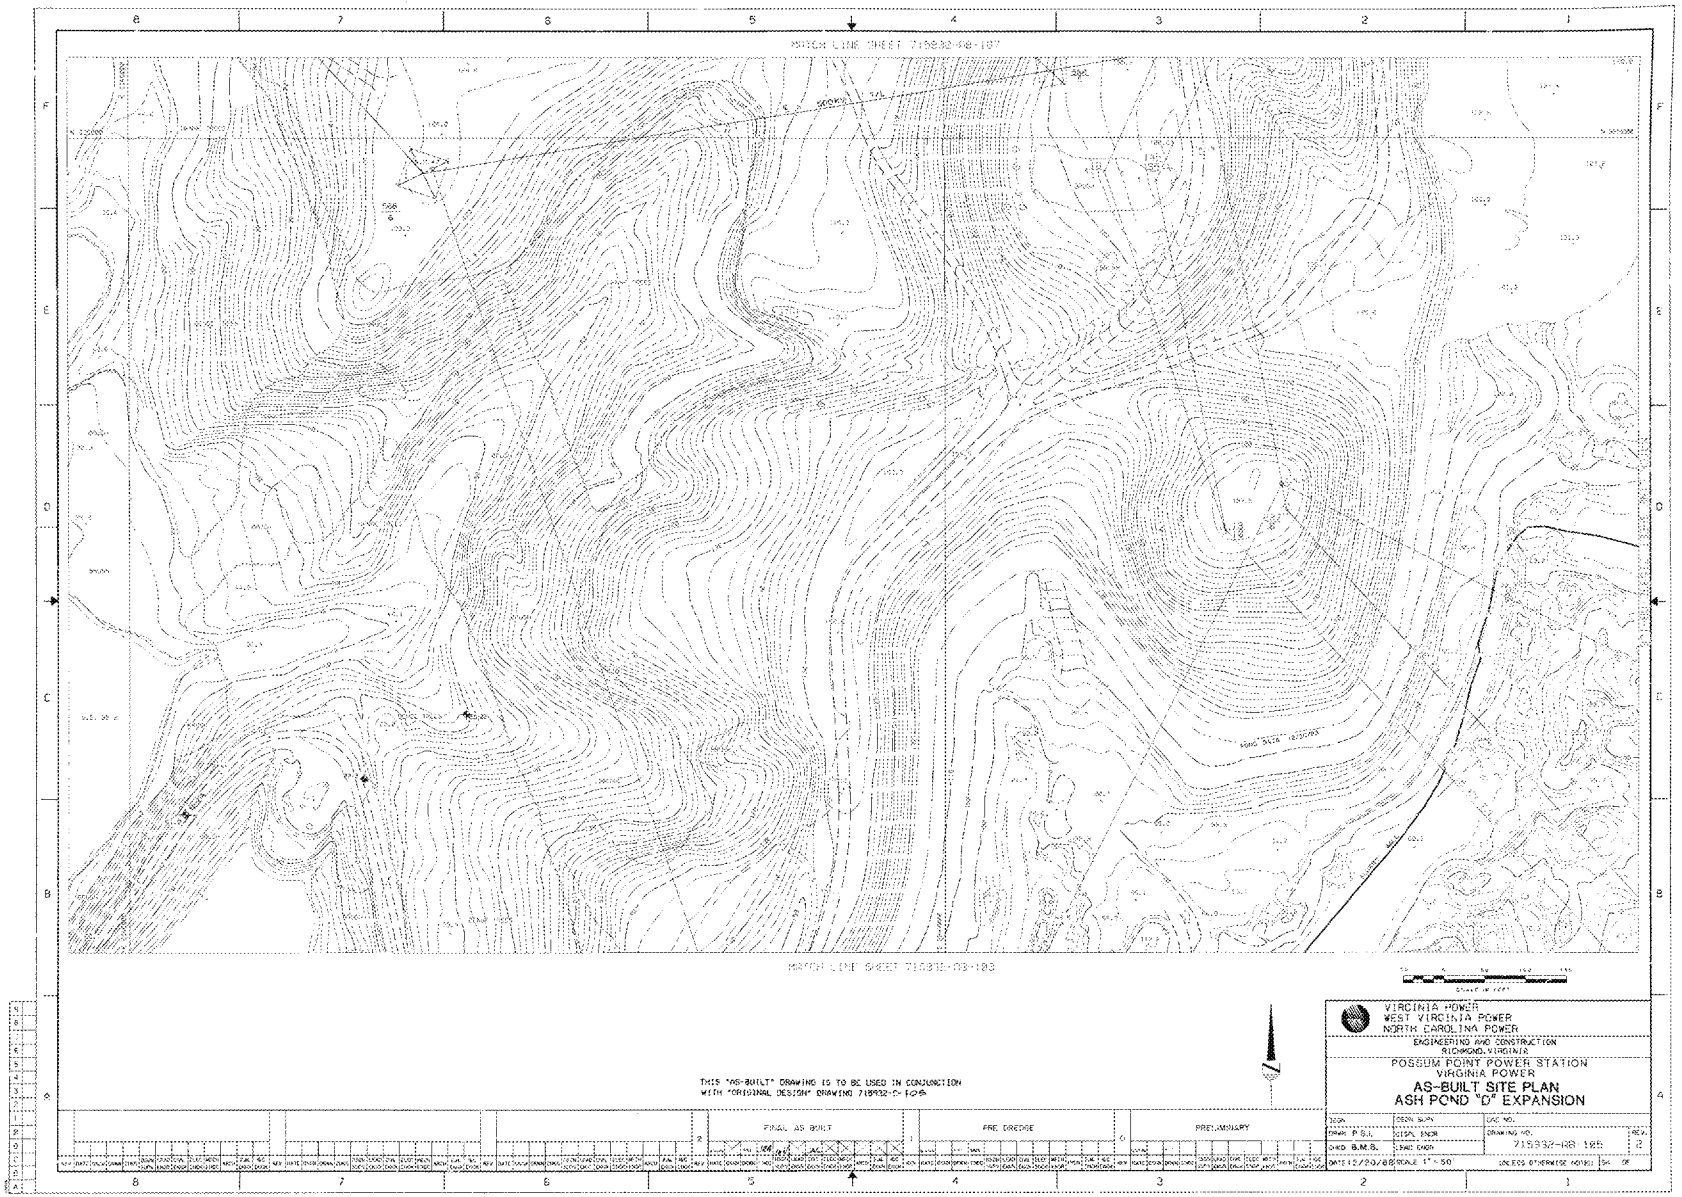
MATCH LINE SHEET 715932-RB-107
MATCH LINE SHEET 715932-RB-103
THIS "AS-BUILT" DRAWING IS TO BE USED IN CONJUNCTION
WITH "ORIGINAL DESIGN" DRAWING 715932-C-105
FINAL AS BUILT
PRE DREDGE
PRELIMINARY
VIRGINIA POWER
WEST VIRGINIA POWER
NORTH CAROLINA POWER
ENGINEERING AND CONSTRUCTION
RICHMOND, VIRGINIA
POSSUM POINT POWER STATION
VIRGINIA POWER
AS-BUILT SITE PLAN
ASH POND "D" EXPANSION
DRAWN P.S.J.
CHKD B.M.S.
DATE 12/20/88
SCALE 1" = 50'
DRAWING NO. 715932-RB-105
REV. 2
UNLESS OTHERWISE NOTED

00012119