FREE PRODUCT RECOVERY SYSTEM

AVERY, IDAHO

POTLATCH CORPORATION

VICINITY MAP

TABLE OF CONTENTS

1. SHEET 1 OF 3 TITLE SHEET
2. SHEET 2 OF 3 SITE PLAN
3. SHEET 3 OF 3 CROSS SECTION/DETAILS

BENCHMARK:

DESIGNED BY: J.A. HEST | CHECKED BY: D.G. WINTER
DRAWN BY: JUAN A. HERNANDEZ | CHECKED BY: B.L. KELLEMS

NO.	DATE	BY	REVISION

HARTCROWSER
Hart Crowser, Inc.
1910 Fairview Avenue East
Seattle, Washington 98102-3699
206.324.9530

FREE PRODUCT RECOVERY SYSTEM
TITLE SHEET
POTLATCH CORPORATION

TYPE DRAWING: FINAL / CONST. / RECORD X
DATE: 12/16/94
JOB NO. 2296-05
SHEET 1 OF 3 SHEETS

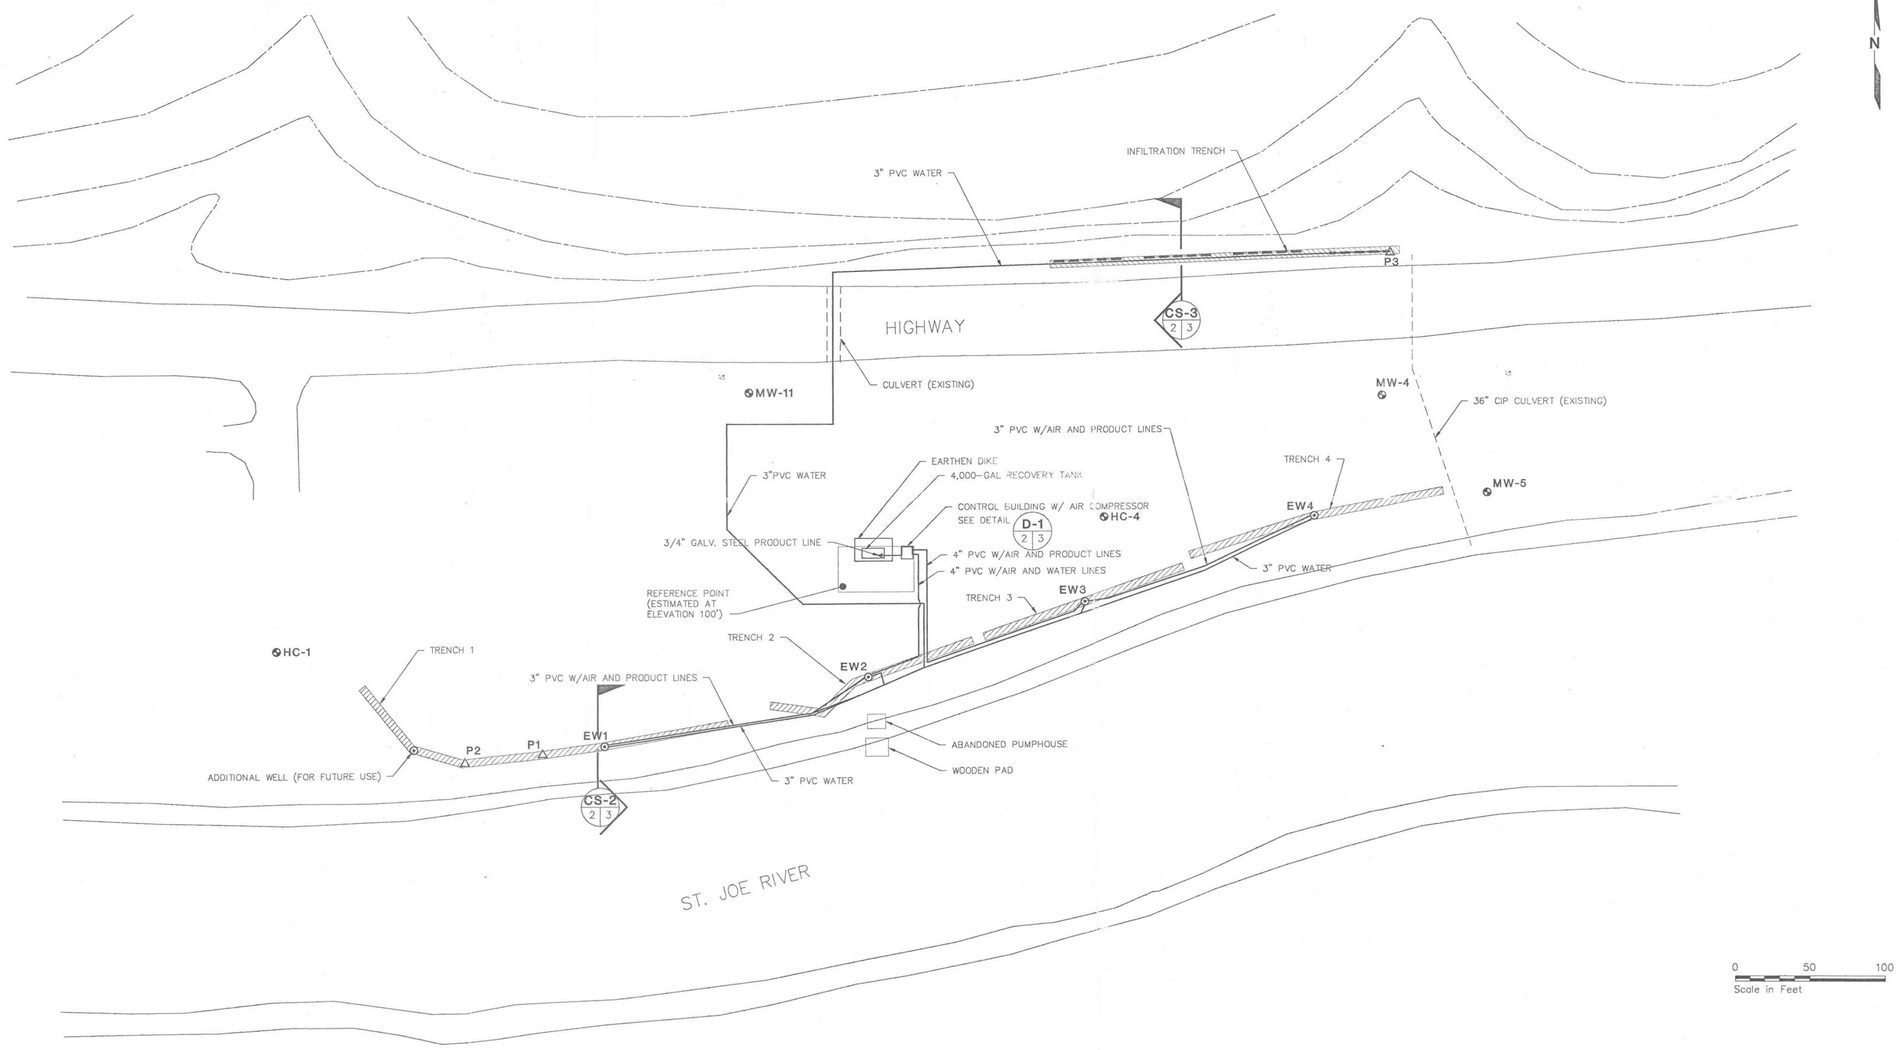

MW-4	MONITORING WELL LOCATION AND DESIGNATION
EW1	EXTRACTION WELL LOCATION AND DESIGNATION
P1	PIEZOMETER LOCATION AND DESIGNATION
— — — —	3" PVC 20-SLOT WELL SCREEN
	INFILTRATION TRENCH
	EXTRACTION TRENCH

BENCHMARK:

DESIGNED BY:	J.A. HEST	CHECKED BY:	D.G. WINTER
DRAWN BY:	S.W. PARK	CHECKED BY:	B.L. KELLEMS

NO.	DATE	BY	REVISION

HARTCROWSER
Hart Crowser, Inc.
1910 Fairview Avenue East
Seattle, Washington 98102-3699
206.324.9530

FREE PRODUCT RECOVERY SYSTEM
SITE PLAN

POTLATCH CORPORATION

TYPE DRAWING	SHEET
PRELIM.	2
CONST.	OF
RECORD X	3
DATE: 12/19/94	SHEETS
JOB NO. 2296-05	

2296D05 EJC 12/20/94 PLOT: 1=50

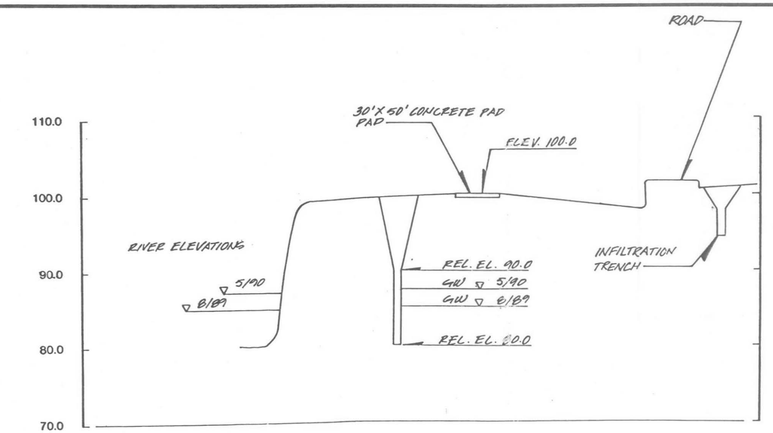

NOTES:

1. REFERENCE POINT FOR RELATIVE ELEVATIONS IS 30'X 50' CONCRETE PAD.
2. THE INSTALLER IS RESPONSIBLE FOR TEMPORARY SHORING AND DEWATERING NECESSARY FOR TRENCH INSTALLATION.
3. EXCAVATED SOIL AND GROUNDWATER MAY CONTAIN PETROLEUM HYDROCARBONS. INSTALLER IS RESPONSIBLE FOR WORKER HEALTH AND SAFETY, AND PROPER SOIL DISPOSAL.

SECTION CS-1 / 2 | 3
NOT TO SCALE

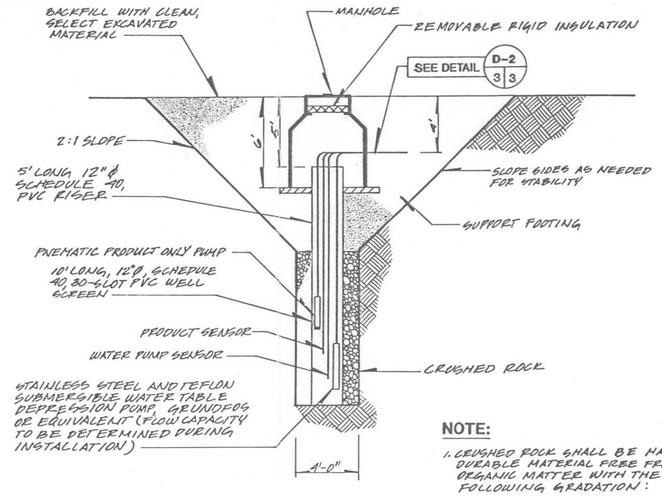

NOTE:

1. CRUSHED ROCK SHALL BE HARD, DURABLE MATERIAL FREE FROM ORGANIC MATTER WITH THE FOLLOWING GRADATION:

US SIEVE SIZE	% FINER
3 INCH	100
1/4 INCH	0-2

SECTION CS-2 / 2 | 3
NOT TO SCALE

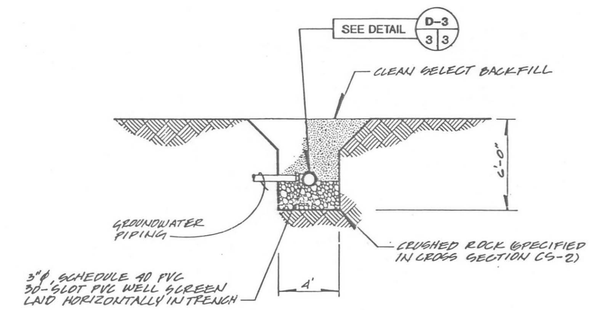

SECTION CS-3 / 2 | 3
NOT TO SCALE

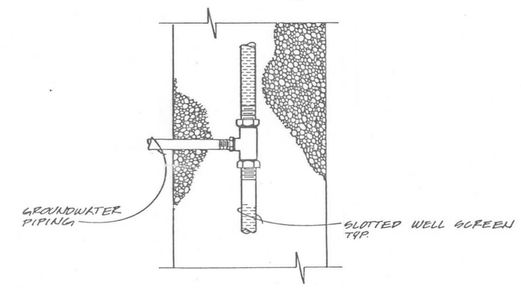

SECTION CONNECTION DETAIL / D-3 / 3 | 3
NOT TO SCALE

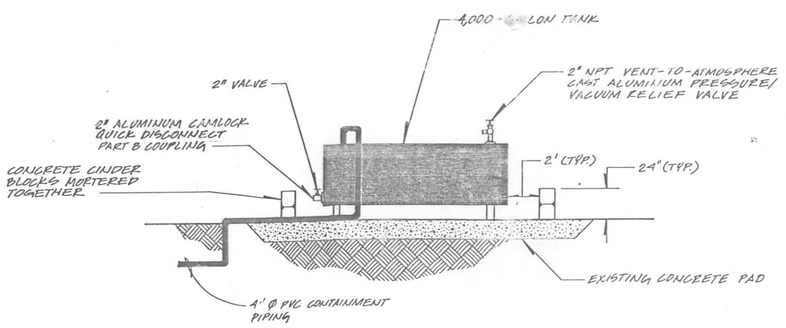

NOTE:

1. ~~CONSTRUCT~~ CONTAINMENT ON ALL SIDES ~~OF TANK~~ (LONG SIDES ~~OF CONTAINMENT~~ NOT SHOWN IN DRAWING)

ACTUAL CONTAINMENT CONSTRUCTED USING EARTHEN BERMS

TANK AND CONTAINMENT DETAIL / D-1 / 2 | 3
NOT TO SCALE

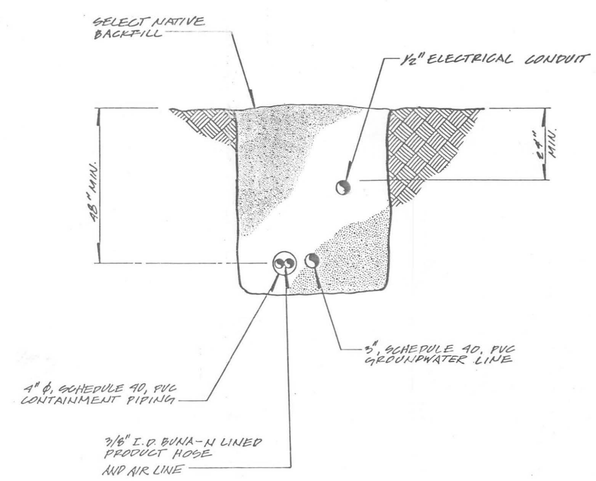

TRENCH DETAIL / D-2 / 3 | 3
NOT TO SCALE

BENCHMARK:

DESIGNED BY: J.A. HEST | CHECKED BY: D.G. WINTER
DRAWN BY: JUAN A. HERNANDEZ | CHECKED BY: B.L. KELLEMS

NO.	DATE	BY	REVISION

HARTCROWSER
Hart Crowser, Inc.
1910 Fairview Avenue East
Seattle, Washington 98102-3699
206.324.9530

FREE PRODUCT RECOVERY SYSTEM

CROSS SECTION / DETAILS

POTLATCH CORPORATION

TYPE DRAWING: FINAL CONST. RECORD ×
DATE: 12/16/94
JOB NO. 2296-05
SHEET 3 OF 3 SHEETS