SEMS-RM DOCID # 1164846

CITY OF

MOUNTAIN VIEW

SANTA CLARA COUNTY, CALIFORNIA

MOFFETT BOULEVARD SANITARY SEWER RELOCATION PROJ. 69-4

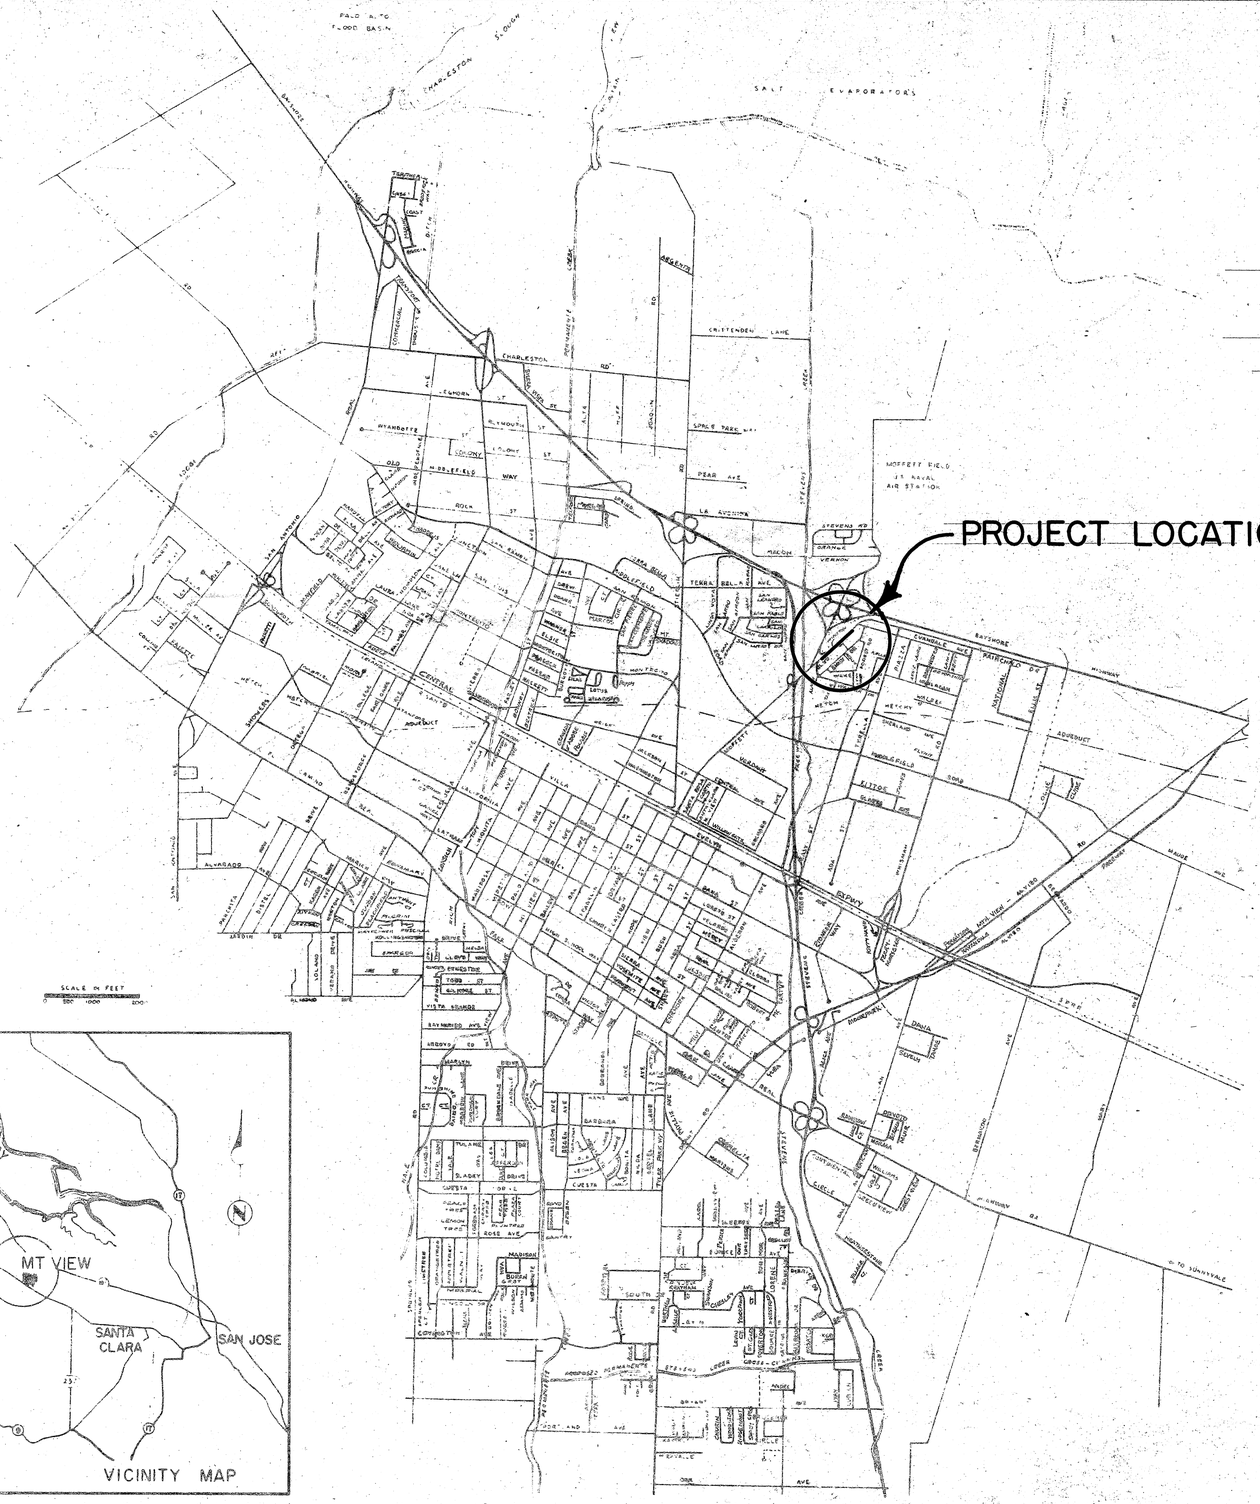

LOCATION MAP

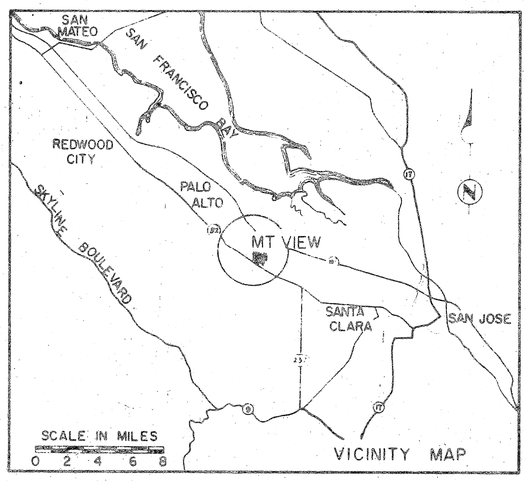

VICINITY MAP

LEGEND

EXISTING	PROPOSED	DESCRIPTION
R/W	R/W	RIGHT-OF-WAY LINE
P.		PROPERTY LINE
		CURB, GUTTER AND SIDEWALK
℄	PROP. ℄	CENTERLINE
SS	SS	SANITARY SEWER & MANHOLE
W	W	WATER MAIN
SD	SD	STORM SEWER & MANHOLE
		STORM INLET & INLET RUN
		FIRE HYDRANT
W	W	BLOW OFF OR AIR RELIEF
W	T	TEE
W		CROSS
PB E	PB E	ELECTROLIER, CONDUIT & PULLBOX
G		GAS LINE
T		TELEPHONE DUCT
PP	PP	TELEPHONE OR POWER POLE
SS	SS	STREET SIGN
SS	SS	STOP SIGN
SS	S/S	STREET SIGN & STOP SIGN
E		ELECTROLIER & STREET SIGN
		FUTURE ELECTROLIER
		GATE VALVE
		EXISTING TREE
		TREE TO BE REMOVED
EP		EXISTING EDGE OF PAVEMENT
M	M	STANDARD CITY MONUMENT
		SANITARY SEWER LATERAL W/CLEANOUT

AS BUILT PLAN

DATE: 3-31-71 BY: CMC

No Changes, this sheet

APPROVAL RECOMMENDED		APPROVED BY		SHEET
R. J. Leach		Allen Shelley		1
SENIOR ENGINEER		ASST. DIRECTOR OF PUBLIC WORKS		OF
5-16-69	16111	7-28-69	16390	2
DATE	R.C.E. NO.	DATE	R.C.E. NO.	

FILE NO. 5477-1

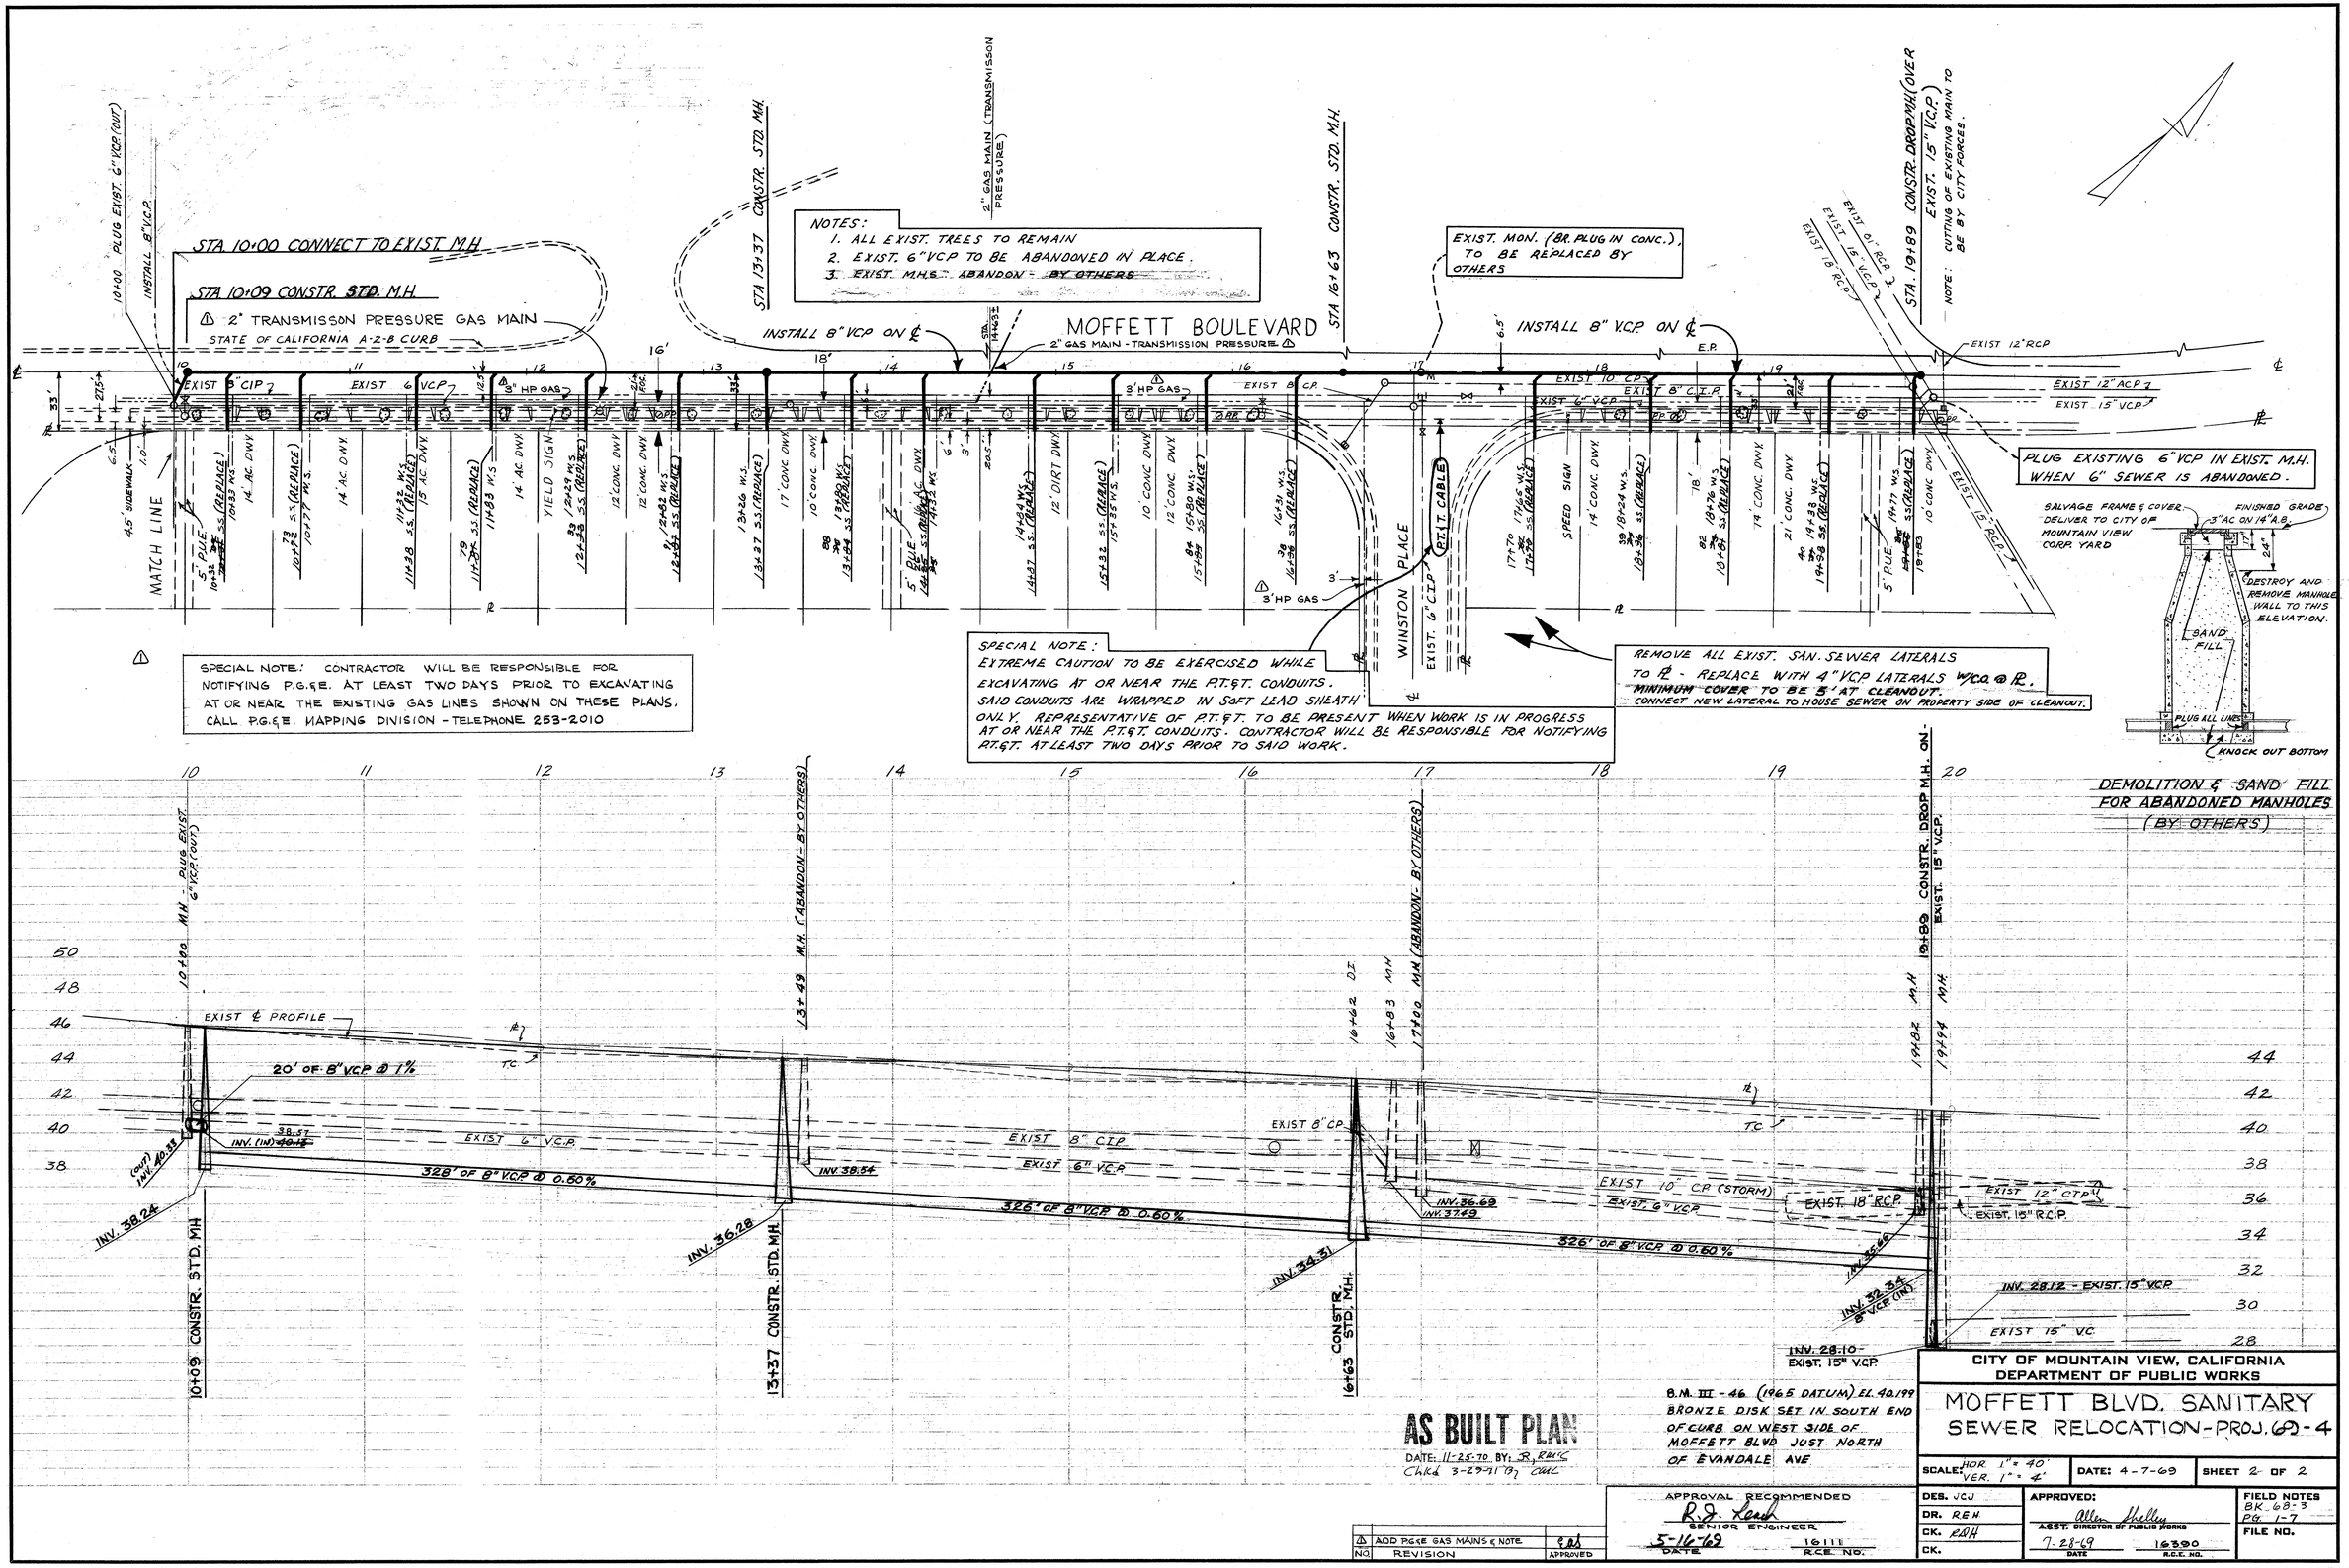

FILE NO. 5477-2