POOR LEGIBILITY

ONE OR MORE PAGES IN THIS DOCUMENT ARE DIFFICULT TO READ
DUE TO THE QUALITY OF THE ORIGINAL

SEMS-RM DOCID # 1164924

AS BUILT PLAN

By JDW - 4-4-60

APPROVED May 21 1959 BY [signature] RE 6726

CK. BY: [initials]

DRAWN BY: E.M.
DESIGNED BY: A.M.K.
CHECKED BY: V.W.L.
DATE: FEB. 1959
SCALE: 1" = 40'

REVISIONS

DATE	
11/13/59	Added 137.45' curb, gutter & sidewalk lot 23 Gladys ave. SHEET 2

GEORGE S. NOLTE
CIVIL ENGINEER · LAND SURVEYOR
PALO ALTO · SANTA CLARA · WALNUT CREEK
SAN RAFAEL · SANTA CRUZ
R.E. 7595

IMPROVEMENT PLANS OF
EASY STREET EXTENSION
MOUNTAIN VIEW, CALIFORNIA

File # 26341

SHEET 2 OF 6

JOB NO. 178-58

MICROFILMED FEB 65
CONTRACT PLAN

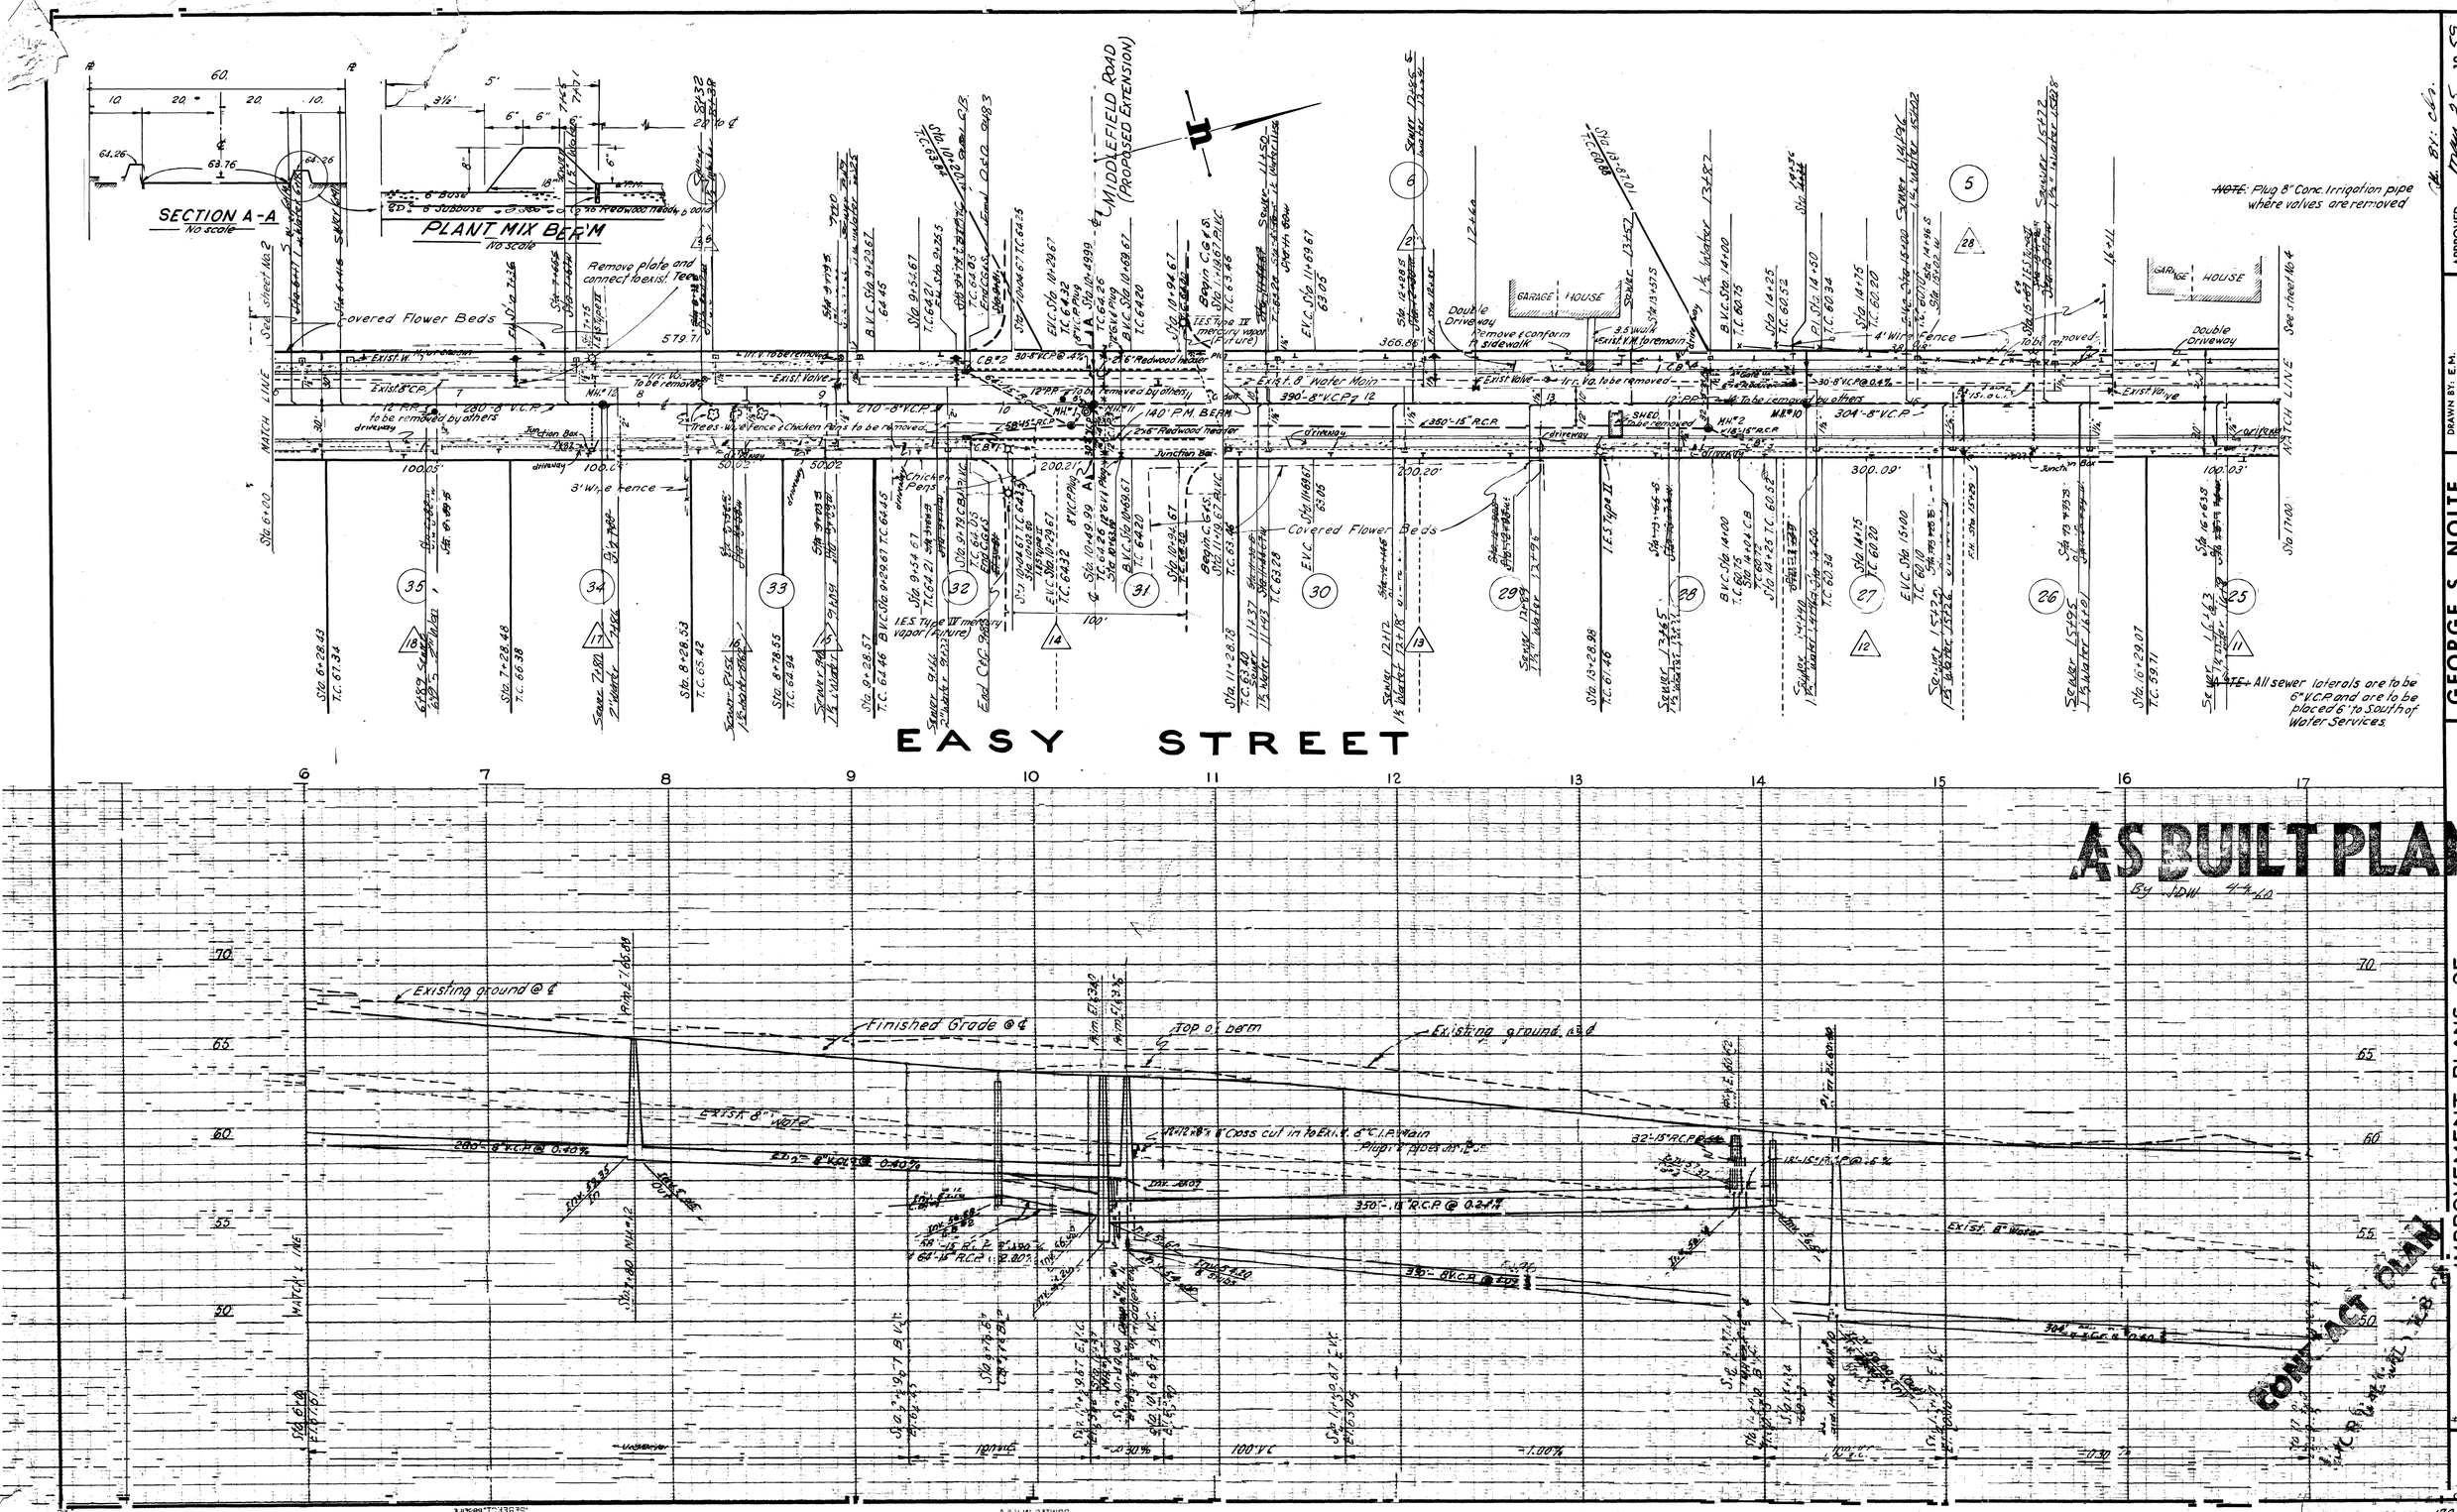

APPROVED May 25 1959
BY Ammcgino
BY

DRAWN BY: E.M.
DESIGNED BY: A.M.K.
CHECKED BY: V.W.L.
DATE: FEB. 1959
SCALE: 1"=40'

GEORGE S. NOLTE
CIVIL ENGINEER
PALO ALTO · SANTA CLARA · WALNUT CREEK
SAN RAFAEL · SANTA CRUZ
R. E. 7595

IMPROVEMENT PLANS OF
EASY STREET EXTENSION
MOUNTAIN VIEW, CALIFORNIA

FILE #26347

SHEET 3 OF 6

JOB NO. 178-58

Ck. By: [signature]

APPROVED May 25 1959

BY A.M. McKinnon

BY

DRAWN BY: E.M.
DESIGNED BY: A.M.K.
CHECKED BY: V.W.L.
DATE: FEB. 1959
SCALE: 1" = 40'

GEORGE S. NOLTE
CIVIL ENGINEER · LAND SURVEYOR
PALO ALTO · SANTA CLARA · WALNUT CREEK
SAN RAFAEL · SANTA CRUZ
R. E. 7595

IMPROVEMENT PLANS OF
EASY STREET EXTENSION
MOUNTAIN VIEW, CALIFORNIA

FILE 2634-3

SHEET 4 OF 6

2634-3

JOB NO. 178-58

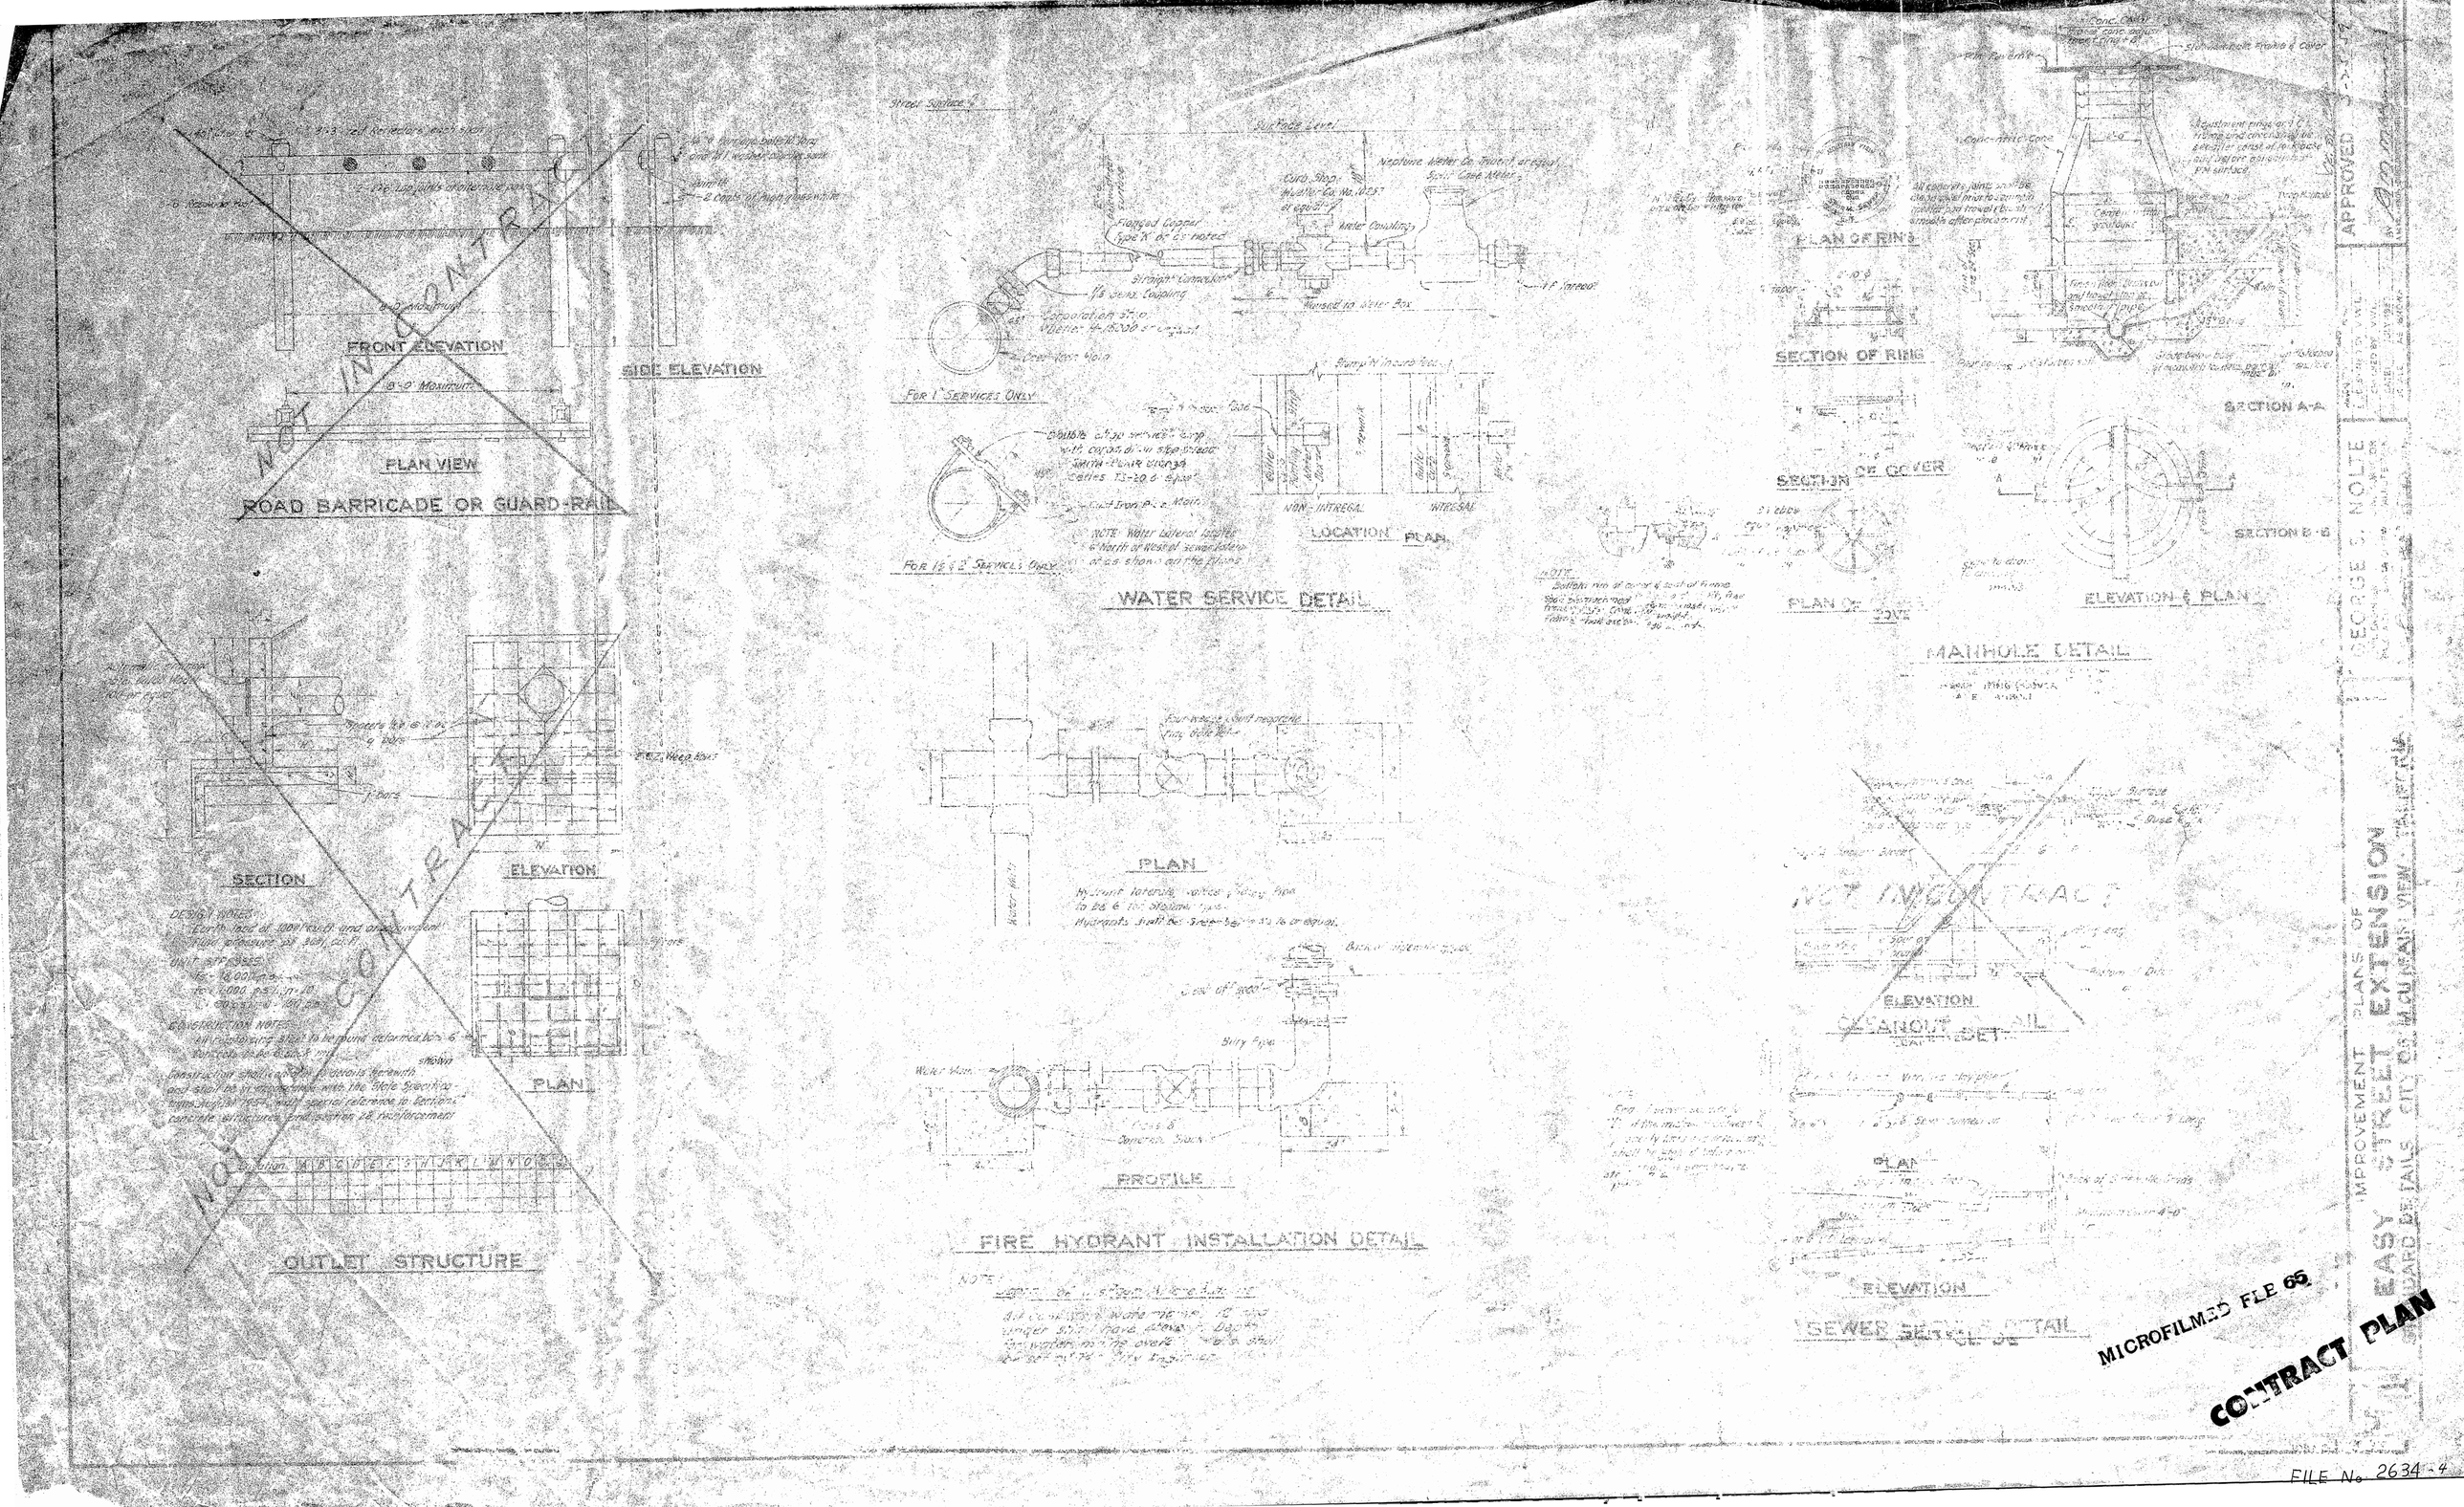

FRONT ELEVATION
SIDE ELEVATION
PLAN VIEW
ROAD BARRICADE OR GUARD-RAIL
NOT IN CONTRACT
SECTION
ELEVATION
PLAN
OUTLET STRUCTURE
WATER SERVICE DETAIL
LOCATION PLAN
PLAN
PROFILE
FIRE HYDRANT INSTALLATION DETAIL
PLAN OF RING
SECTION OF RING
SECTION OF COVER
PLAN OF COVER
SECTION A-A
SECTION B-B
ELEVATION & PLAN
MANHOLE DETAIL
NOT IN CONTRACT
ELEVATION
CLEANOUT DETAIL
PLAN
ELEVATION
SEWER SERVICE DETAIL
APPROVED
GEORGE S. NOLTE
IMPROVEMENT PLANS OF
EASY STREET EXTENSION
STANDARD DETAILS CITY OF MOUNTAIN VIEW, CALIFORNIA
MICROFILMED FEB 65
CONTRACT PLAN
FILE No. 2634-4

GENERAL:
The Street Name Sign assemblies of the specified post, base, street name sign, & street number sign and mounting flags completely installed and painted in a manner in keeping with the highest standards of practice in the trade. The installation shall be in place at each intersection before final acceptance of the subdivision shall be given.

BASE:
A concrete base 8" in diameter and 28" deep shall be constructed around each post, the top edge being flush with the back of sidewalk and the bottom 2" below the end of the post.

POST:
The post shall be 2" standard steel pipe 10 feet in length with one end finished to receive mounting cap and flags.

SIGNS:
Street name signs and street number signs shall be type 624 DN54 with pipe mounting attachments and detachable block numbers as manufactured by Ferro Engineering Company, or equal approved by the Engineer, mounted back to back, facing in opposite directions.

PAINT:
Posts and mounting attachments shall be given a prime coat of paint before erection. The priming shall be either DuPont's Krylite prime #67110, or W.P. Fullers Fulltek primer #1850 or approved equal.

After erection the exterior shall be cleaned and touched up with primer where needed. The finish coat shall consist of two coats of W.P. Fullers Myratec white enamel #1920 or approved equal. The section 12" above the sidewalk level shall be painted with W.P. Fullers Myratec black enamel #1921 or approved equal.

STREET SIGN DETAIL
SCALE 1" = 10"

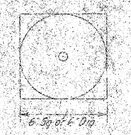

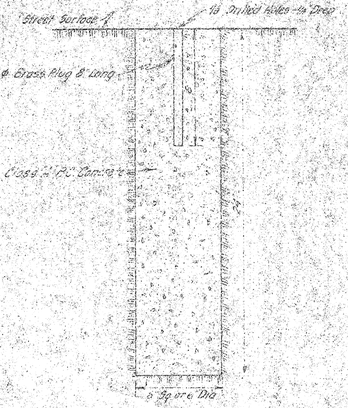

CITY MONUMENT DETAIL
SCALE 1" = 5"

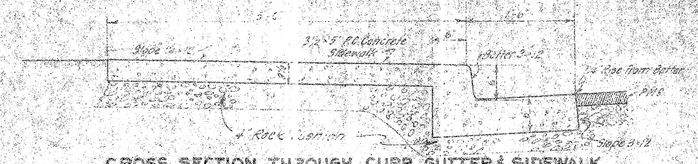

CROSS SECTION THROUGH CURB, GUTTER & SIDEWALK
SCALE 1" = 1'-0"

CROSS SECTION THROUGH DRIVEWAY
SCALE 1" = 1'-0"

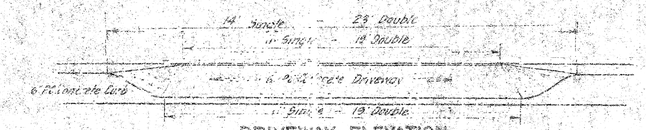

DRIVEWAY ELEVATION

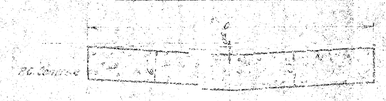

VALLEY GUTTER

NOTE:
Topping: 1 sack Cement
1½ cubic feet Sand
1½ cubic feet Rock
for each 120 square feet.

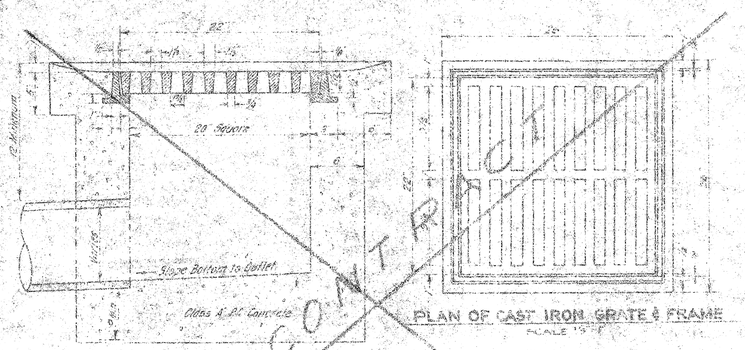

SECTION THROUGH BASIN
SCALE 1" = 5'

CATCH BASIN DETAIL
FLAT GRATE TYPE

NOT IN CONTRACT

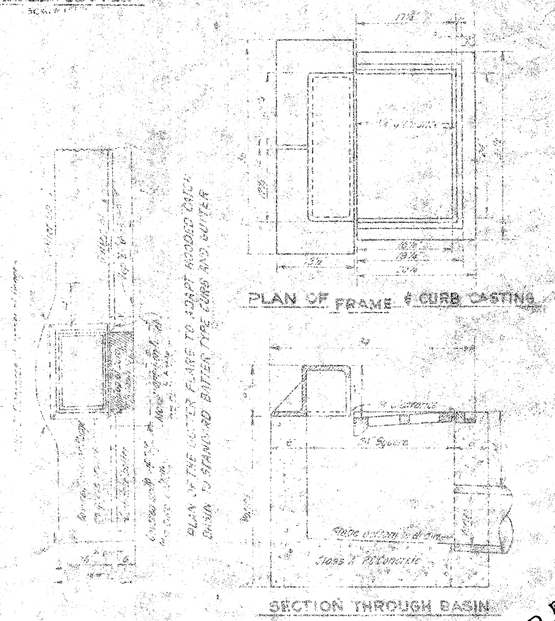

SECTION THROUGH BASIN

HOODED CATCH BASIN DETAIL

APPROVED
BY

DRAWN BY A.S.
DESIGNED BY W.W.L.
CHECKED BY W.W.L.
DATE 1-20-1956
SCALE AS SHOWN

GEORGE S. NOLTE
CIVIL ENGINEER LAND SURVEYOR
PALO ALTO SANTA CLARA WALNUT CREEK

IMPROVEMENT PLANS OF
EASY STREET EXTENSION
STANDARD DETAILS, CITY OF MOUNTAIN VIEW, CALIFORNIA

6

MICROFILMED FEE 65
CONTRACT PLAN

FILE No. 2634-S