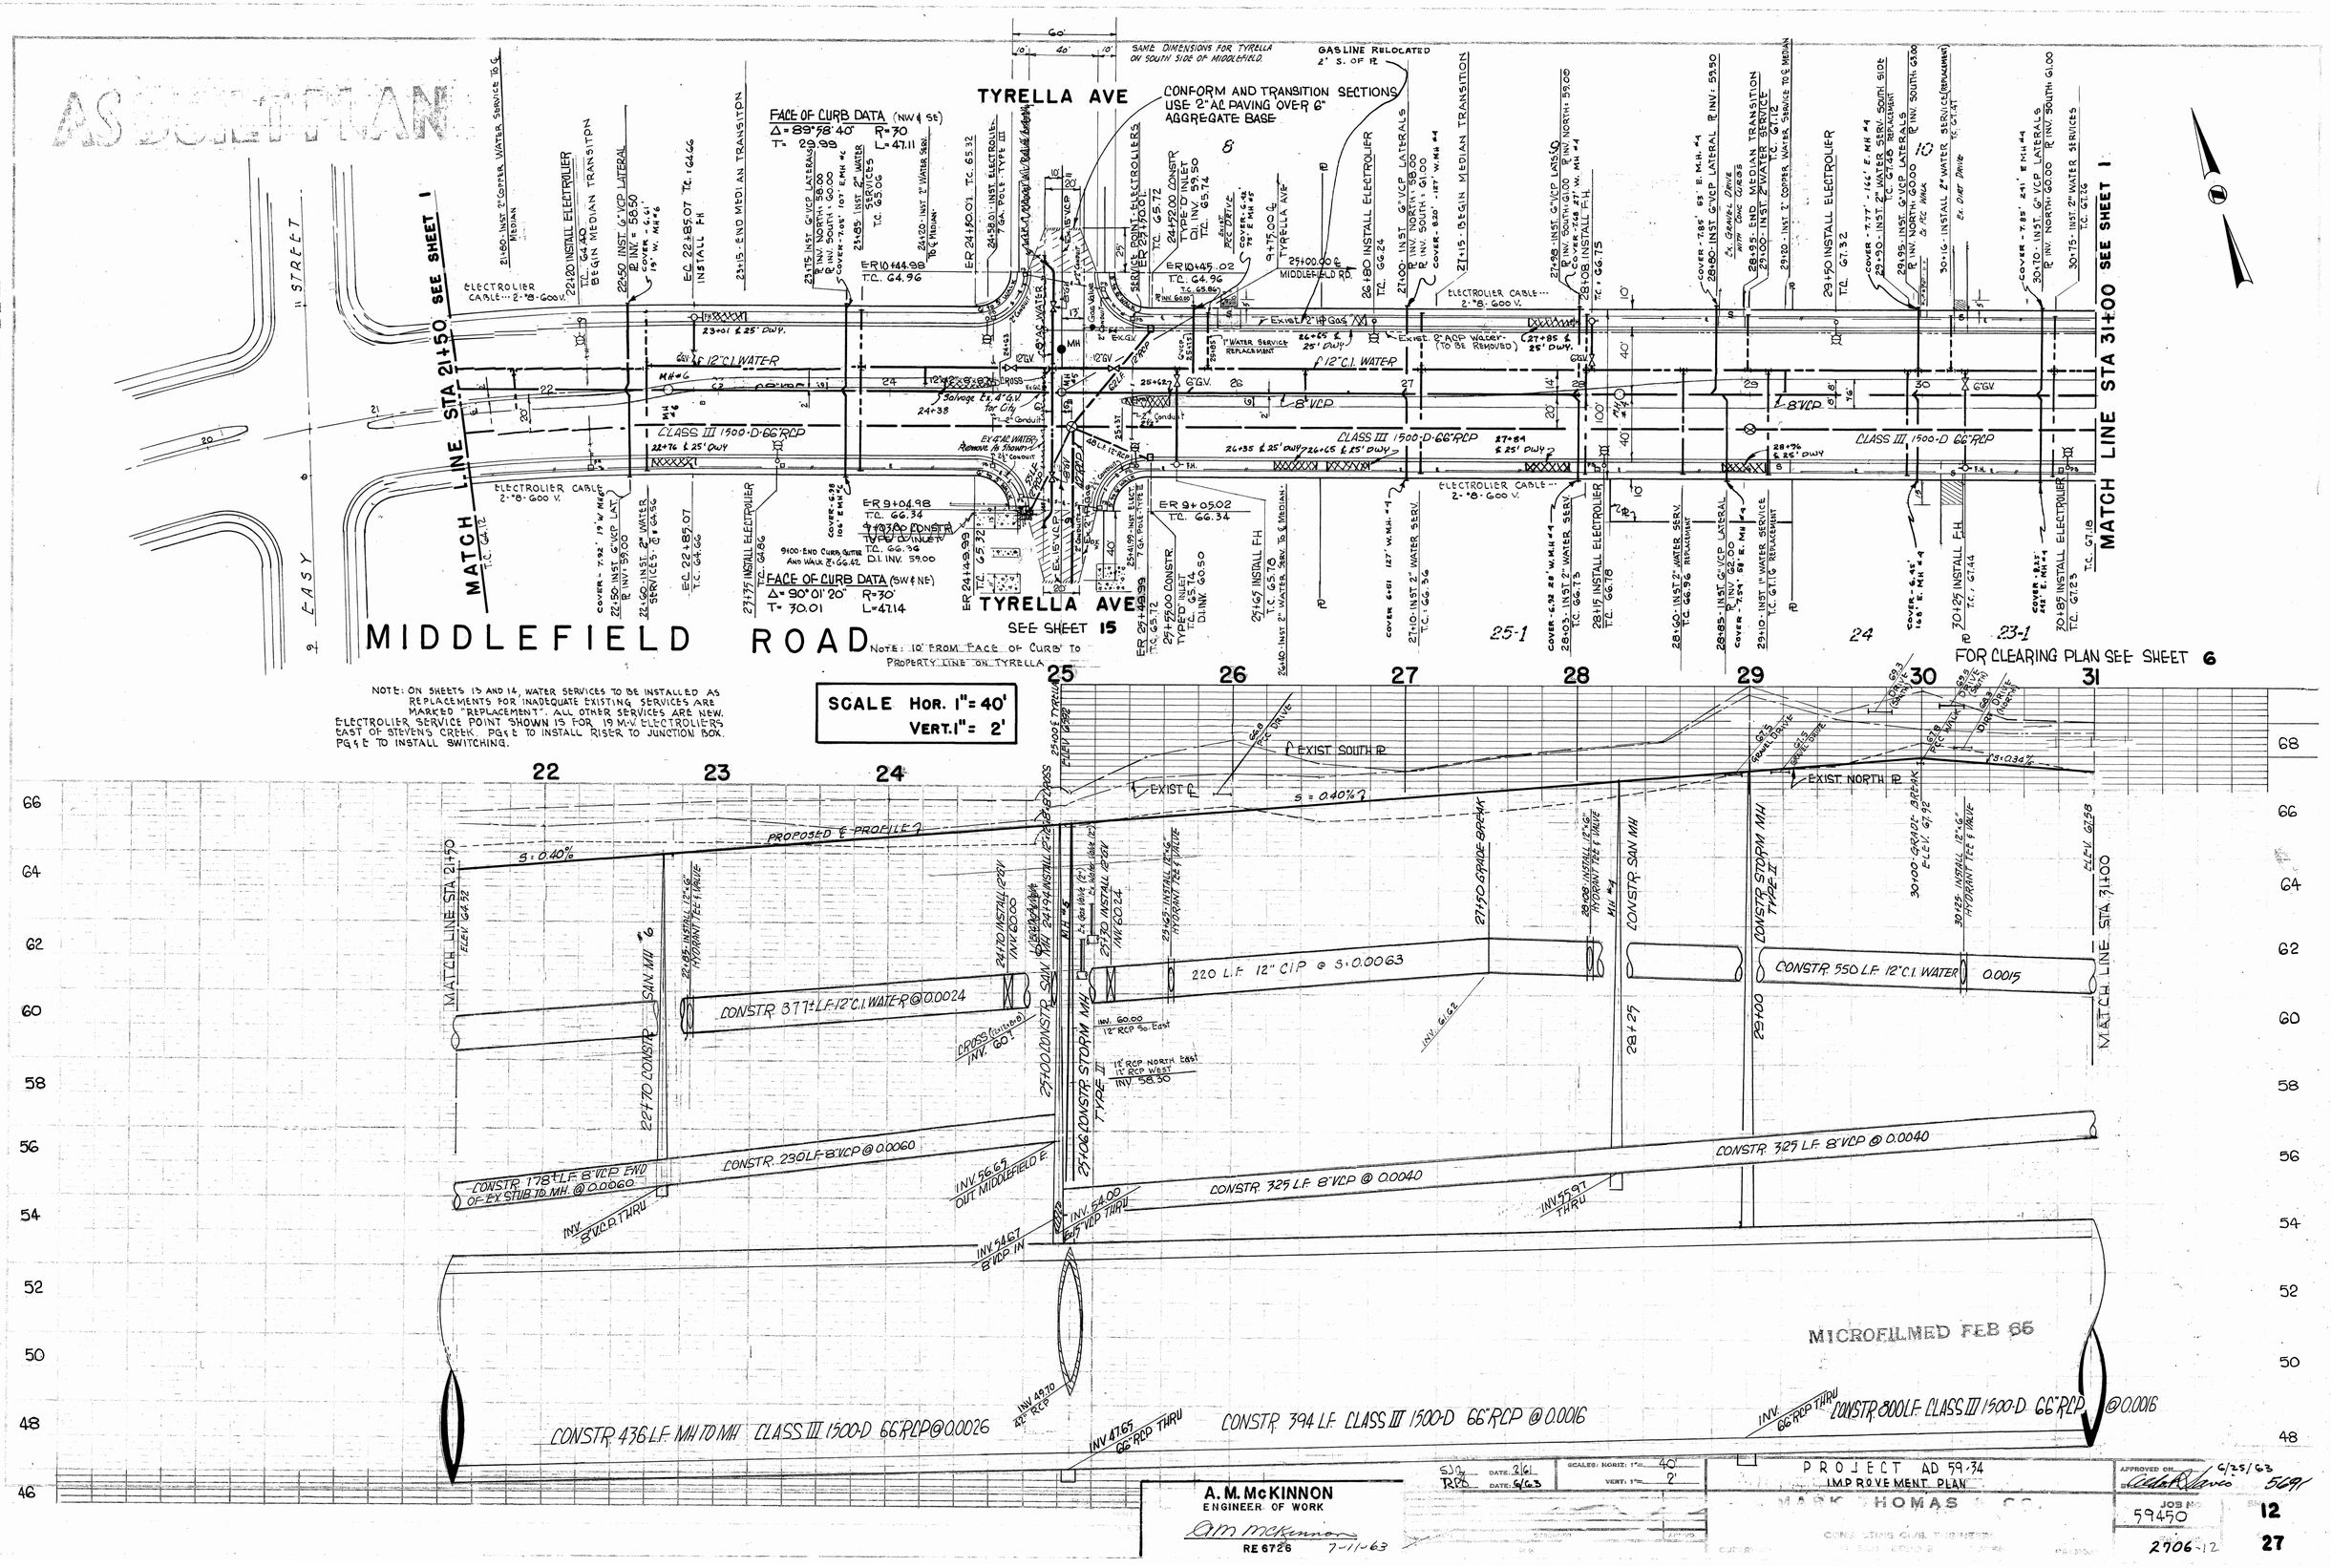
AS BUILT PLAN
TYRELLA AVE
MIDDLEFIELD ROAD
EASY STREET
MATCH LINE STA 21+50 SEE SHEET 1
MATCH LINE STA 31+00 SEE SHEET 1
FACE OF CURB DATA (NW & SE)
Δ = 89°58'40" R = 70
T = 29.99 L = 47.11
FACE OF CURB DATA (SW & NE)
Δ = 90°01'20" R = 30'
T = 30.01 L = 47.14
SAME DIMENSIONS FOR TYRELLA ON SOUTH SIDE OF MIDDLEFIELD.
GAS LINE RELOCATED 2' S. OF ℄
CONFORM AND TRANSITION SECTIONS USE 2" AC PAVING OVER 6" AGGREGATE BASE
SEE SHEET 15
NOTE: 10' FROM FACE OF CURB TO PROPERTY LINE ON TYRELLA
FOR CLEARING PLAN SEE SHEET 6
NOTE: ON SHEETS 13 AND 14, WATER SERVICES TO BE INSTALLED AS REPLACEMENTS FOR INADEQUATE EXISTING SERVICES ARE MARKED "REPLACEMENT". ALL OTHER SERVICES ARE NEW. ELECTROLIER SERVICE POINT SHOWN IS FOR 19 M.V. ELECTROLIERS. EAST OF STEVENS CREEK. PG&E TO INSTALL RISER TO JUNCTION BOX. PG&E TO INSTALL SWITCHING.
SCALE HOR. 1" = 40'
VERT. 1" = 2'
PROPOSED ℄ PROFILE
EXIST. SOUTH ℄
EXIST. NORTH ℄
EXIST. ℄
S = 0.40%
MATCH LINE STA 21+50
MATCH LINE STA 31+00
CONSTR. 377± L.F. 12" C.I. WATER @ 0.0024
CONSTR. 178± L.F. 8" VCP END OF EX. STUB TO MH. @ 0.0060
CONSTR. 230 L.F. 8" VCP @ 0.0060
CONSTR. 220 L.F. 12" CIP @ S = 0.0063
CONSTR. 550 L.F. 12" C.I. WATER 0.0015
CONSTR. 325 L.F. 8" VCP @ 0.0040
CONSTR. 436 L.F. MH TO MH CLASS III 1500-D 66" RCP @ 0.0026
CONSTR. 394 L.F. CLASS III 1500-D 66" RCP @ 0.0016
CONSTR. 800 L.F. CLASS III 1500-D 66" RCP @ 0.0016
MICROFILMED FEB 85
A. M. McKINNON
ENGINEER OF WORK
RE 6726
7-11-63
PROJECT AD 59-34
IMPROVEMENT PLAN
MARK HOMAS & CO.
APPROVED ON 6/25/63
JOB NO. 59450
2906-12
12
27

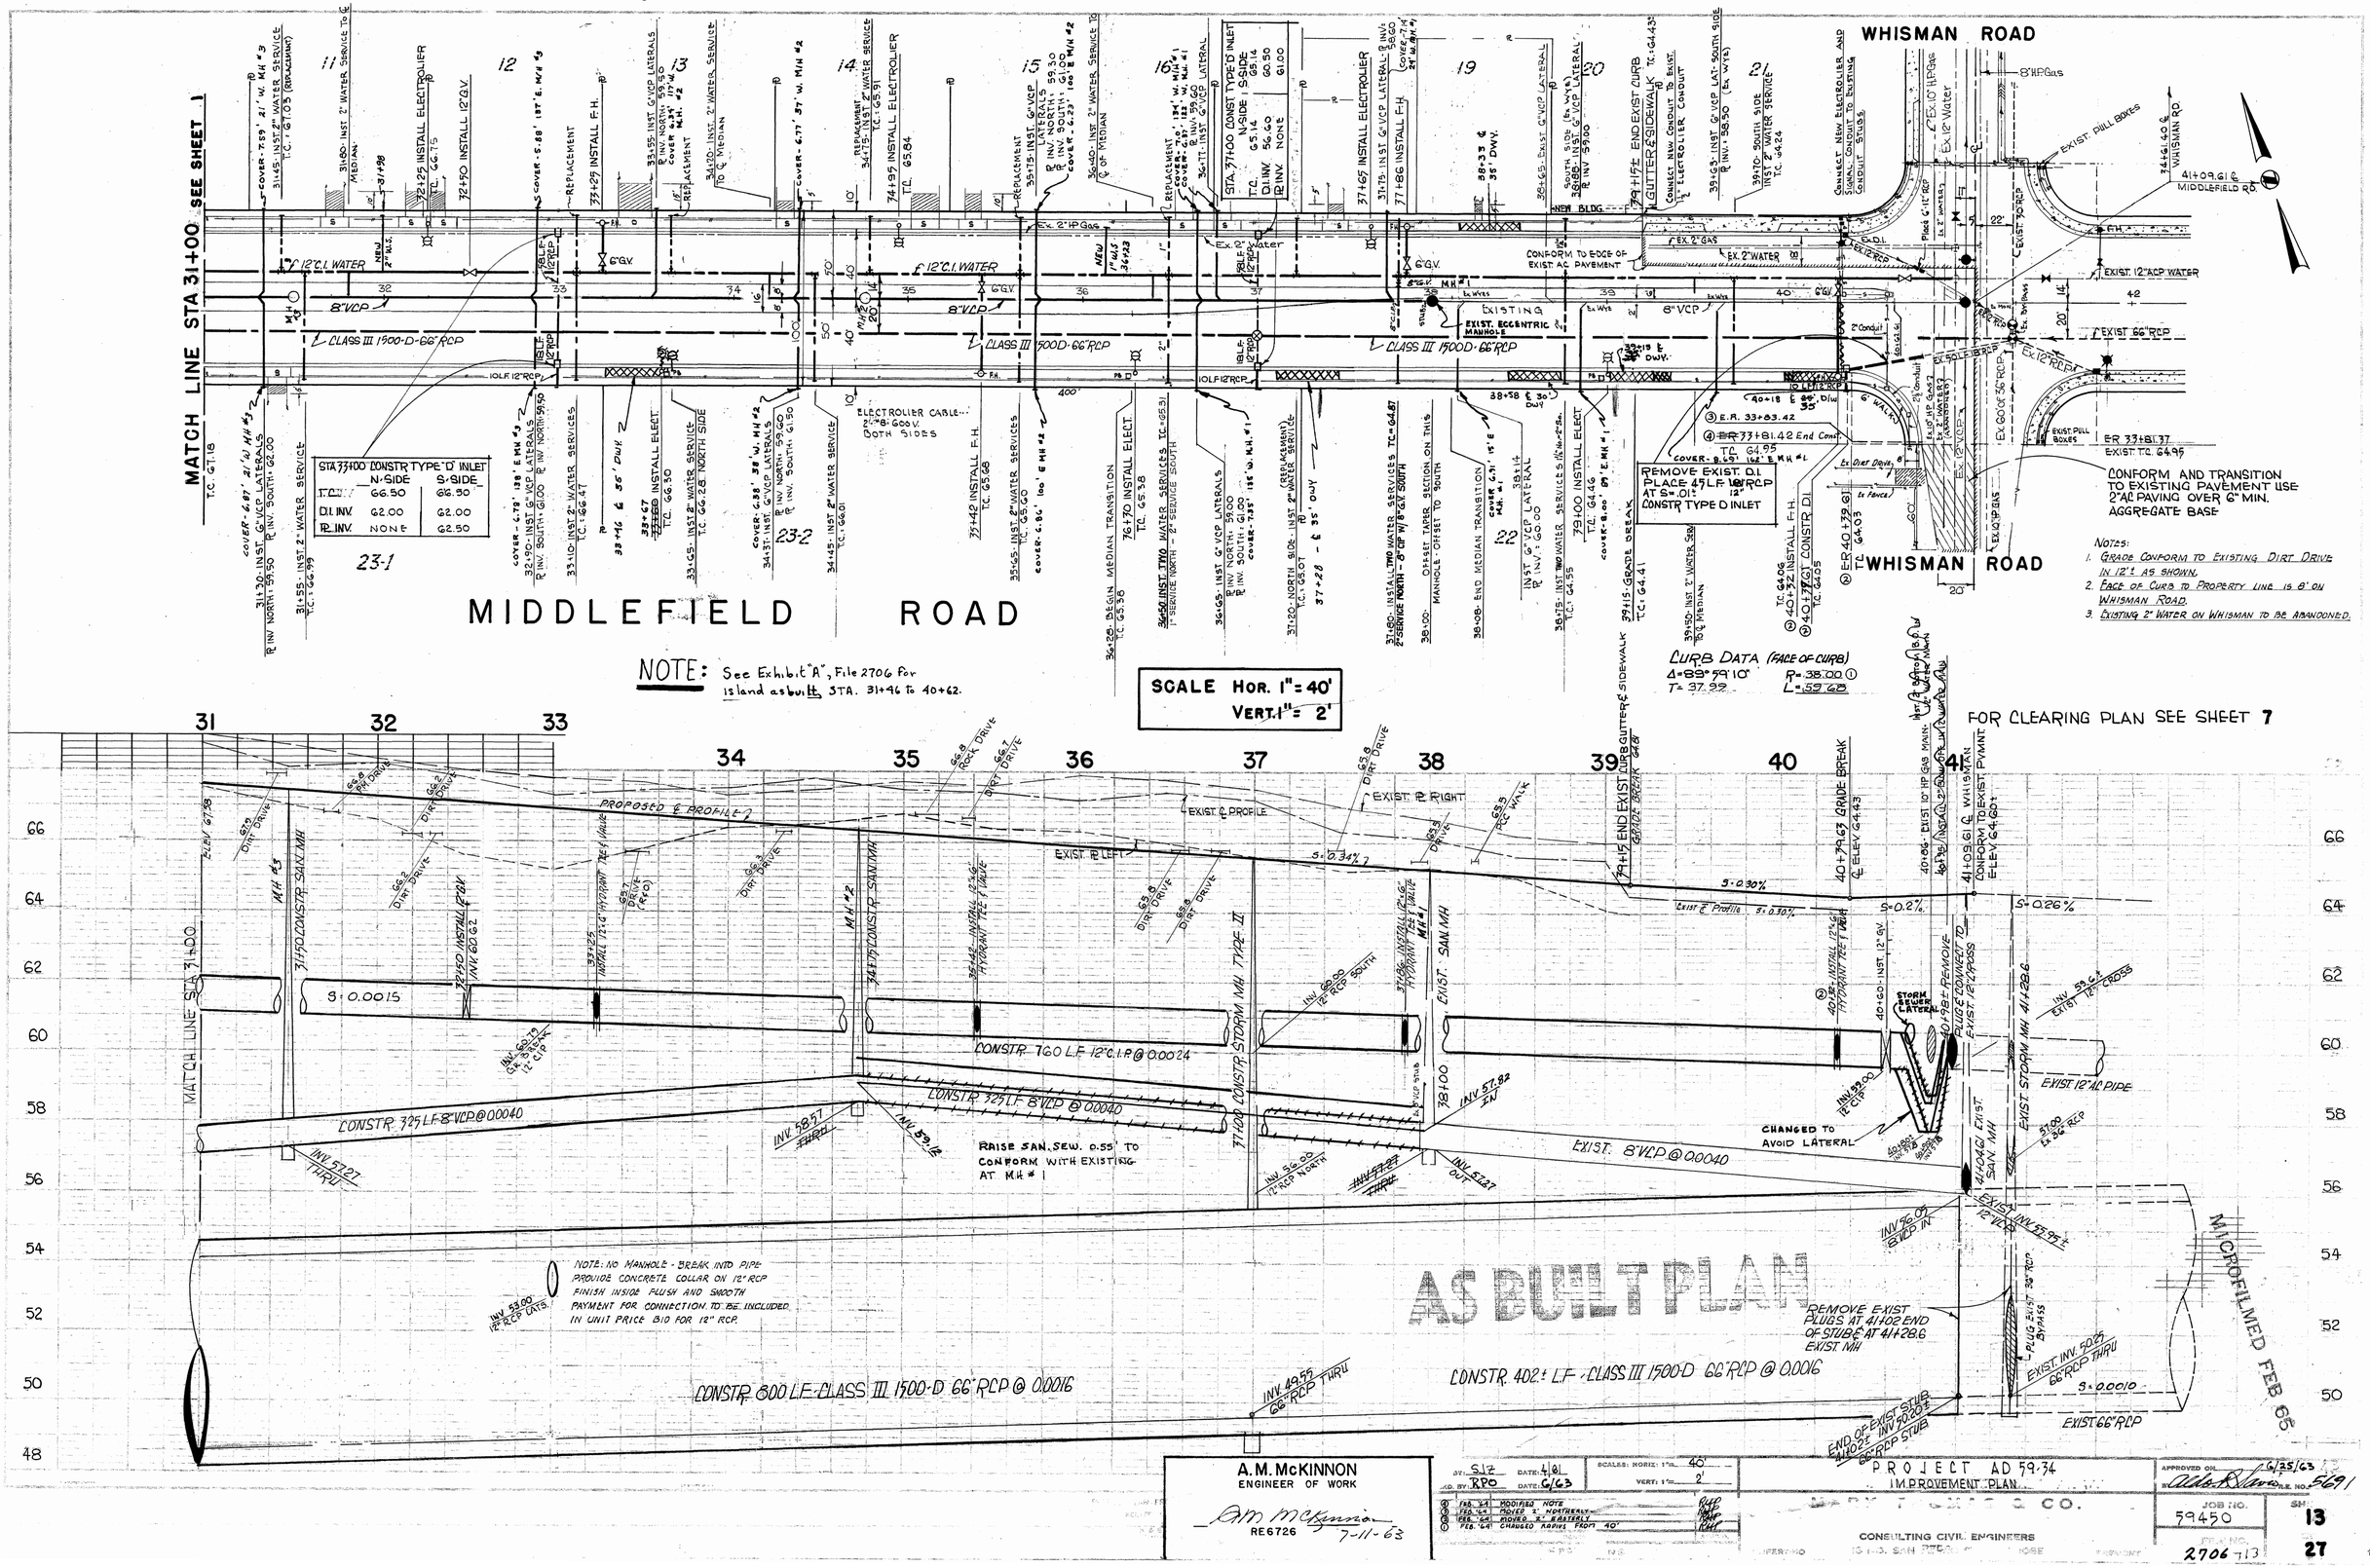

A.M. McKINNON
ENGINEER OF WORK
RE6726 7-11-63

PROJECT AD 59-34
IMPROVEMENT PLAN

CONSULTING CIVIL ENGINEERS

JOB NO. 59450

SHEET 13 OF 27

2706-13