SEMS-RM DOCID # 1164931

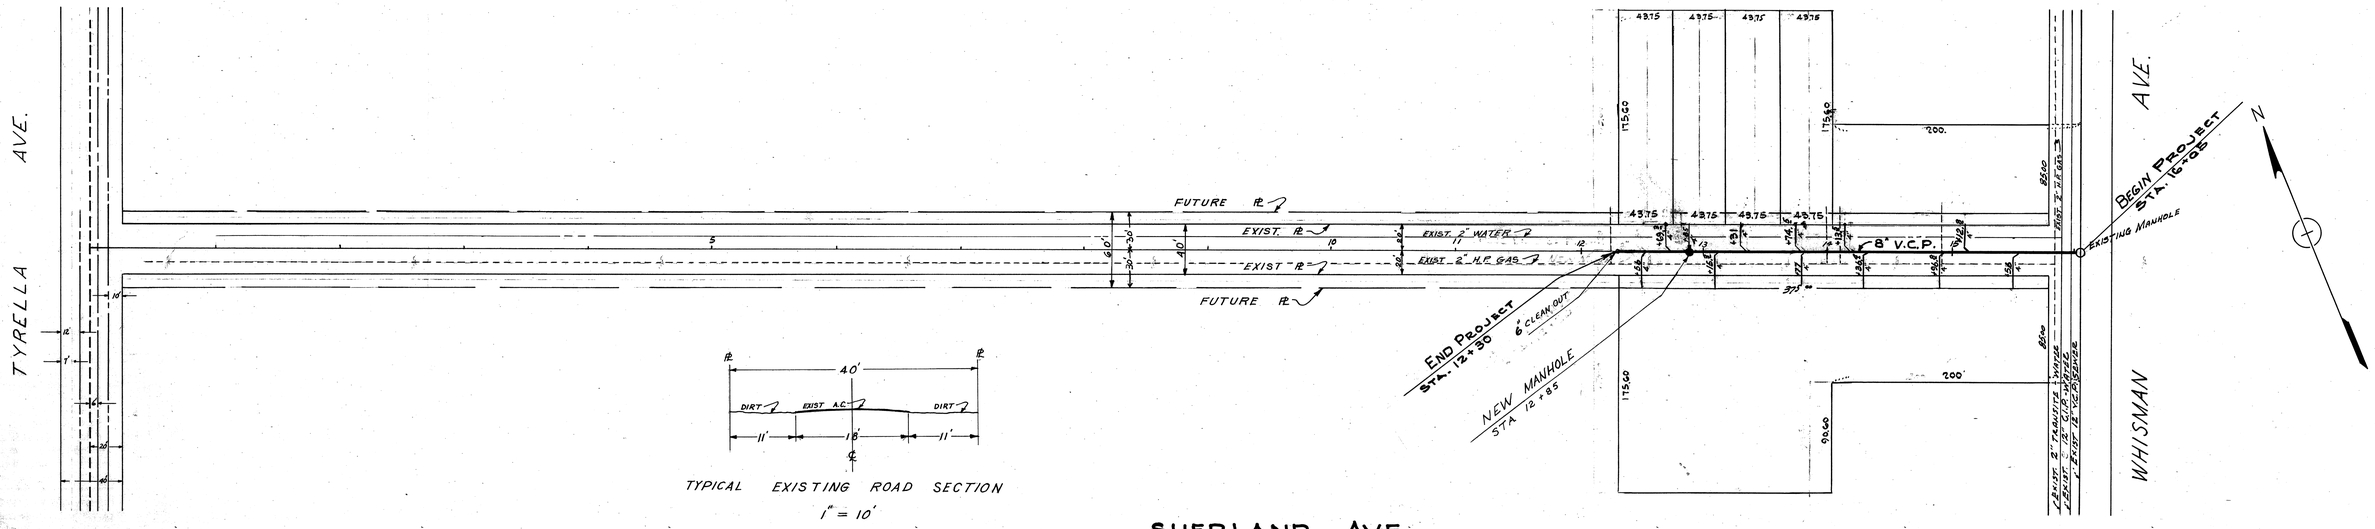

LEGEND:
NEW MANHOLE
LATERAL (4")

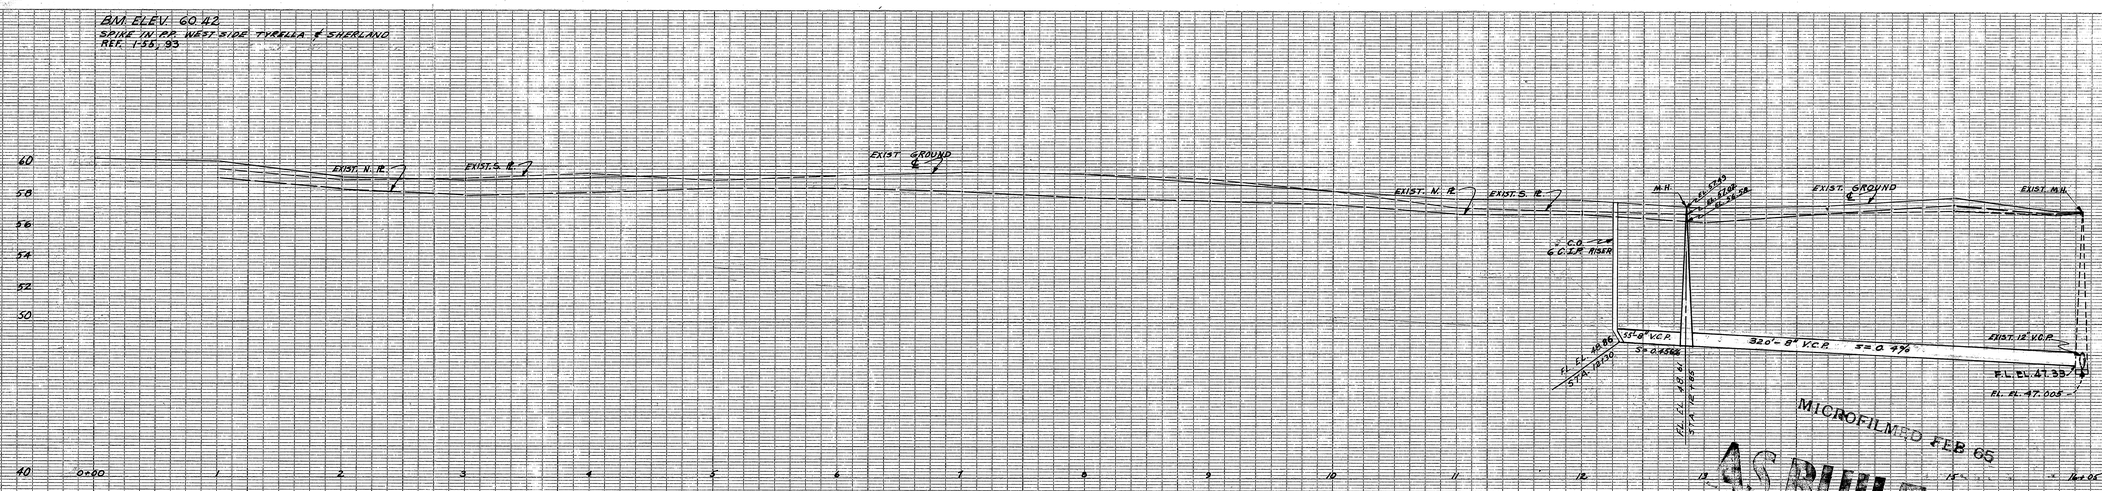

B.M. ELEV. 60.295 TOP OF F.H. SW. COR. WHISMAN & SHERLAND
ELEV. 57.155 N. RIM SAN. M.H. WHISMAN & SHERLAND
ELEV. 47.005 INVERT SAN. M.H. " " "

GENERAL NOTE:

1. ALL WORK SHALL CONFORM TO THE STANDARD SPECIFICATIONS OF THE CITY OF MOUNTAIN VIEW.
2. ENGINEERING AND INSPECTION BY THE CITY OF MOUNTAIN VIEW ENGINEERING DEPARTMENT.
3. CONTRACTOR TO BE RESPONSIBLE FOR VERIFYING, LOCATING AND PRESERVING ALL UTILITIES.
4. INSTALL LATERALS WHERE SHOWN ON PLAN.
5. MANHOLE - IF PRE-CAST, USE 3-6" CONCRETE RINGS ABOVE CONE TO PERMIT FUTURE LOWERING.
6. RESURFACE TRENCH WITH 10" UNTREATED CRUSHED ROCK BASE AND 2" PLANT MIX A.C. SURFACING.
7. SETTLE BACKFILL IN TRENCH BY JETTING.
8. RESURFACE TRENCHES FOR LATERALS WITHIN PAVED AREA OF STREET WITH 10" UNTREATED ROCK BASE & 2" PLANT MIX SURFACING. RESURFACE TRENCHES FOR LATERALS OUTSIDE PAVED AREA OF STREET TO SAME STANDARD AS EXISTING STREET. PAYMENT FOR RESURFACING OF TRENCHES FOR LATERALS IS TO BE INCLUDED IN THE UNIT COST FOR LATERALS.
9. ALL LATERALS SHALL EXTEND FROM SEWER 30' TO FUTURE P/L

MICROFILMED FEB 65

AS BUILT PLAN

AS BUILT PLAN
DATE: 3-7-62 BY: C.E.O.
CHKD 8-8-61 BY AKERS

CITY OF MOUNTAIN VIEW, CALIFORNIA

SANITARY SEWER

SHERLAND AVENUE
WHISMAN TO 375 FT. WEST
STA. 12+30 TO STA. 16+05

ENGINEERING DIVISION
DEPARTMENT OF PUBLIC WORKS

DRAWN: OLR DATE: 5-27-60	APPROVED:
CHECKED:	A.M. MAC KINNON
SCALE: HOR. 1 IN. = 50 FT. VERT. 1 IN. = 4 FT.	DIRECTOR OF PUBLIC WORKS
SHEET 1 OF 1 SHEETS	DATE: RCE 6726

FILE NO. 1277-1