POOR LEGIBILITY

ONE OR MORE PAGES IN THIS DOCUMENT ARE DIFFICULT TO READ
DUE TO THE QUALITY OF THE ORIGINAL

SEMS-RM DOCID # 1164938

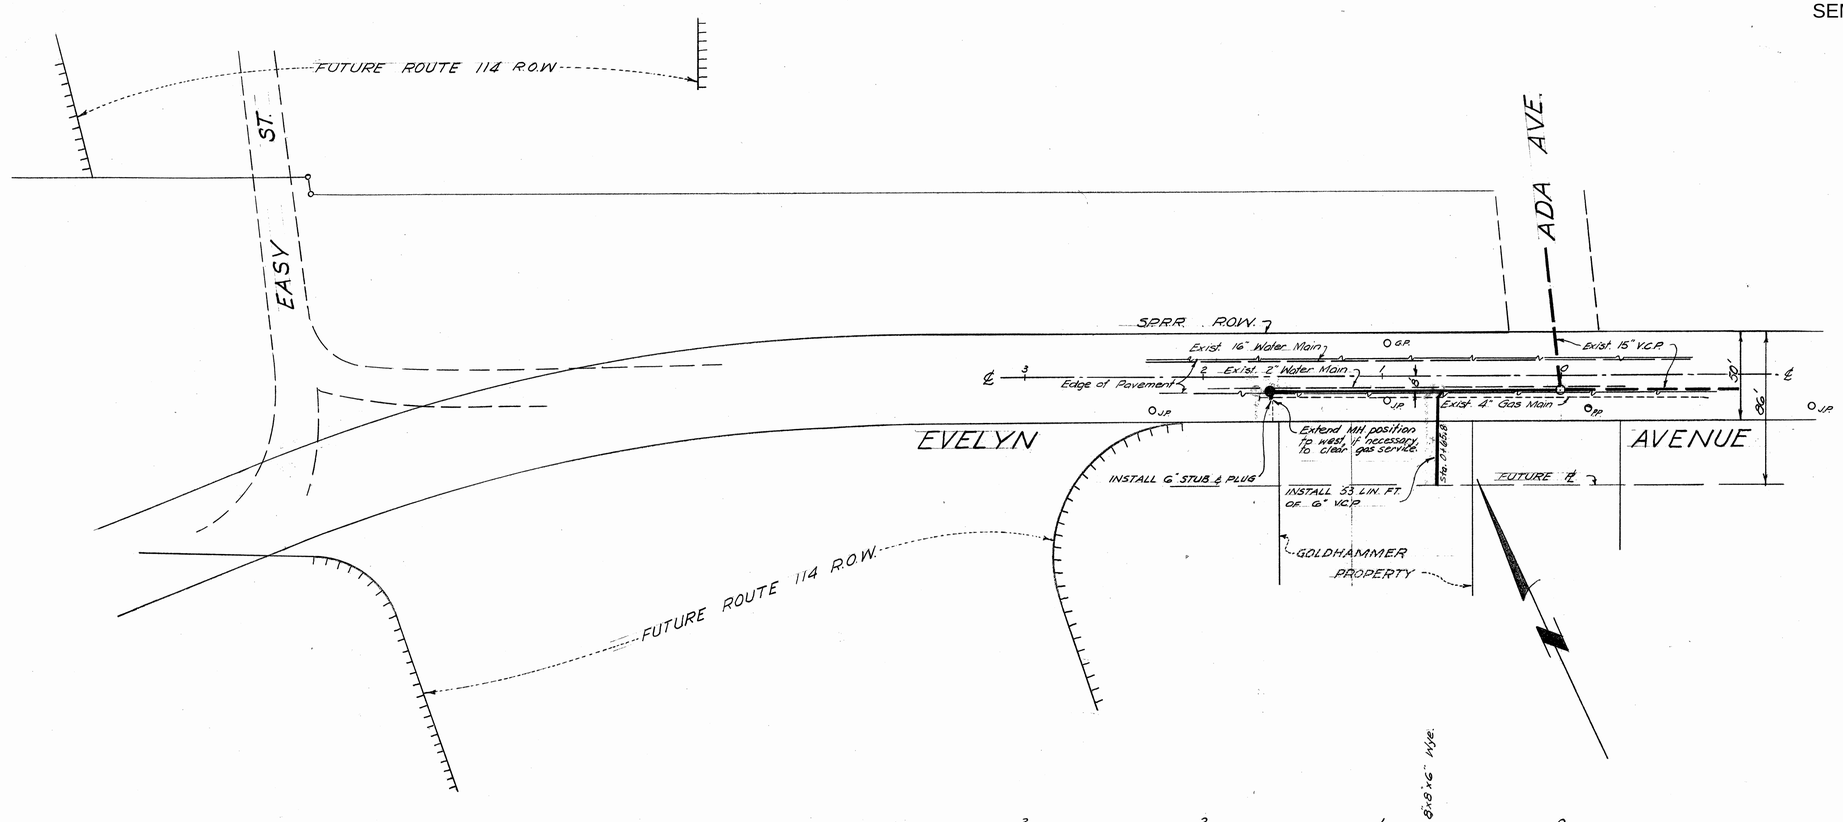

GENERAL NOTES:

1. All work and materials included in this contract shall be in accordance with the City of Mountain View, "Sanitary Sewer Installation - Detail Specification No. 31."
2. The Contractor shall not permit any water encountered in the excavation to flow into or be pumped into the sanitary sewer system.
3. Work shall be completed by not later than July 31st 1962.
4. The Contractor shall give the Engineer two working days notice before commencing work.
5. The Contractor shall keep the City Police and Fire Departments informed daily regarding barricades and detours.
6. The Contractor shall leave an emergency phone number with the City Fire Department and the City Police Department.
7. The Contractor shall furnish all barricades, lights, signs and flagmen necessary to control traffic and protect the public.
8. Flare pots shall be placed at excavations, barricades and as directed by the Engineer.
9. On completion of work the Contractor shall remove all equipment, material and debris from the project and in general clean up the project to the satisfaction of the Engineer.
10. The Contractor shall notify Pacific Gas and Electric Co., and Pacific Telephone and Telegraph Co. prior to excavating near any of their facilities.
11. Grade staking and inspection will be done by the City of Mountain View.

BENCH MARK:
City of Mountain View No. IV-27 (1961)
Spike in power pole on S.E. corner of intersection of Evelyn Ave. and Whisman Rd.
ELEV. 97.429.

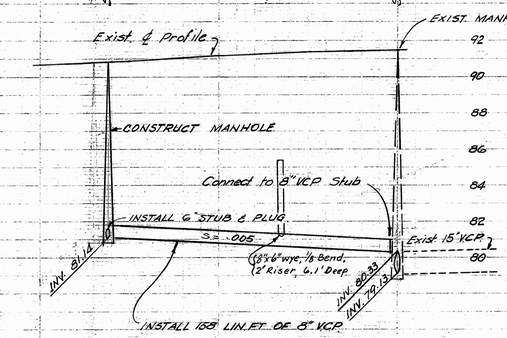

AS BUILT PLAN
DATE: 8-3-62 BY: Harman
DATE: 8-7-62 CHKD. BY Lamb

MICROFILMED JAN 65

CITY OF MOUNTAIN VIEW, CALIFORNIA
DEPARTMENT OF PUBLIC WORKS

PROJECT 62-19

EVELYN AVE. SEWER MAIN EXTENSION
(WEST OF ADA AVE.)

SCALE: HORIZ: 1"=40' VERT: 1"=4'	DATE: JUNE '62	SHEET 1 OF 2
DES. ANDERSON	APPROVED: Blaine L. Lamb, ASSIST. DIRECTOR OF PUBLIC WORKS	FIELD NOTES
DR. ANDERSON		
CK. Standell	6-20-62 DATE	17901 R.C.E.
CK.		FILE NO. 1371-1

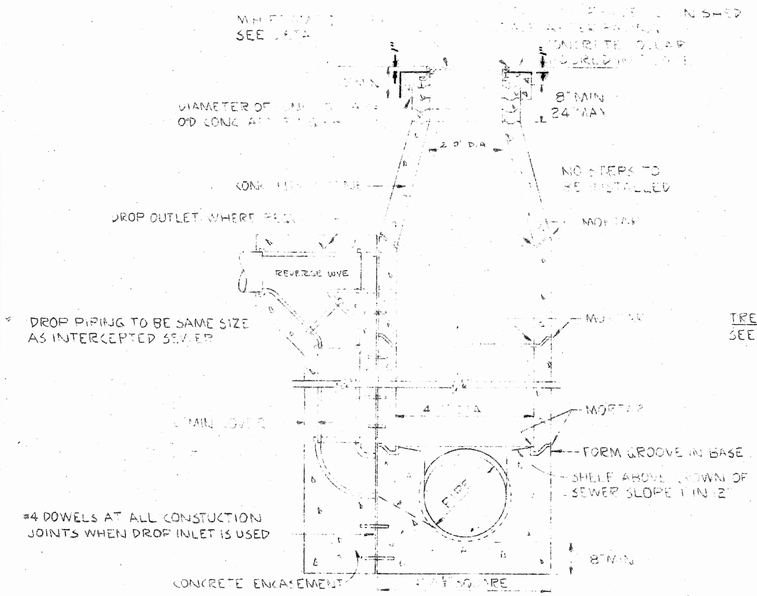

STANDARD MANHOLE

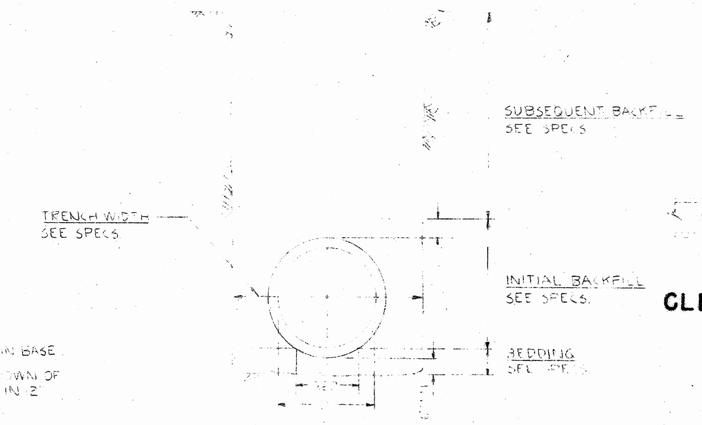

TRENCH BACKFILL

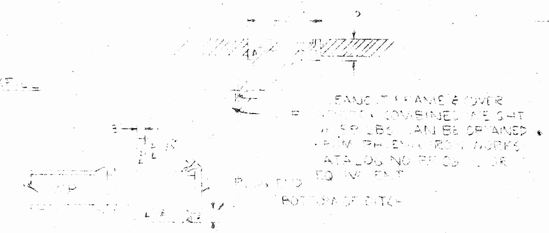

CLEANOUT DETAIL

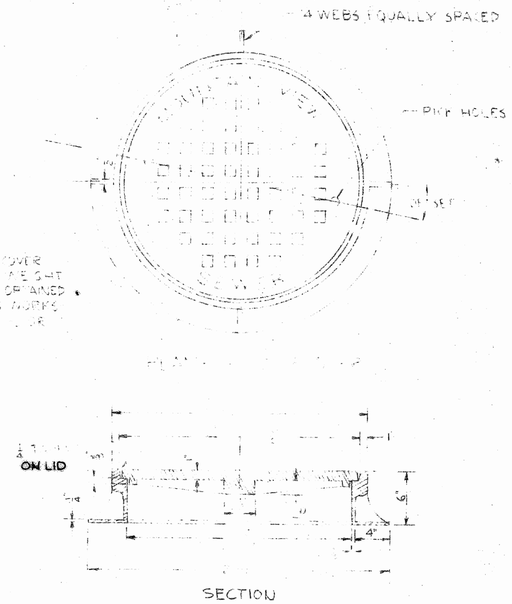

MANHOLE FRAME & COVER DETAIL

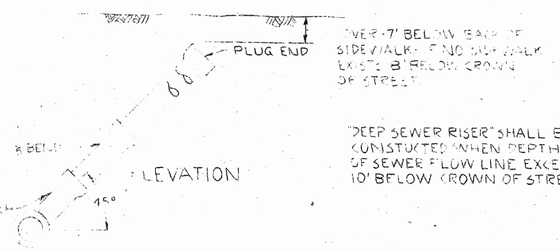

6" VCP DEEP SEWER RISER

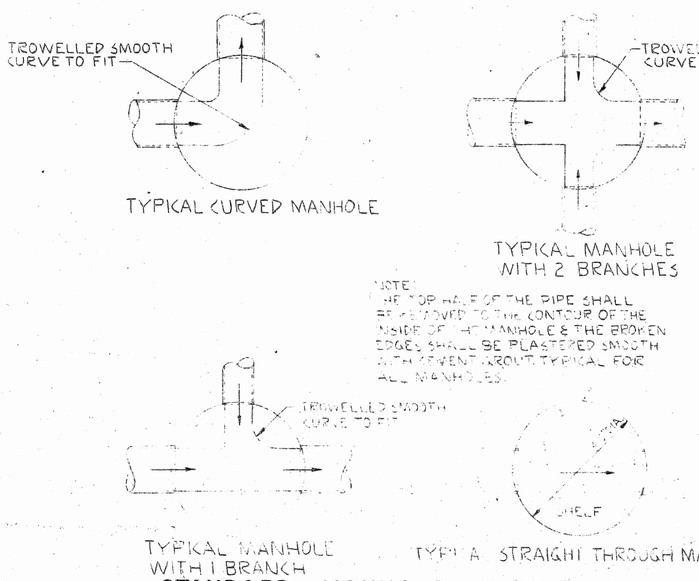

TYPICAL CURVED MANHOLE

TYPICAL MANHOLE WITH 2 BRANCHES

NOTE: THE TOP HALF OF THE PIPE SHALL BE REMOVED TO THE CONTOUR OF THE INSIDE OF THE MANHOLE & THE BROKEN EDGES SHALL BE PLASTERED SMOOTH WITH CEMENT GROUT. TYPICAL FOR ALL MANHOLES.

TYPICAL MANHOLE WITH 1 BRANCH

TYPICAL STRAIGHT THROUGH MANHOLE

STANDARD MANHOLE SECTIONS

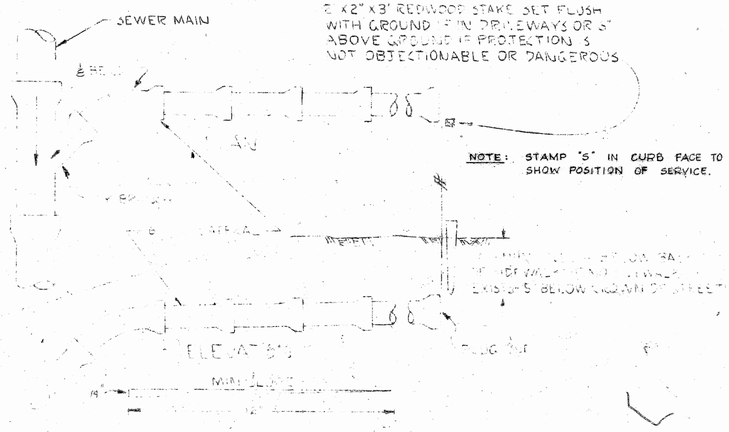

SEWER SERVICE DETAIL

PROJECT 62-19

EVELYN AVE SEWER MAIN EXTENSION (WEST OF ADA AVE.)

MICROFILMED JAN 65

3	ADDED NOTE: "STAMP 'S' IN ....SERVICE" REMOVED "BACK OF SIDEWALK"	3-26-62	AHA	
2	[illegible] ORIGINAL	2/[illegible]/61	M.L.F.	W.E.S.
	[illegible] DEEP SEWER RISER	[illegible]	B.M.H.	W.E.S.
	REVISION	DATE	DRW	CK

CITY OF MOUNTAIN VIEW, CALIFORNIA
DEPARTMENT OF PUBLIC WORKS

STANDARD SEWER DETAILS

SCALE: NONE | DATE: FEB 6, 1961 | SHEET 2 OF 2

DES. YOUNG
DR.
CK.
CK.

APPROVED: Blaine L. Davison, ASST. DIRECTOR OF PUBLIC WORKS
2-8-61 DATE
1701 R.C.E. NO.

FIELD NOTES

FILE NO. 1371-2

Speed #9