SEMS-RM DOCID # 1164950

GENERAL NOTES

1. All work shall be done in accordance with the Detail Specifications and Standard Details of the City of Mountain View and/or State of California Standard Specifications, dated July 1964.
2. Contractors shall keep the City Police and Fire Departments informed daily regarding excavations, barricades and detours in roadway areas. Plate pots shall be placed at excavations, barricades, and as directed by the Engineer.
3. Contractors shall notify the Director of Public Works at least two working days prior to commencing work.
4. The Contractors shall leave an emergency telephone number with the above mentioned agencies.
5. The Contractor shall give 24 hour notice to the City's Water Division foreman when making connections to existing water facilities. At all times the manipulation of existing valves shall be done under the direction of Water Division personnel.
6. All underground utilities to be completed before placing of base rock unless otherwise noted.
7. Concrete Contractor shall verify location of Driveways, sewer laterals and water services before pouring curbs and shall mark face of curbs with a letter "S" for sewer laterals and a letter "W" for water service. Use one-half (½) pound lamp black per cubic yard of concrete.
8. Paving Contractor to reset manhole rims and valve boxes to grade after placing the base and immediately prior to the last lift of paving.
9. Contractor shall notify all utility companies at least two (2) working days prior to excavation in the vicinity of existing utility lines.

CONTRACTORS NOTES

1. All joint and power poles to be removed by others. It is the Contractors responsibility to contact the owners of such poles and, arrange for their removal or relocation.
2. Sewer laterals to be 4" ø diameter V.C.P. with cleanout.
3. △1 All electrolier lines to be 2-#8 wires inside of ½" galvanized conduit or P.V.C. located 6" inches inside back of walk. The voltage to serve the circuits is to be 240 volts. Electrolier poles to be 30' high Type I with 8' mast arms except at No. 0+85 on Evelyn Ave, (see note 7). Luminaires to be 400 Watt Mercury Vapor Lamps, Type III Distribution. Circuit shall be multiple-connected.
4. No sewer laterals or water services to be installed under driveways.
5. 24 hours notice shall be given to the office of Sandis and Associates, 812 Castro St, Mountain View, Phone 969-0127 for the request of construction stakes.
6. Before proceeding with any trenching the contractor shall expose the invert of the existing utility and shall notify the engineer (Sandis and Associates 969-0127) to verify its elevation and location before proceeding with any further excavation. Contractor shall notify the Engineer 24 hours in advance of the exposing of the inverts so proper arrangements may be made to have them verified.
7. △1 Pole is to be Type III without traffic signal mast arm and the rod. The crossarm and watertight socket shall be installed for future signal mast arm and the rod. Socket shall have temporary watertight plug. Traffic signal conduit shall extend 2" max. above finished surface of foundation and capped.
8. △1 Please location of foundation for type 1-C signal standard and No. 3½ pullbox will be marked in field by City Engineer when island has been staked. Traffic signal conduit to be capped 2" above foundation surface.
9. △1 Initial backfill shall be select backfill" place to a final depth of 12" above the top of C.I.P.

VICINITY MAP

NO SCALE

APPROVAL RECOMMENDED BY:

Bill Henry DATE 8/15/66

BENCH MARK

Bronze disk set in center of curb return southeast corner of Sylvan Ave. and Sevely Dr.
Elev. 115.973
(City of Mountain View Section II # 35, 1965 Datum)

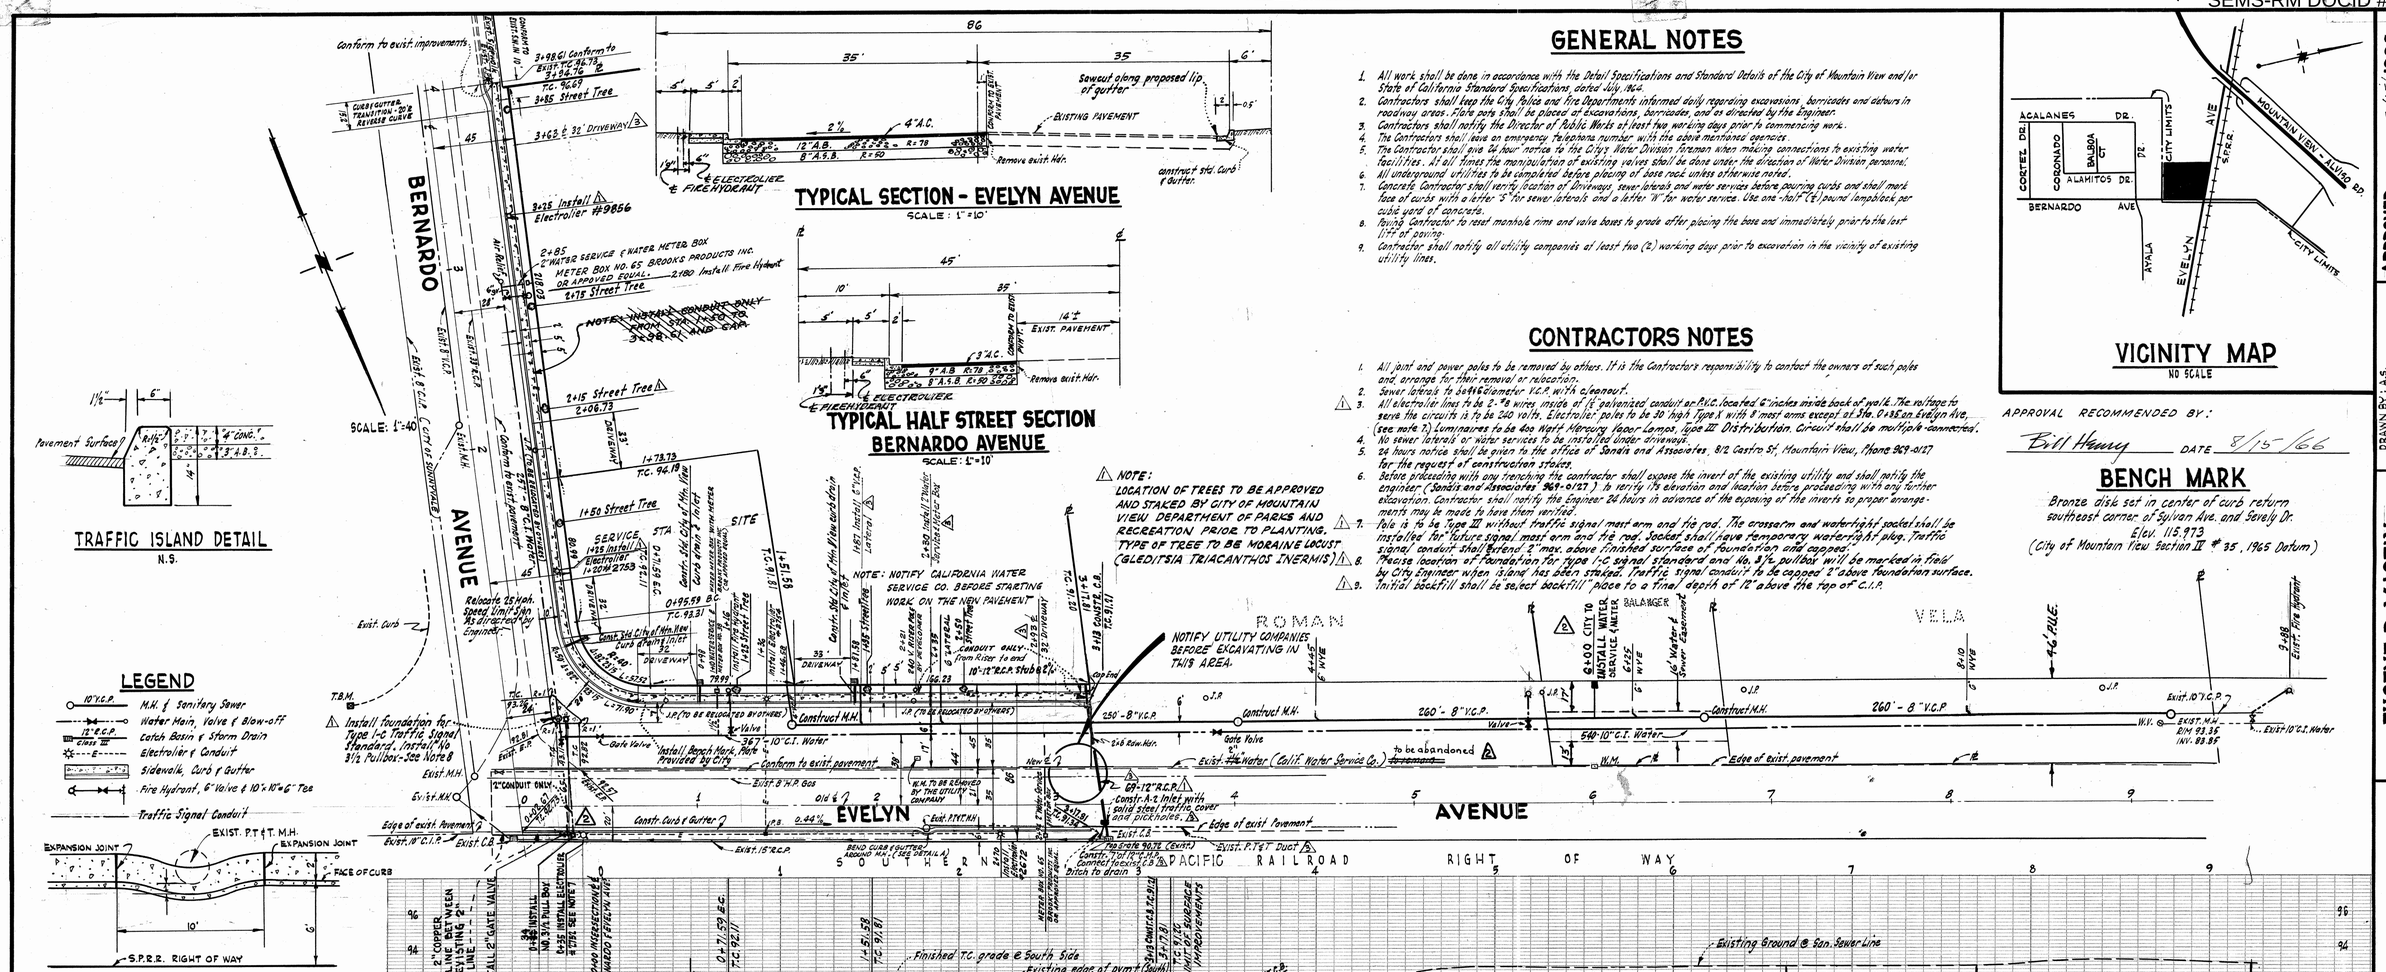

MICROFILMED OCT 70

△4 REVISIONS APPROVED BY: Allen Shelley 12-19-69 ASSISTANT DIRECTOR OF PUBLIC WORKS R.C.E. 16590 DATE

△4 REVISIONS: 12-18-1969 - RELOCATION OF DRIVEWAYS CONSTRUCT A-2 INLET - ADDED SEW. LAT. & WATER SERVICE CONSTRUCT 7' OF 12" CMP OVER EXIST. PT & T DUCT

△2 REVISIONS APPROVED BY: Allen Shelley 12-4-69 ASSISTANT DIRECTOR OF PUBLIC WORKS DATE

△2 REVISIONS: 12-1-69 INSTALL 12" CIP WITH 12" GATE VALVE INSTALL 2" MAIN BETWEEN 12" CIP & EXISTING 2" MAIN INSTALL 2" GATE VALVE IN METER BOX STATION 0+31 INSTALL 2" WATER SERVICE W/ 3/4" METER STATION 6+00

△1 REVISIONS APPROVED BY: Allen Shelley 8-6-69 ASSISTANT DIRECTOR OF PUBLIC WORKS R.C.E. 16590 DATE

△1 REVISIONS: 7-8-69 REVISED IN ACCORDANCE WITH CITY OF MOUNTAIN VIEW REQUIREMENTS, BY SANDIS & ASSOCIATES

APPROVED 3/15/1966 Eugene R. Mastin R.E. 6567

DRAWN BY: A.S.
DESIGNED BY:
CHECKED BY:
DATE:
SCALE:

EUGENE R. MASTIN
CIVIL ENGINEER
40 WOODHAMS ROAD SANTA CLARA, CALIF.
R.E. 6567
Eugene R. Mastin

IMPROVEMENT PLANS FOR BERNARDO AVENUE & EVELYN AVENUE

S.W. CORNER OF
CITY OF MOUNTAIN VIEW
CALIFORNIA

SHEET 1 OF 1 SHT.

FILE NO. 5231

JOB NO. 57-65