POOR LEGIBILITY

ONE OR MORE PAGES IN THIS DOCUMENT ARE DIFFICULT TO READ
DUE TO THE QUALITY OF THE ORIGINAL

SEMS-RM DOCID # 1164953

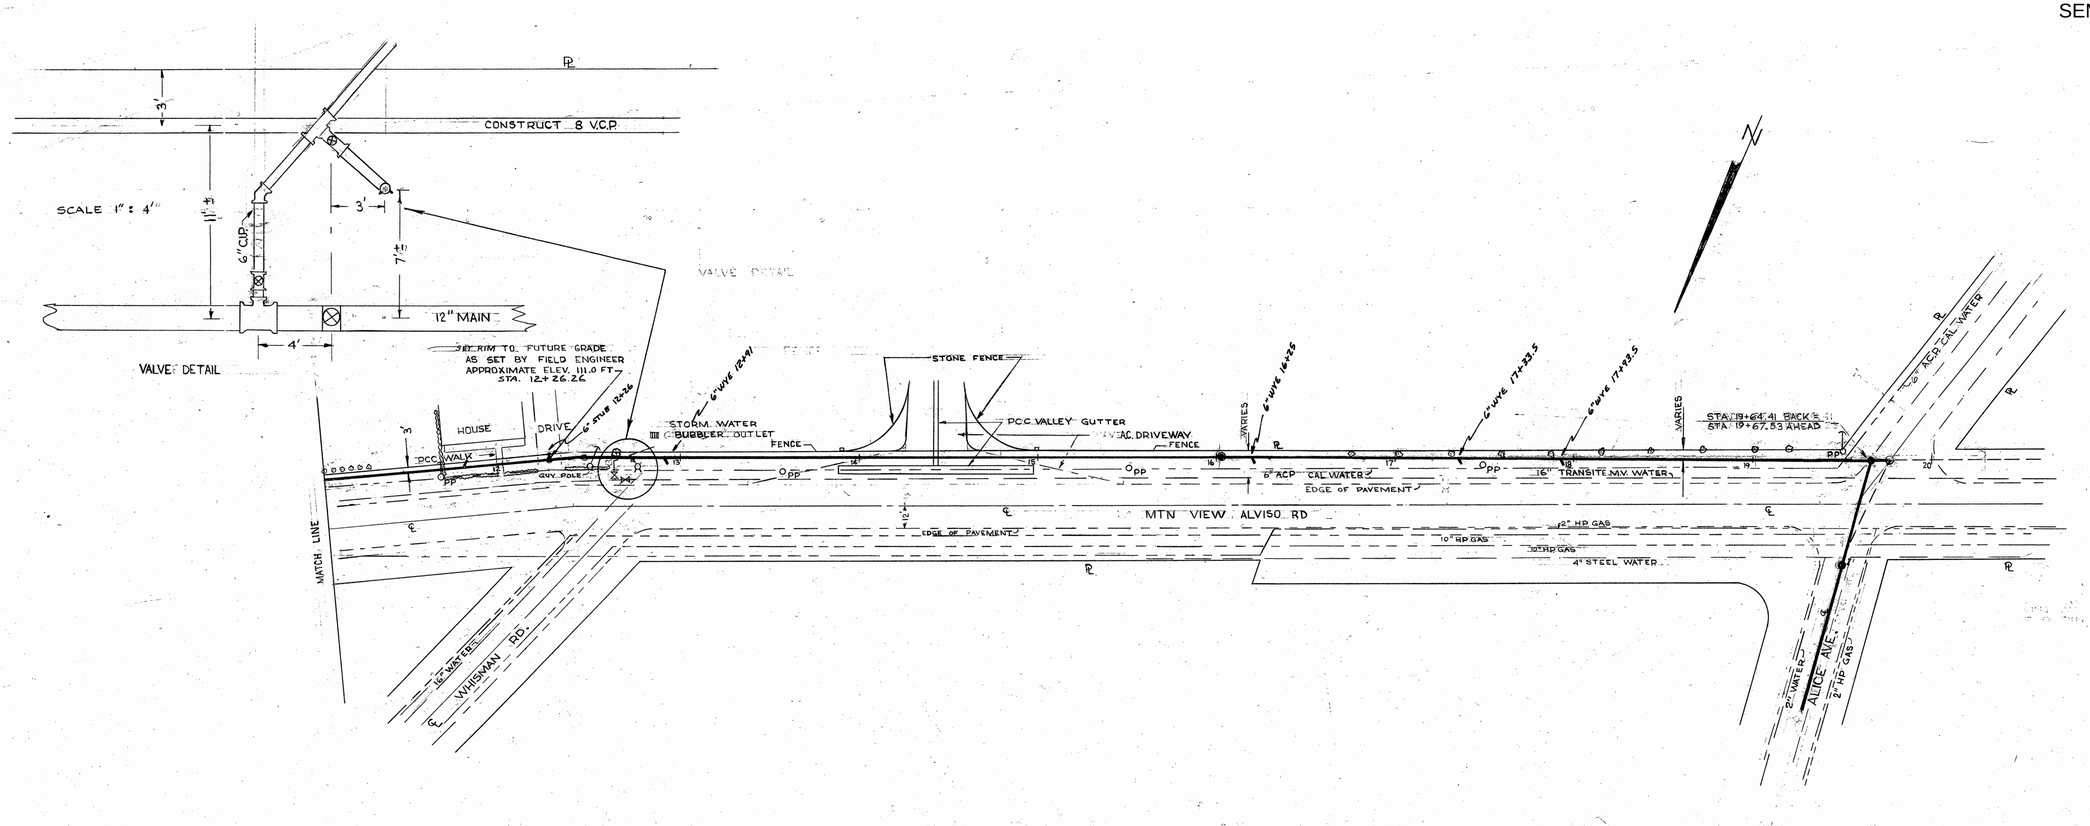

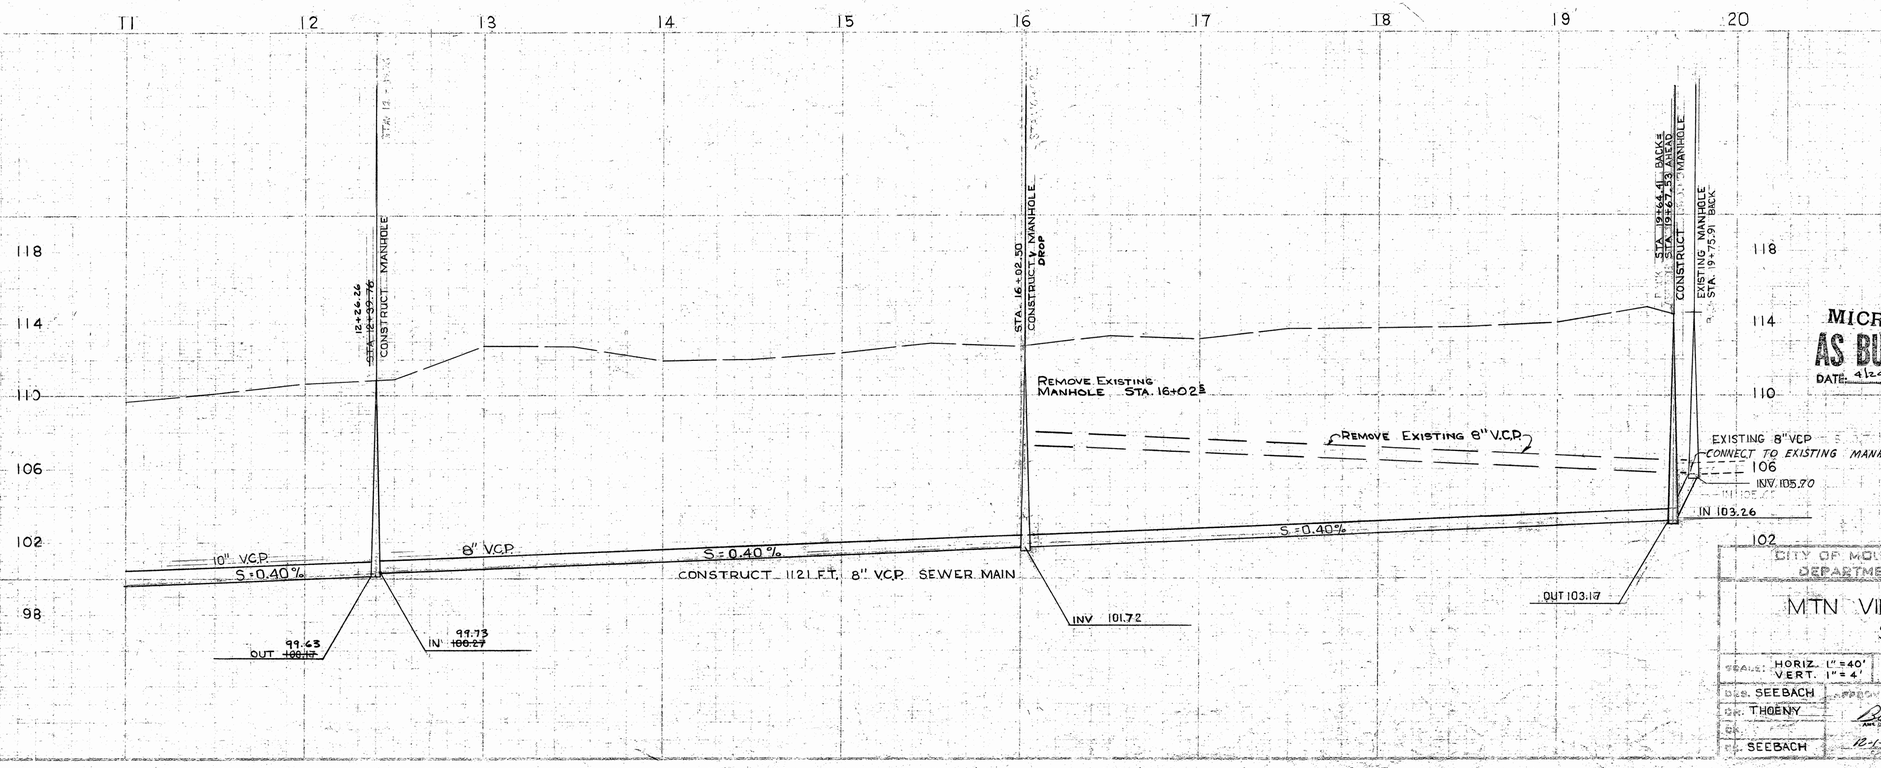

MICROFILMED JAN 65

AS BUILT PLAN

DATE: 4/24/62 BY: Lamb Thoeny

CITY OF MOUNTAIN VIEW, CALIFORNIA
DEPARTMENT OF PUBLIC WORKS

MTN VIEW ALVISO ROAD
SEWER MAIN

PROJECT 61-22

SCALE: HORIZ. 1" = 40' VERT. 1" = 4'	DATE: 10-19-61	SHEET 2 OF 4	
DES. SEEBACH	APPROVED:		FIELD NOTES 60-1
DR. THOENY	Blaine L. Hansen		
CK.			
CK. SEEBACH	12-1-61	11701	1366-2

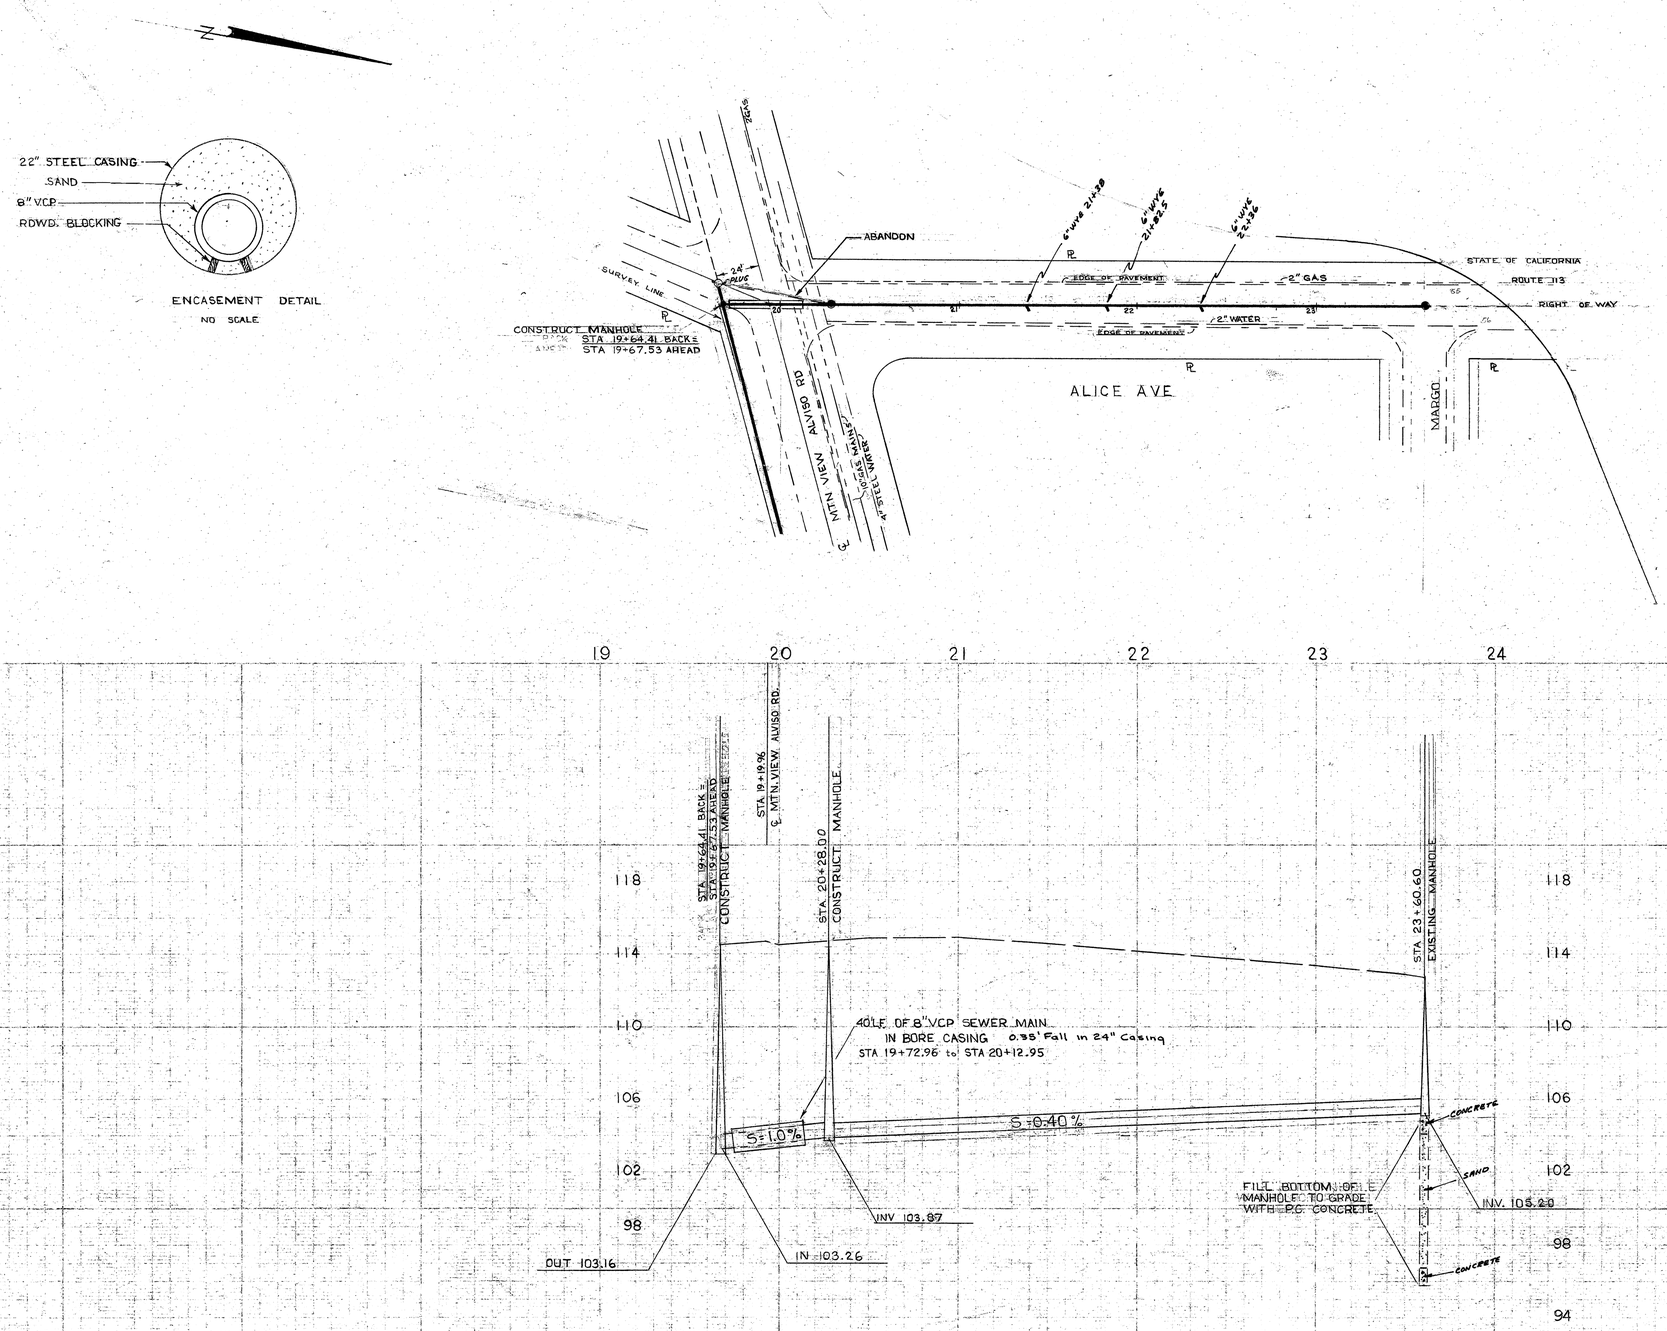

MICROFILMED JAN 65

AS BUILT PLAN

DATE: 4/24/62 BY: Thoeny / Lamb

CITY OF MOUNTAIN VIEW, CALIFORNIA
DEPARTMENT OF PUBLIC WORKS

MTN. VIEW ALVISO ROAD
SEWER MAIN

PROJECT 61-22

SCALE: HORIZ. 1" = 40' VERT. 1" = 4'	DATE: 10-19-61	SHEET 3 OF 4	
DES. SEEBACH	APPROVED: Blaine L. Harrison, DIRECTOR OF PUBLIC WORKS		FIELD NOTES: 60-11
DR. THOENY			
CK. SEEBACH	12-1-61	11701	FILE NO. 1366-3