SEMS-RM DOCID # 1165005

PRINTED IN U.S.A. ENGINEERING DIETZGEN CO

VERTICAL SCALE 1"=4'

EL CAMINO REAL

WILLIAMS WAY

GREENVIEW DRIVE

SHEET NO. 3

SHEET NO. 4

MATCH LINE

DALE AVENUE

SCALE 1"=40'

Caution Top of 2-4" Parallel PT&T Conduit Jacks Handy Crews before digging here.

Approx. location of exist. 8" Gas

Approx. location of exist. 8" Gas - 2

Exist. Sanitary Manhole - Rim 136.61 Invert 126.61 Exist. 8" VCP Sewer to South

Exist. 8" VCP Sewer to North

Exist. 8" VCP Sewer to East

Exist. 8" VCP Sewer to West

Exist. 8" MP Gas Line

Exist. Fire Hydrant

Proposed 36"x36"x24" Storm Manhole

Exist. 12" Water Line

Exist. 8" C.I. Water Line

Exist. 12" C.I. Water Line

Exist. Water Meter

Exist. Water Valve

Exist. Joint Trench

Exist. Fire Hydrant

Exist. Water Meter Box

Exist. Joint Trench

Exist. Water Valve

VERTICAL SCALE 1"= 4'

SCALE 1"=40'

WILLIAMS WAY

DALE AVE. — GOLF COURT — GREENVIEW DRIVE

SHEET NO. 2 — SHEET NO. 3 — SHEET NO. 4 — SHEET NO. 1

MATCH LINE

EXIST ℄

℄ & TC Grades -0.50%

℄ & TC Grades -0.60%

℄ & TC Grade -0.39%

4+99.89 ℄ Grade Break Fin. Gr. = 141.85

Lt. and Rt. T.C. Grades See Plan

Inv. Both Inlets = 136.15 ④

Const. Type "D" Inlet ④ Inv.=134.30 Grate=140.35

Const. ABS-F 15"RCP @ 2.0% Inv.=132.16




















Curve R=30 Δ=89°21'10" L=46.80

Curve R=30 Δ=90°37'50" L=47.46

Curve R=30 Δ=91°14'10" L=47.78

Note: No laterals or cleanouts located on lots #3 & #31.

AS BUILT PLAN

NO.	REVISION	BY	DATE	APRVD
③	Changed Inv Elev Type "D" Inlet from 134.30 to 134.15	RHP		
②	Changed San. Lateral on Lot 36 from 134.30 to 134.45	RHP	6-20-63	
①	Removed 1 Meter Box on Lots 24-35	RHP	6-20-63	

IMPROVEMENT PLANS

GOLF COURSE ESTATES

TRACT 2865

In the City of Mountain View, California

for

WILLIAMS BROTHERS

CONTRACTORS & BUILDERS

148 Mercy Street, Mountain View, California

LLOYD B. BAKER & ASSOCIATES

Consulting Civil Engineers

Land Surveyors

801 El Camino Real, Mountain View, California

Approved Lloyd B. Baker

Date 8 C.E. 1948

DEPARTMENT OF PUBLIC WORKS

CITY OF MOUNTAIN VIEW

Checked O.M. McKinnon

Approved

R.C.E. 6236 Date 6-24-63

SHEET 3 of 11

Williams Way

Golf Court

Dale Ave.

Greenview Drive

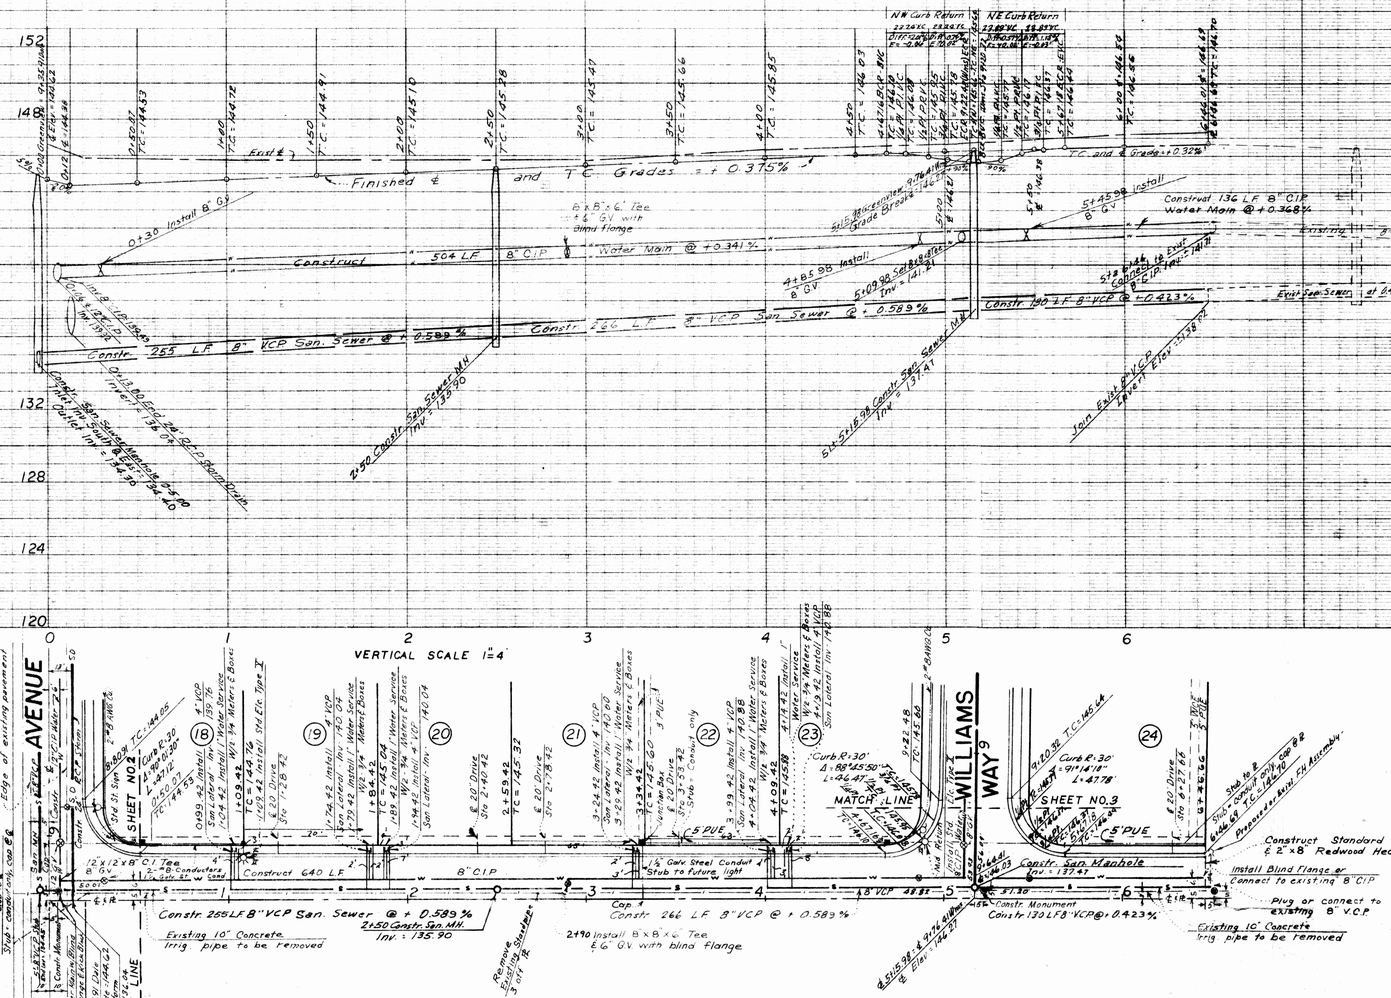

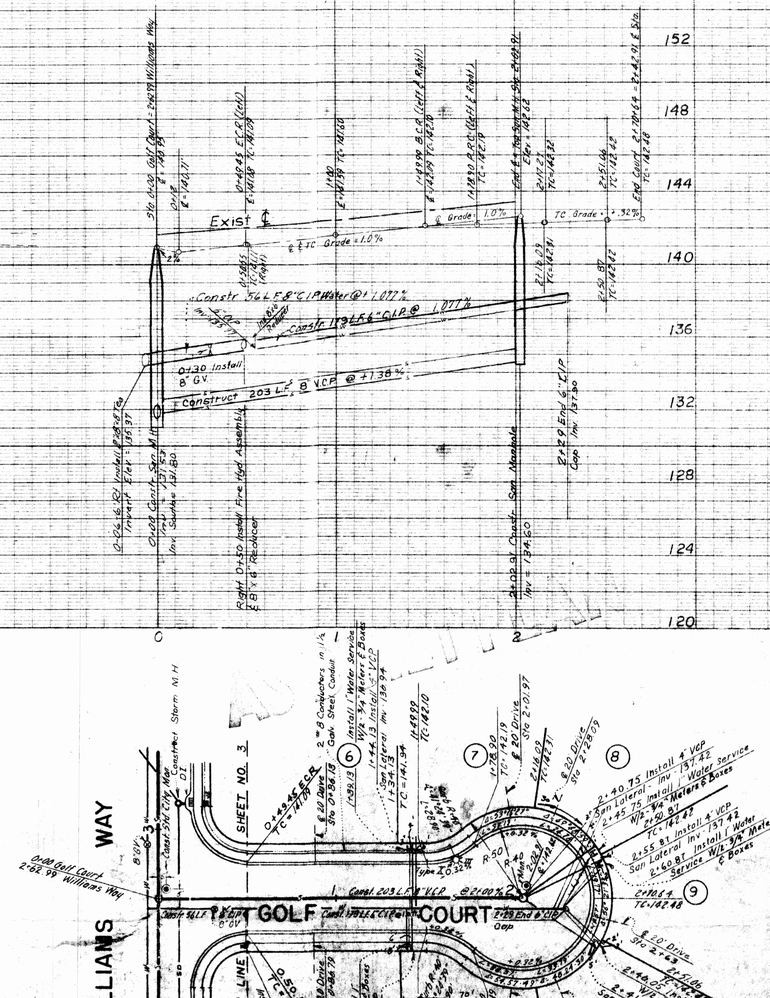

GREENVIEW DRIVE (EAST OF DALE) including Golf Ct.

IMPROVEMENT PLANS
GOLF COURSE ESTATES
TRACT 2865
In the City of Mountain View, California
-for-
WILLIAMS BROTHERS
CONTRACTORS & BUILDERS
148 Mercy Street, Mountain View, California

LLOYD B. BAKER & ASSOCIATES
Consulting Civil Engineers
Land Surveyors
80 El Camino Real, Mountain View, California
Approved Lloyd B. Baker
Date R.C.E. 1848

DEPARTMENT OF PUBLIC WORKS
CITY OF MOUNTAIN VIEW
Checked
SHEET

NO.	REVISION	BY	DATE	APPR'D