SEMS-RM DOCID # 1170107

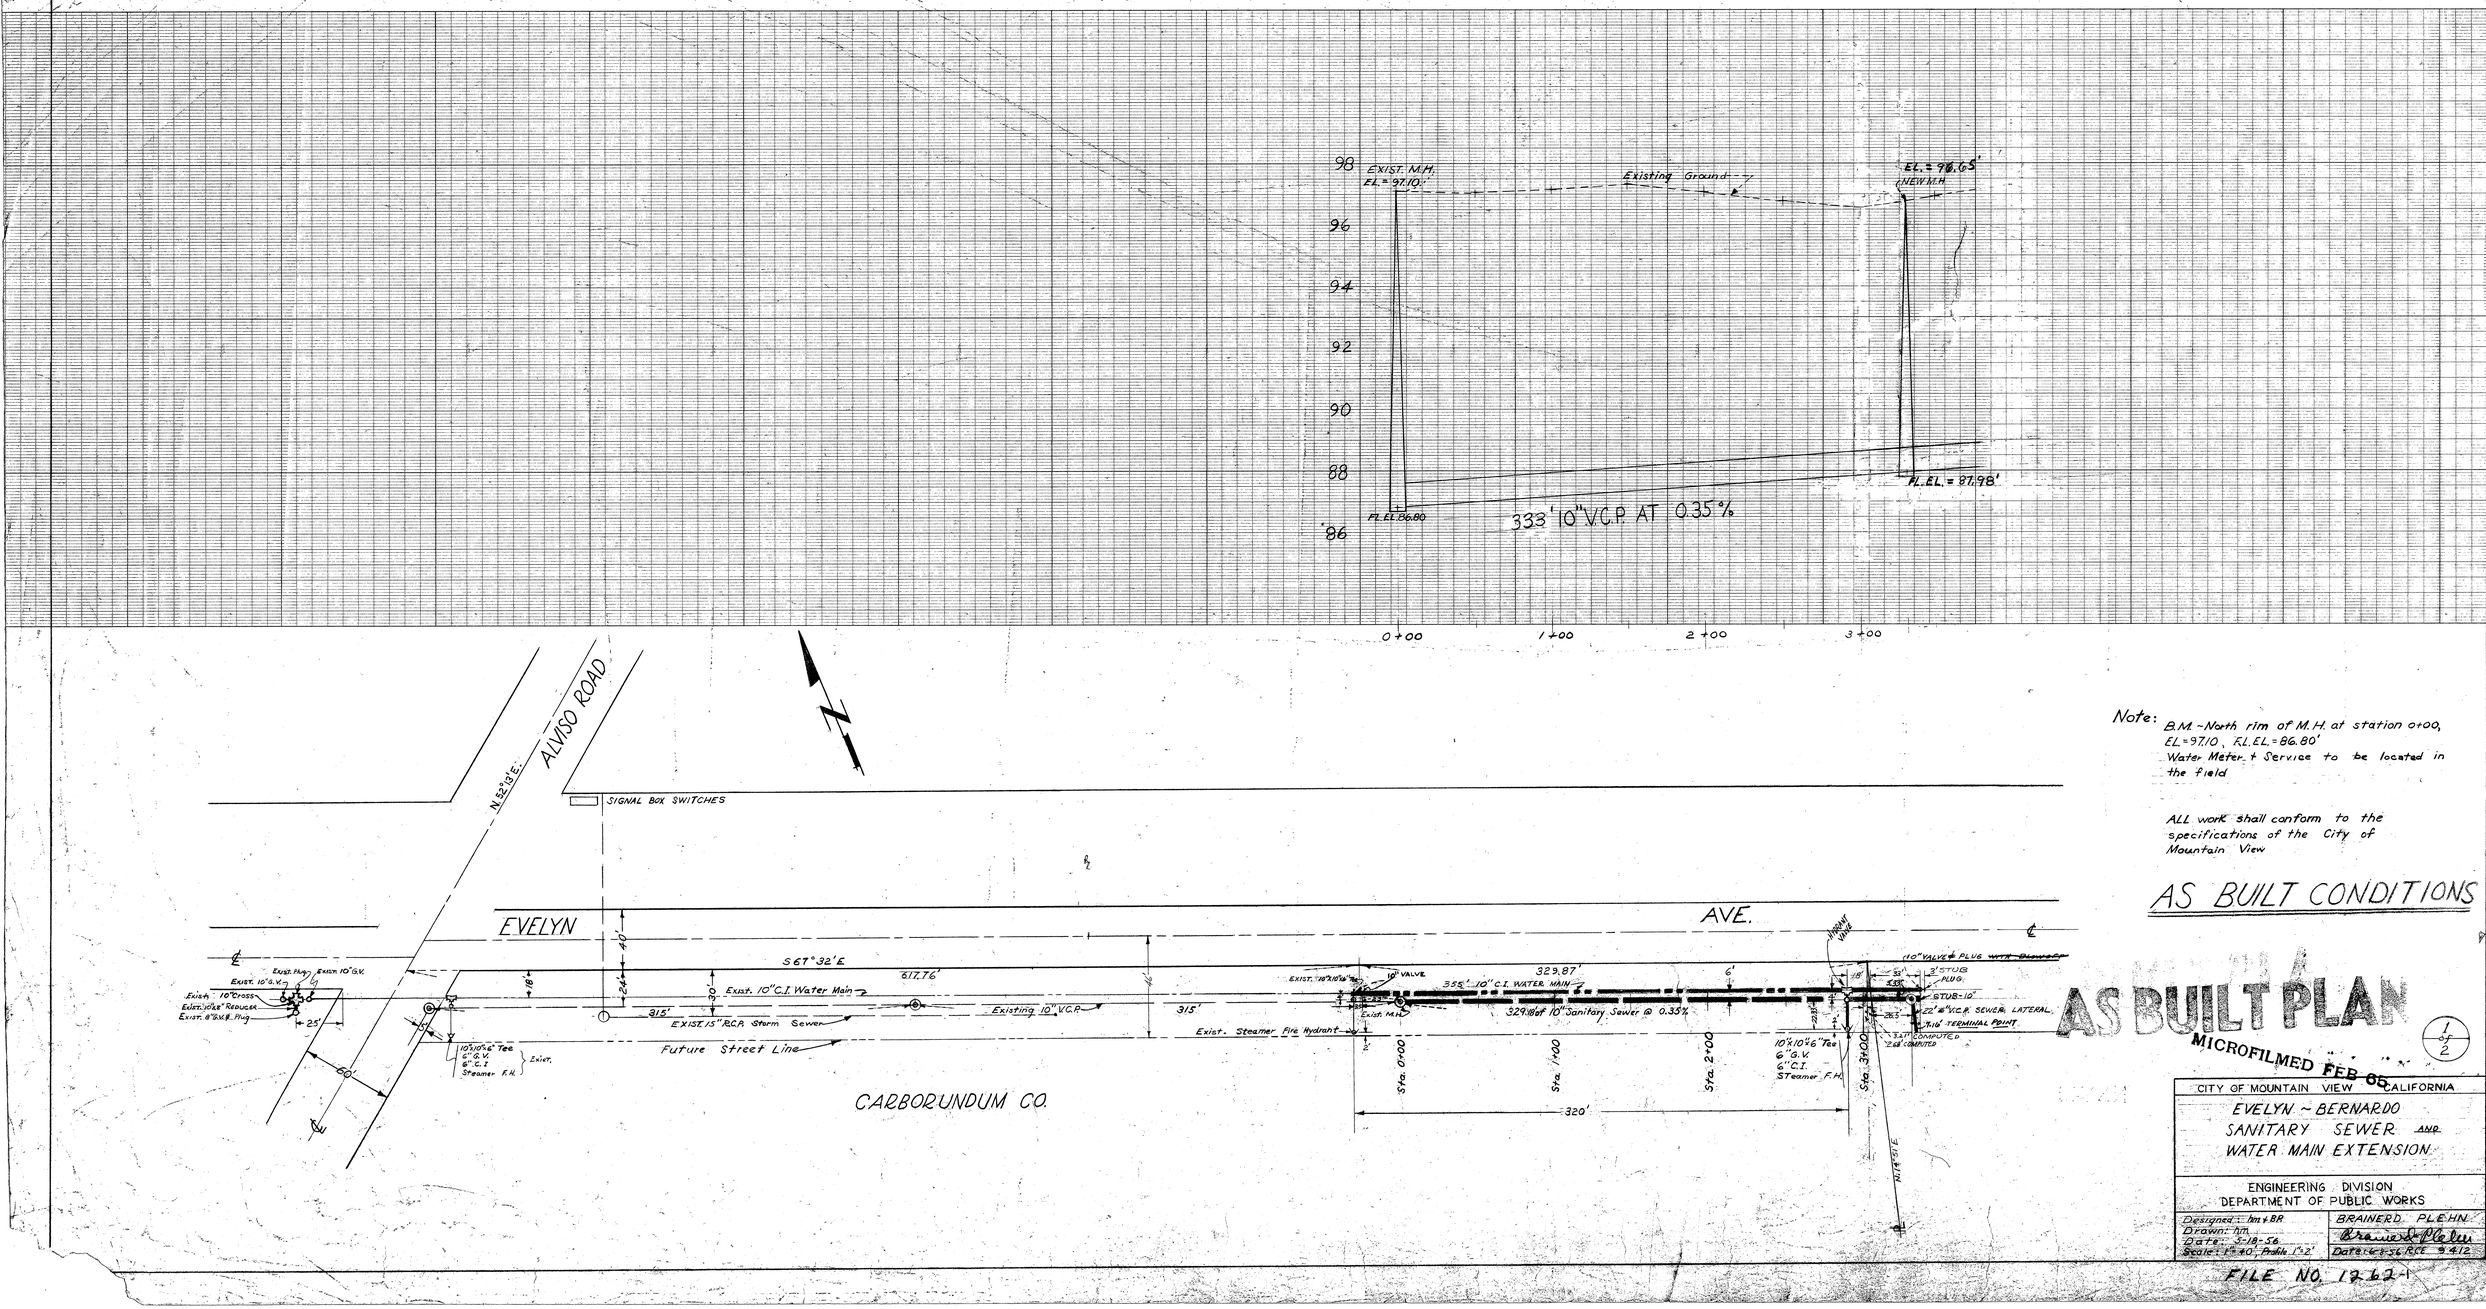

Note: B.M. - North rim of M.H. at station 0+00, EL = 97.10, FL. EL. = 86.80'
Water Meter + Service to be located in the field

ALL work shall conform to the specifications of the City of Mountain View

AS BUILT CONDITIONS

AS BUILT PLAN

MICROFILMED FEB 65

1 of 2

CITY OF MOUNTAIN VIEW CALIFORNIA

EVELYN ~ BERNARDO
SANITARY SEWER AND
WATER MAIN EXTENSION

ENGINEERING DIVISION
DEPARTMENT OF PUBLIC WORKS

Designed: hm + BR	BRAINERD PLEHN
Drawn: hm	Brainerd Plehn
Date: 5-18-56	
Scale: 1" = 40', Profile 1" = 2'	Date: 6-8-56 RCE 9412

FILE NO. 1262-1

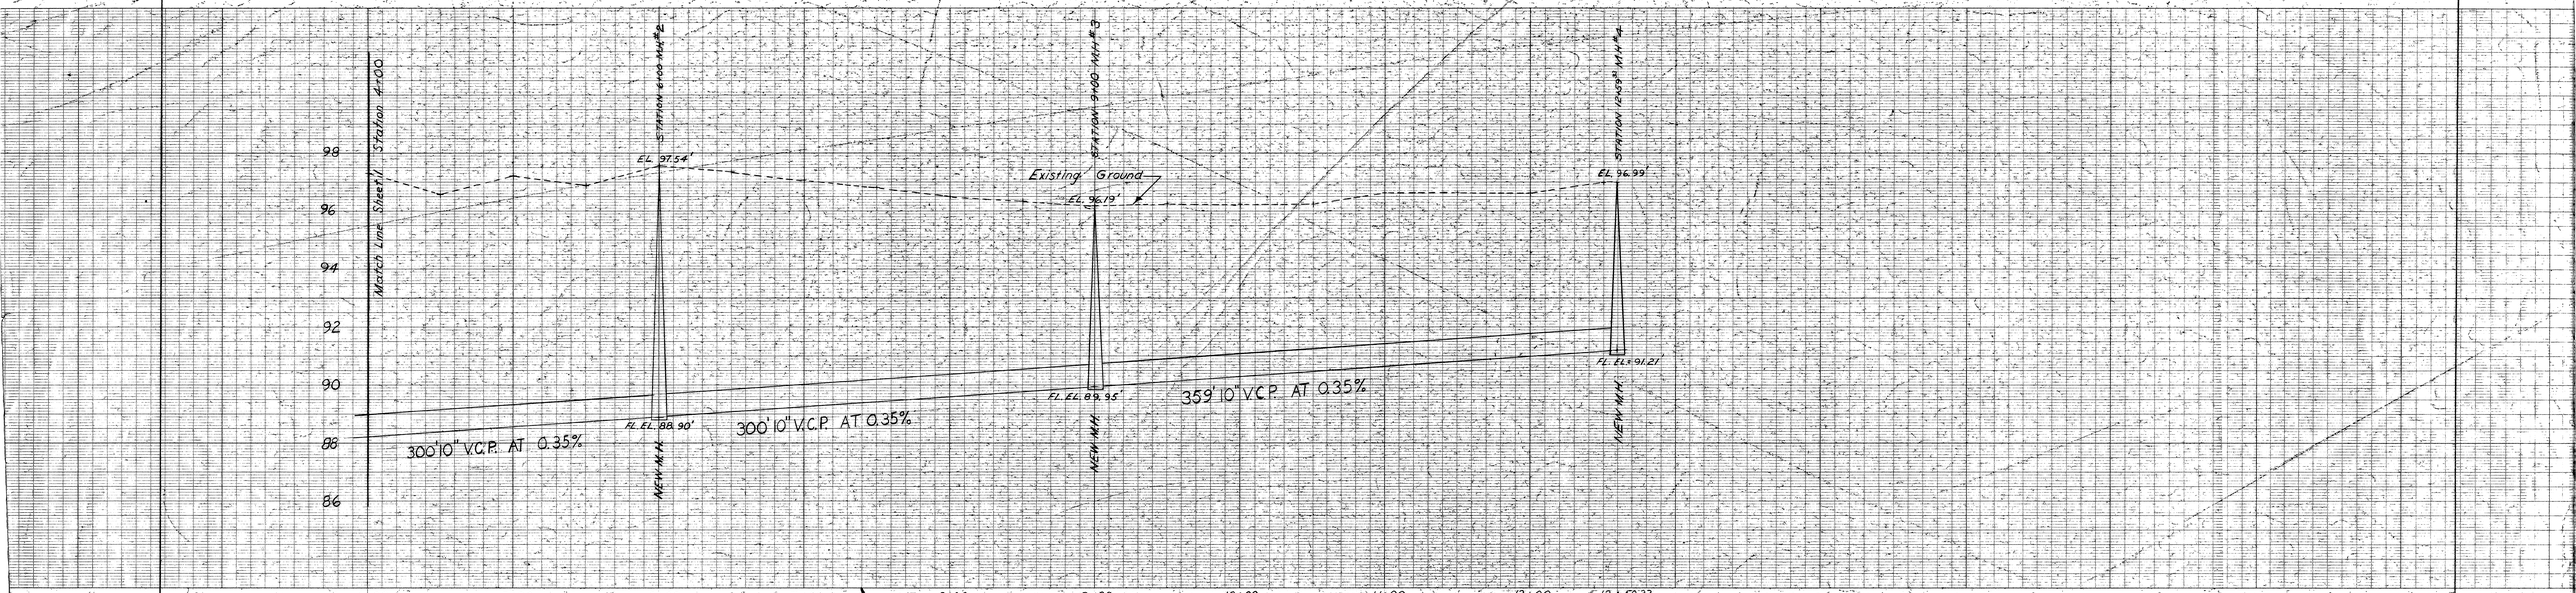

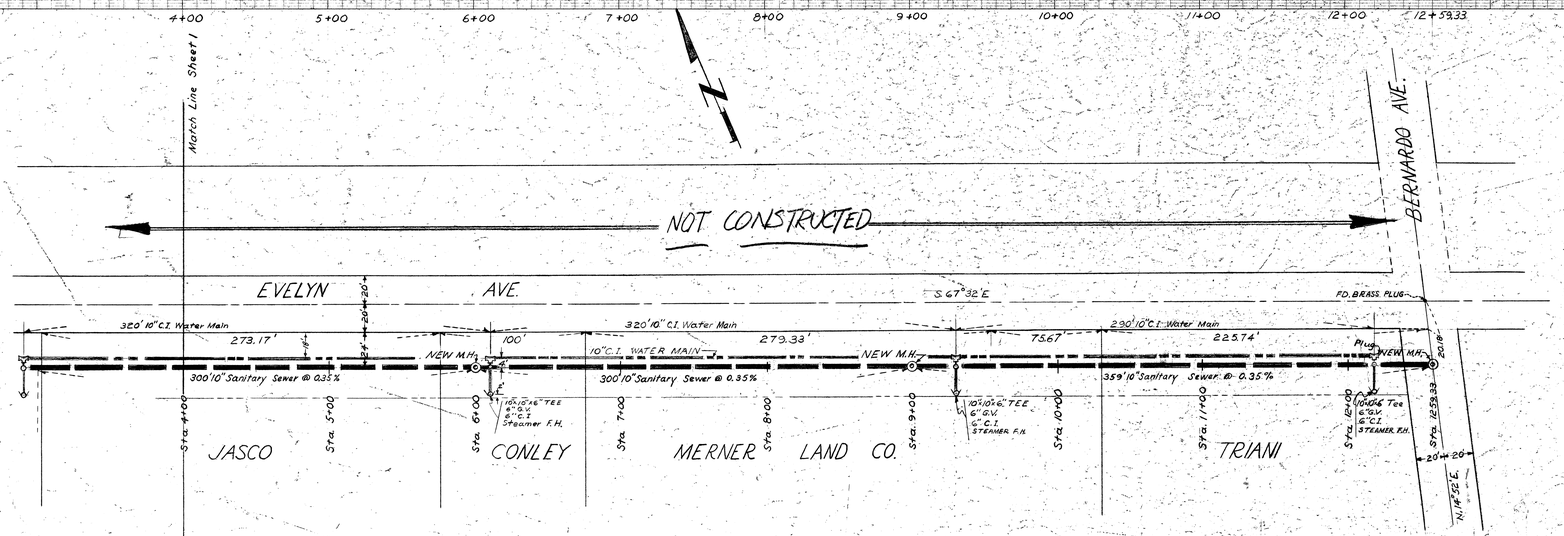

Note:

B.M. – North rim of M.H. at Station 0+00.
EL. = 97.10', FL. EL. = 86.80'

Ditch on Bernardo Street to be resurfaced with 12" of Rock Base and 2" A.C.

ALL work shall conform to the Specifications of the City of Mountain View

~~AS BUILT~~ 12/4/61

NOT BUILT

MICROFILMED FEB 65

2 of 2

CITY OF MOUNTAIN VIEW, CALIFORNIA

EVELYN – BERNARDO
SANITARY SEWER AND
WATER MAIN EXTENSION

ENGINEERING DIVISION
DEPARTMENT OF PUBLIC WORKS

Designed: h.m. + B.P.	BRAINERD PLEHN
Drawn: h.m.	
Date: 5-14-56	
Scale: 1"=40', Profile 1"=2'	Date R.C.E. 9412

FILE No. 1262-2