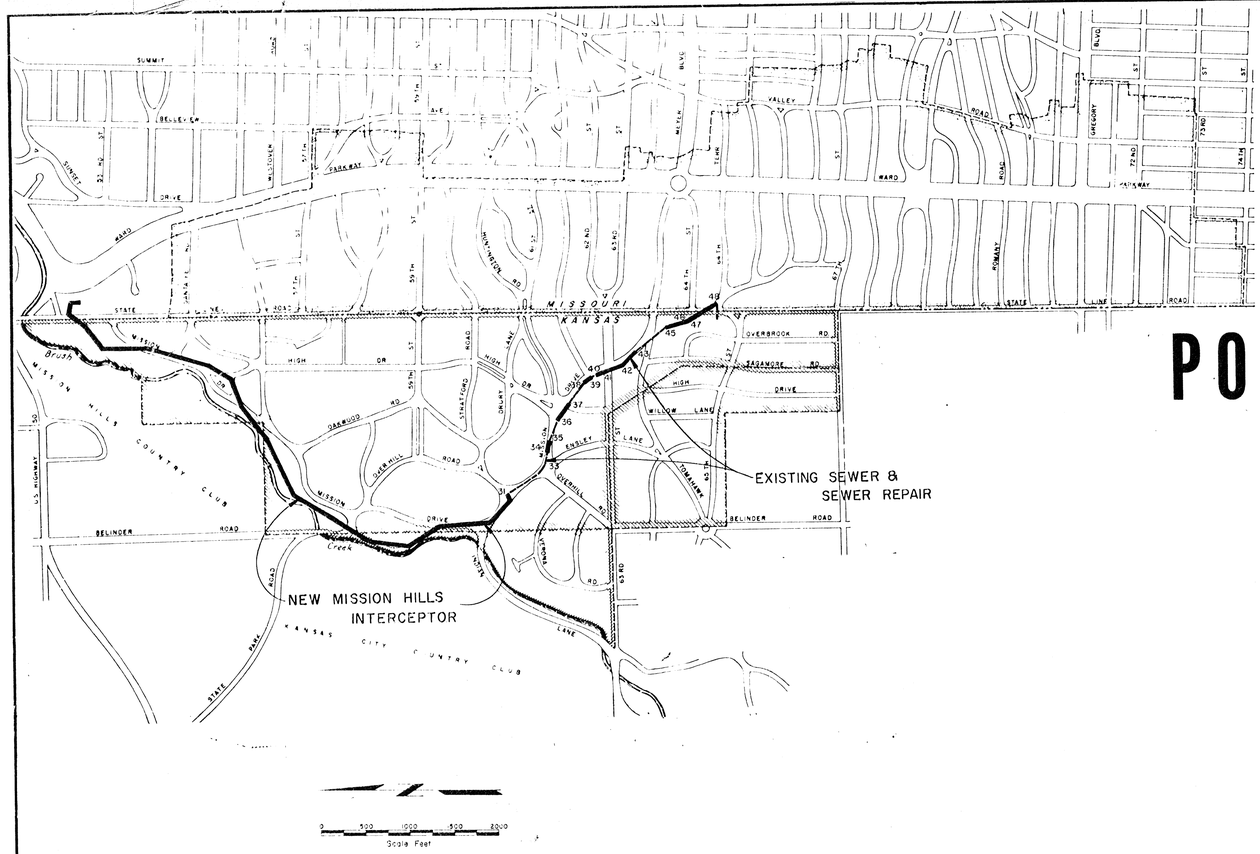

PLANS FOR

SEWERAGE IMPROVEMENTS

POLLUTION CONTROL DEPARTMENT

KANSAS CITY, MISSOURI

CONTRACT NO. 38

MISSION HILLS INTERCEPTOR

CONFORMED TO CONSTRUCTION RECORDS

BLACK & VEATCH AND BURNS & McDONNELL

CONSULTING ENGINEERS

KANSAS CITY, MISSOURI

PROJECT NO. 3292 D38

1964

D-1000.01