8-13-90
12.3.8 v.5

USEPA SF
1261567

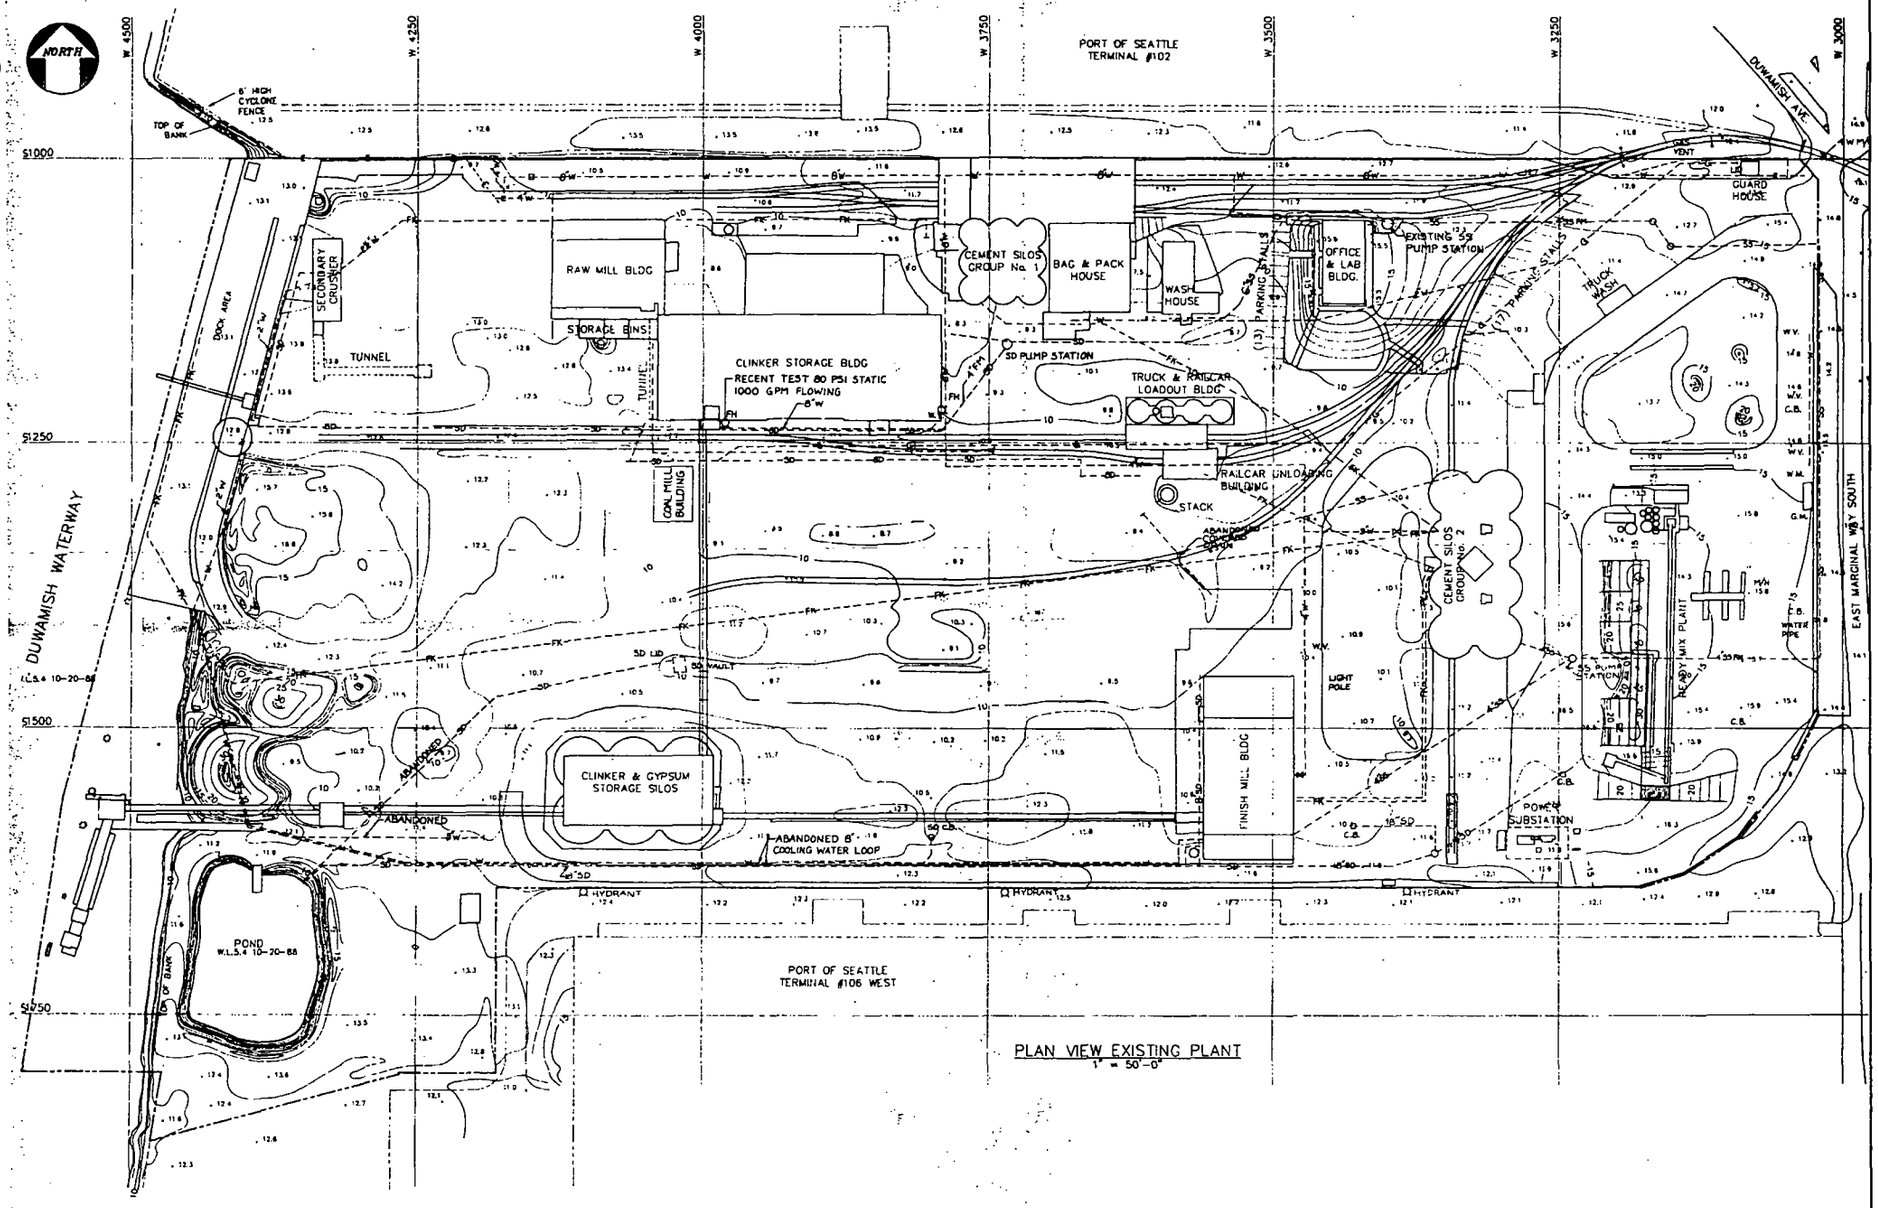

PLAN VIEW EXISTING PLANT
1" = 50'-0"

HNTB
ARCHITECTS ENGINEERS PLANNERS
HOWARD NEEDLES TAMMEN & BERGENDOFF
800 108TH AVE. N.E. SUITE 405
BELLEVUE, WASHINGTON 98004
PHONE 206 455 3555

ASH GROVE CEMENT WEST, INC.
8720 S.W. MACADAM AVE., SUITE 200
PORTLAND, OREGON 97219-2212
(503) 293-2333

EXISTING PLANT AND UTILITY PLAN

PROJECT NO	13957
DATE	8/15/90
DRAWN BY	SLL
CHECKED BY	KWA
CHECKED BY	KWM
REVISED DATE	

As-Built Documents 4-1-92

001-C-2