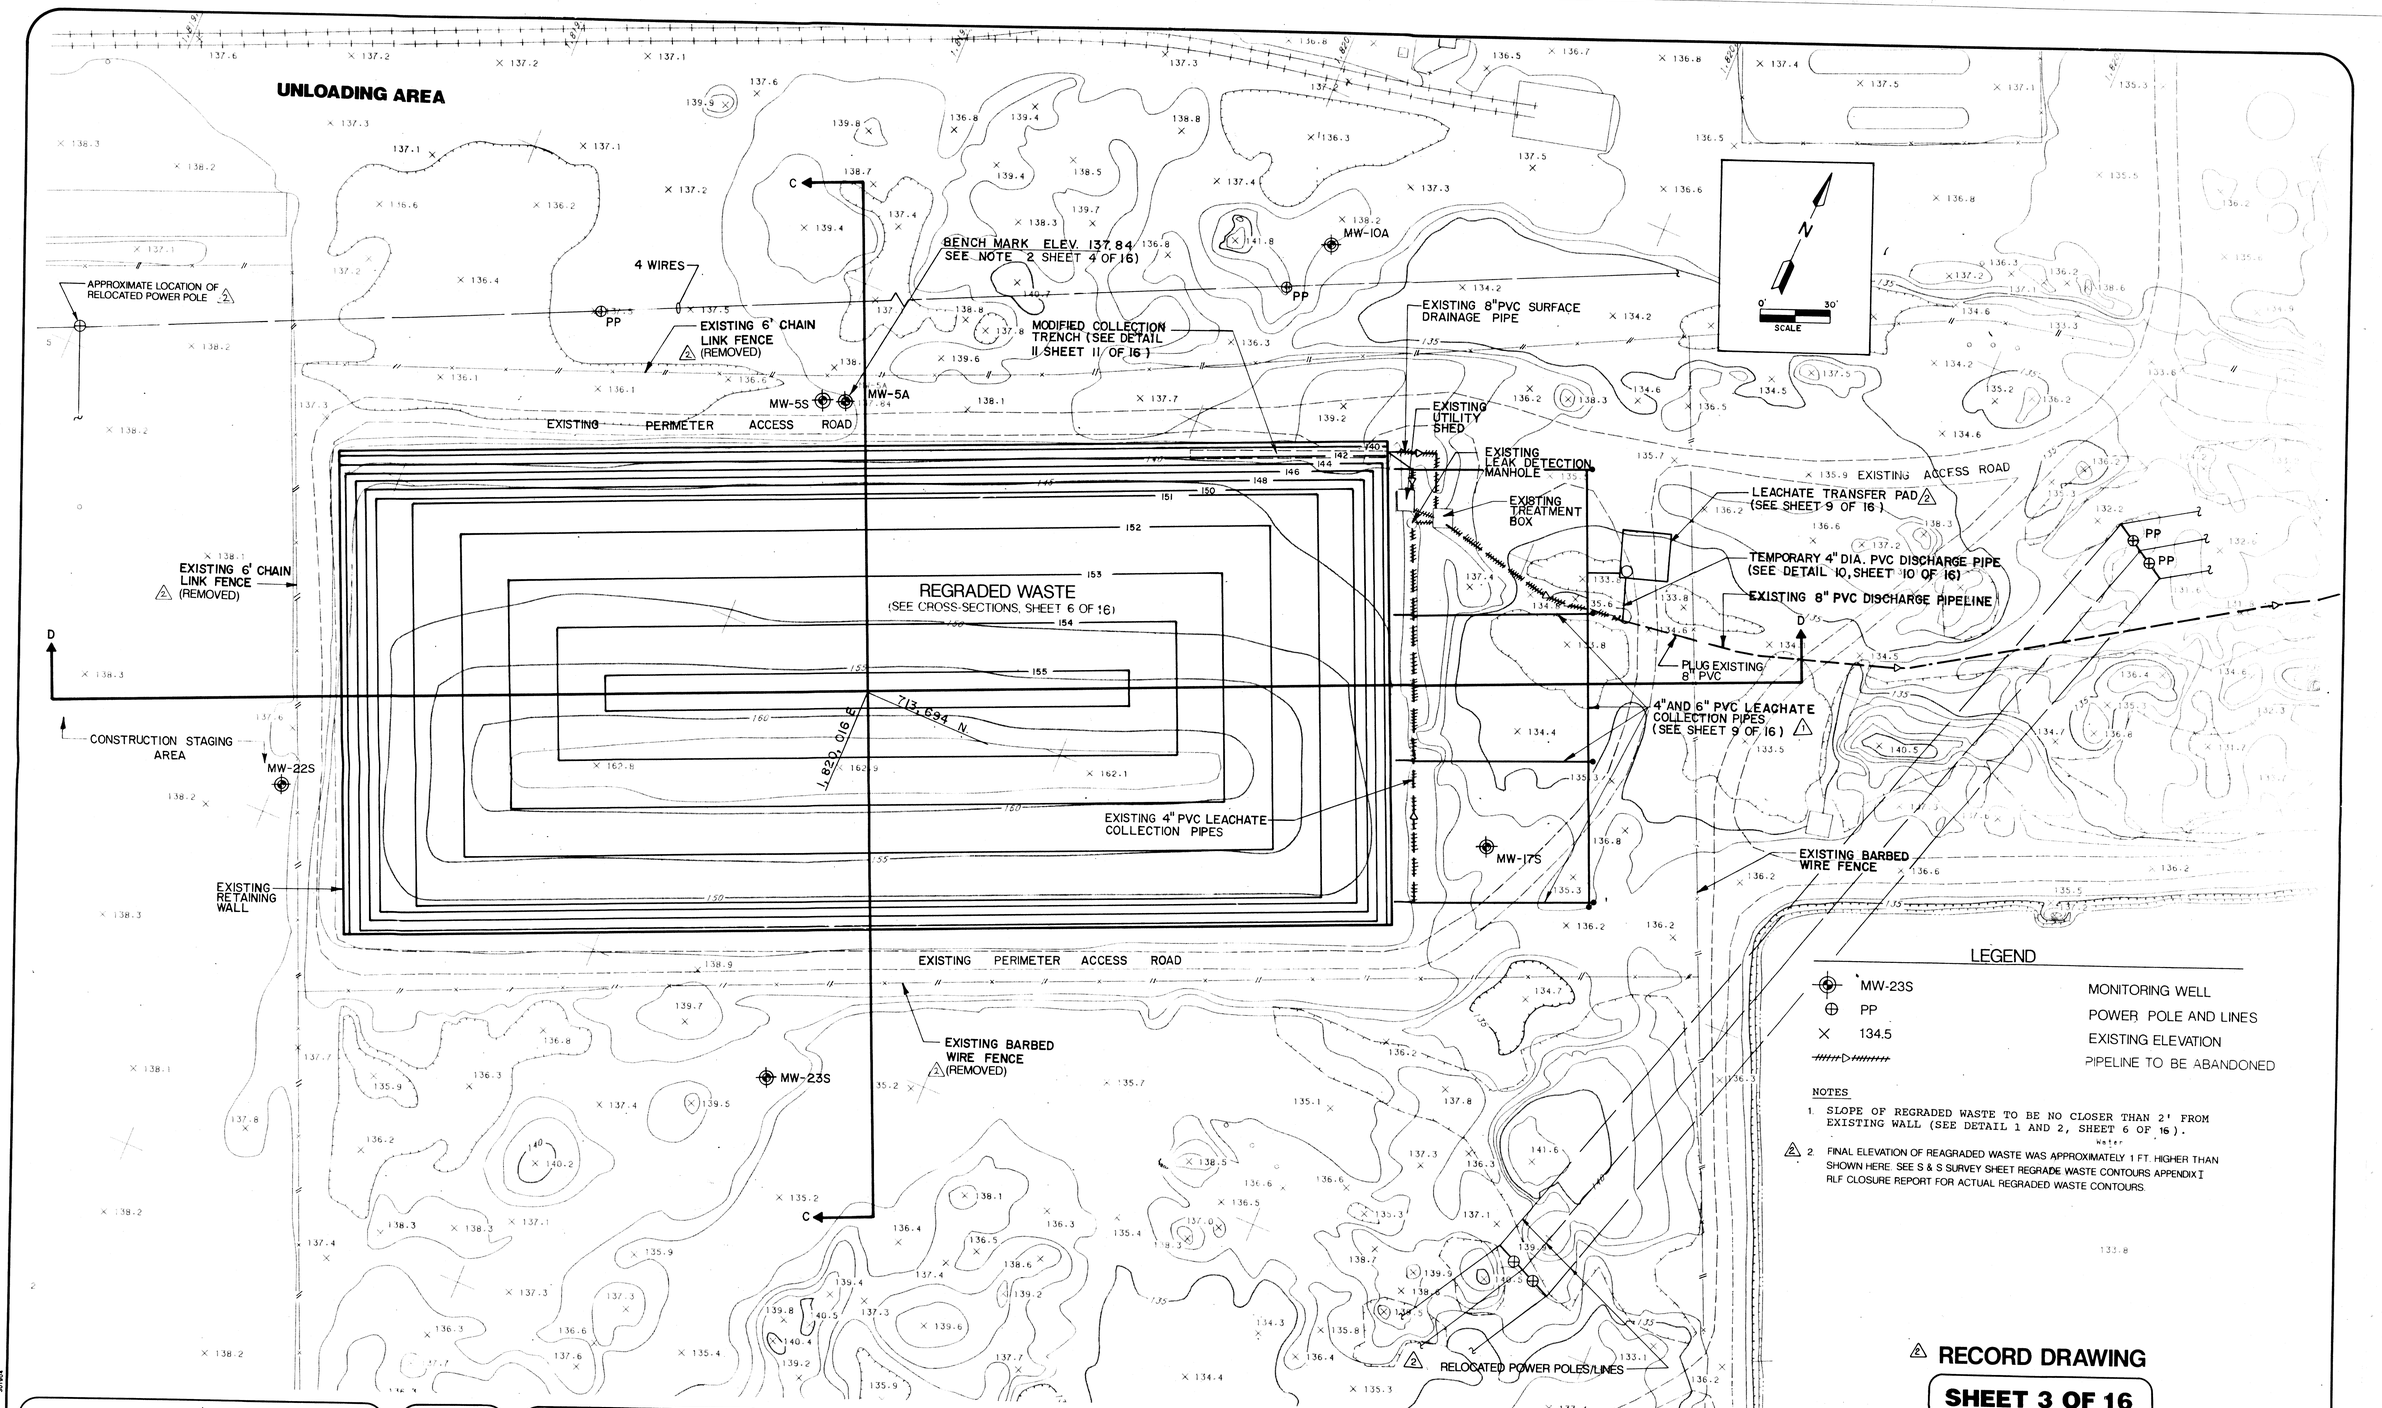

NOTES

1. SLOPE OF REGRADED WASTE TO BE NO CLOSER THAN 2' FROM EXISTING WALL (SEE DETAIL 1 AND 2, SHEET 6 OF 16).
2. FINAL ELEVATION OF REAGRADED WASTE WAS APPROXIMATELY 1 FT. HIGHER THAN SHOWN HERE. SEE S & S SURVEY SHEET REGRADE WASTE CONTOURS APPENDIX I RLF CLOSURE REPORT FOR ACTUAL REGRADED WASTE CONTOURS.

RECORD DRAWING

SHEET 3 OF 16

DRAWING CONFIDENTIAL: THIS DRAWING AND ALL INFORMATION CONTAINED THEREON IS AND SHALL REMAIN THE PROPERTY OF G&M CONSULTING ENGINEERS, INC. AS AN INSTRUMENT OF PROFESSIONAL SERVICE. THIS INFORMATION SHALL NOT BE USED, IN WHOLE OR IN PART, WITHOUT THE FULL KNOWLEDGE AND PRIOR WRITTEN CONSENT OF G&M CONSULTING ENGINEERS.

SCALE VERIFICATION
THIS BAR REPRESENTS ONE INCH ON THE ORIGINAL DRAWING:
USE TO VERIFY FIGURE SCALE

REV. NO.	DATE	DESCRIPTION	BY	APPR.
1	11-28-89	ADDITION OF DUAL PIPING	D.D.	JAP
2	9-24-91	REVISED PER REC. DRAW.	A.A.A.	J.G.

DRAWING NO: FLOO18-CWP-D03	
DRAWN BY: Ken Carroll	DATE: March 6, 1989
CHECKED: Carl Duncan	DATE: May 20, 1989
APPROVED: V. PETERSOHN	DATE: MAY 20, 1989

GERAGHTY & MILLER ENGINEERS, INC.

REGRADED WASTE PLAN

RCRA LANDFILL CLOSURE

MARTIN MARIETTA CORPORATION

THE DALLES, OREGON

BAY REPROGRAPHICS 301904