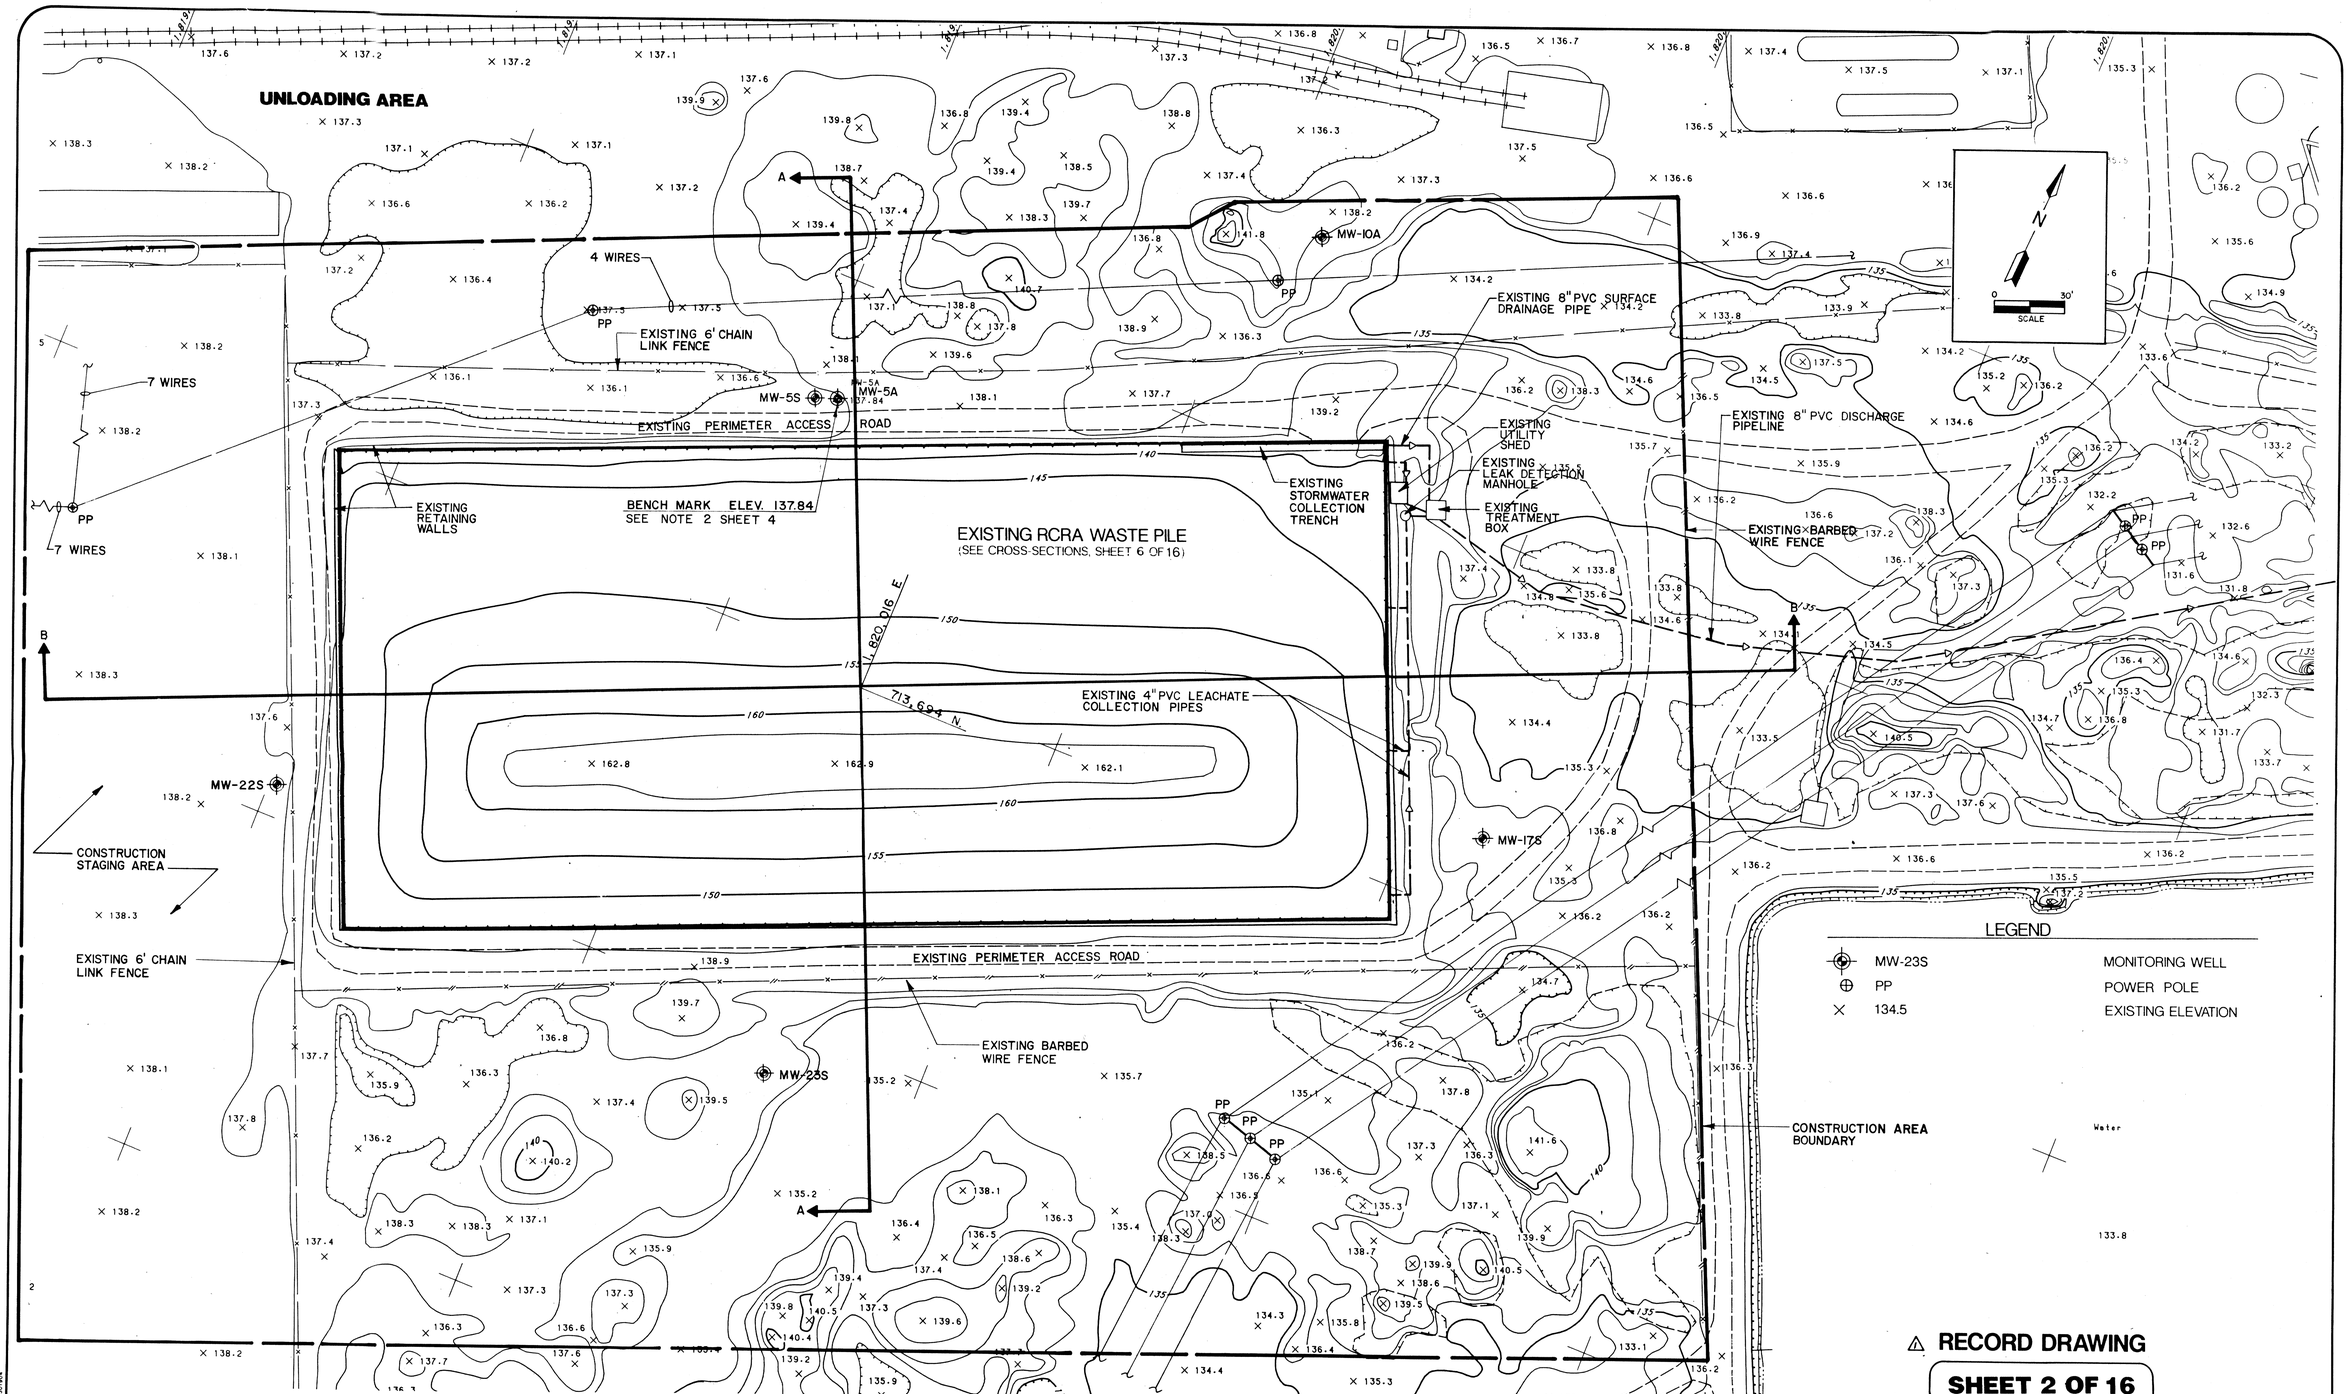

△ RECORD DRAWING

SHEET 2 OF 16

DRAWING CONFIDENTIAL: THIS DRAWING AND ALL INFORMATION CONTAINED THEREON IS AND SHALL REMAIN THE PROPERTY OF G&M CONSULTING ENGINEERS, INC. AS AN INSTRUMENT OF PROFESSIONAL SERVICE. THIS INFORMATION SHALL NOT BE USED, IN WHOLE OR IN PART, WITHOUT THE FULL KNOWLEDGE AND PRIOR WRITTEN CONSENT OF G&M CONSULTING ENGINEERS.

SCALE VERIFICATION
THIS BAR REPRESENTS ONE INCH ON THE ORIGINAL DRAWING:
0 1"
USE TO VERIFY FIGURE SCALE

REV. NO.	DATE	DESCRIPTION	BY	APPR.
△	9-24-91	REVISED PER REC. DRAW.	K.A.A.	J.G.

DRAWING NO: FLOO18-CWP-D02	
DRAWN BY: Ken Carroll	DATE: March 16, 1989
CHECKED: C. Duncan	DATE: May 20, 1989
APPROVED: V. Petersohn	DATE: May 20, 1989

GERAGHTY & MILLER ENGINEERS, INC.

EXISTING SITE CONDITIONS

RCRA LANDFILL CLOSURE

MARTIN MARIETTA CORPORATION

THE DALLES, OREGON

BAY REPROGRAPHICS 201904