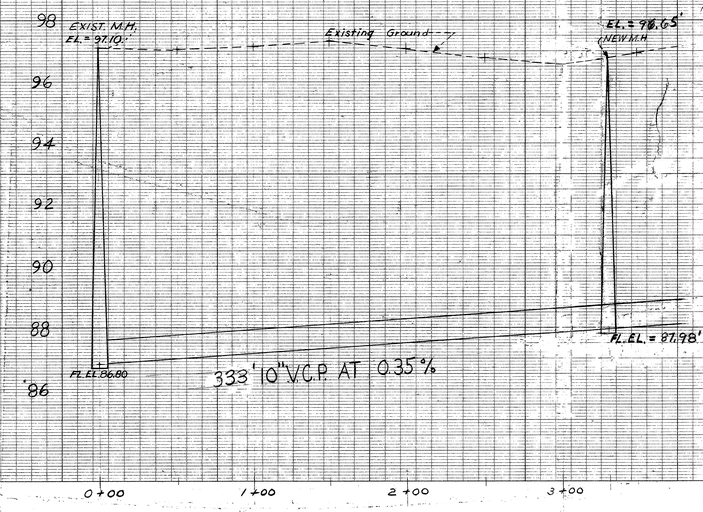

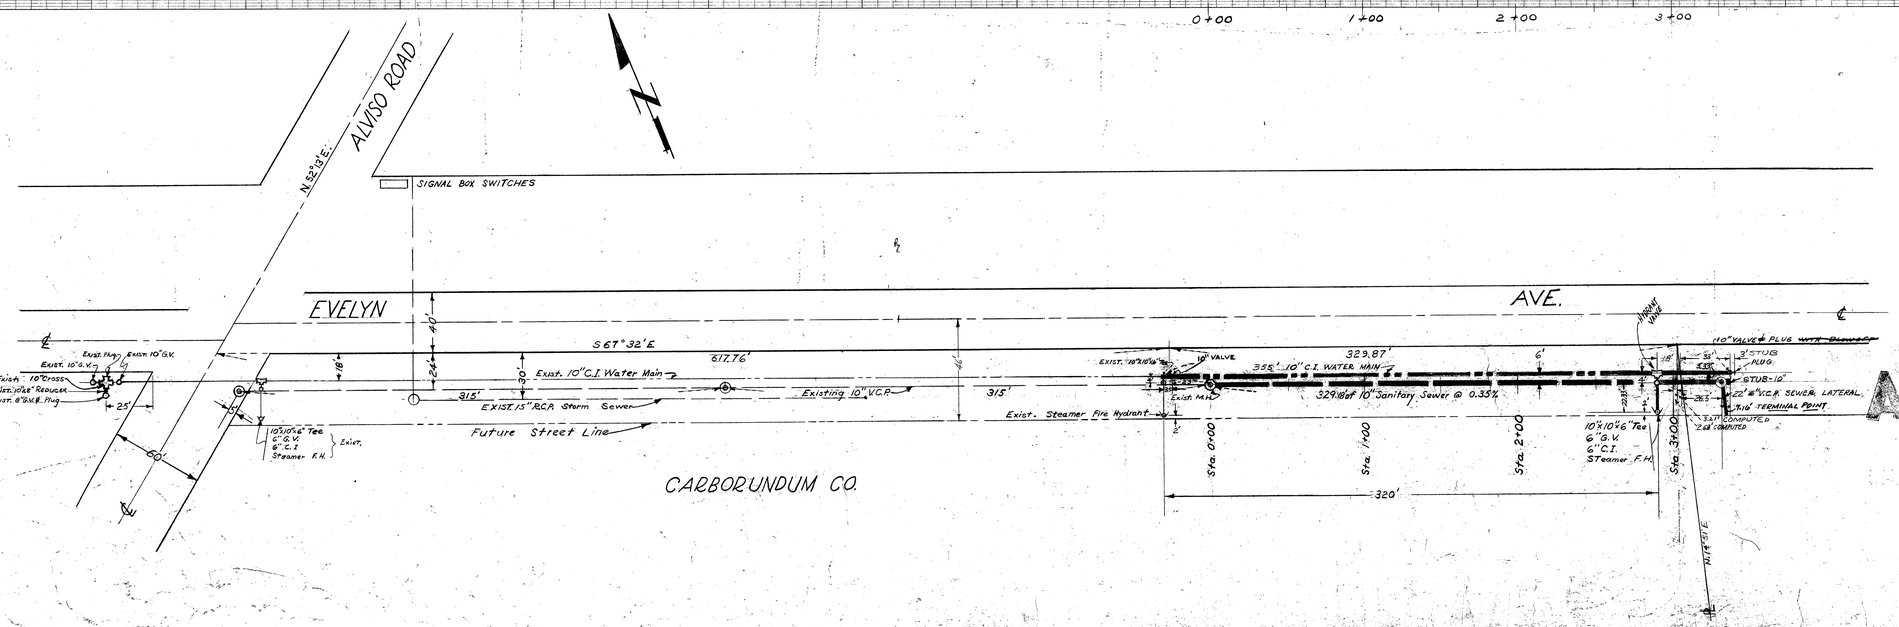

Note: B.M. - North rim of M.H. at station 0+00, EL = 97.10, FL. EL. = 86.80'
Water Meter + Service to be located in the field

ALL work shall conform to the specifications of the City of Mountain View

AS BUILT CONDITIONS

AS BUILT PLAN

MICROFILMED FEB 06

1 of 2

CITY OF MOUNTAIN VIEW CALIFORNIA

EVELYN ~ BERNARDO
SANITARY SEWER AND
WATER MAIN EXTENSION

ENGINEERING DIVISION
DEPARTMENT OF PUBLIC WORKS

Designed: hm + BR	BRAINERD. PLEHN
Drawn: hm	Brainerd Plehn
Date: 3-18-56	
Scale: 1" = 40', Profile 1" = 2'	Date: 6-8-56 RCE 9412

FILE NO. 1262-1

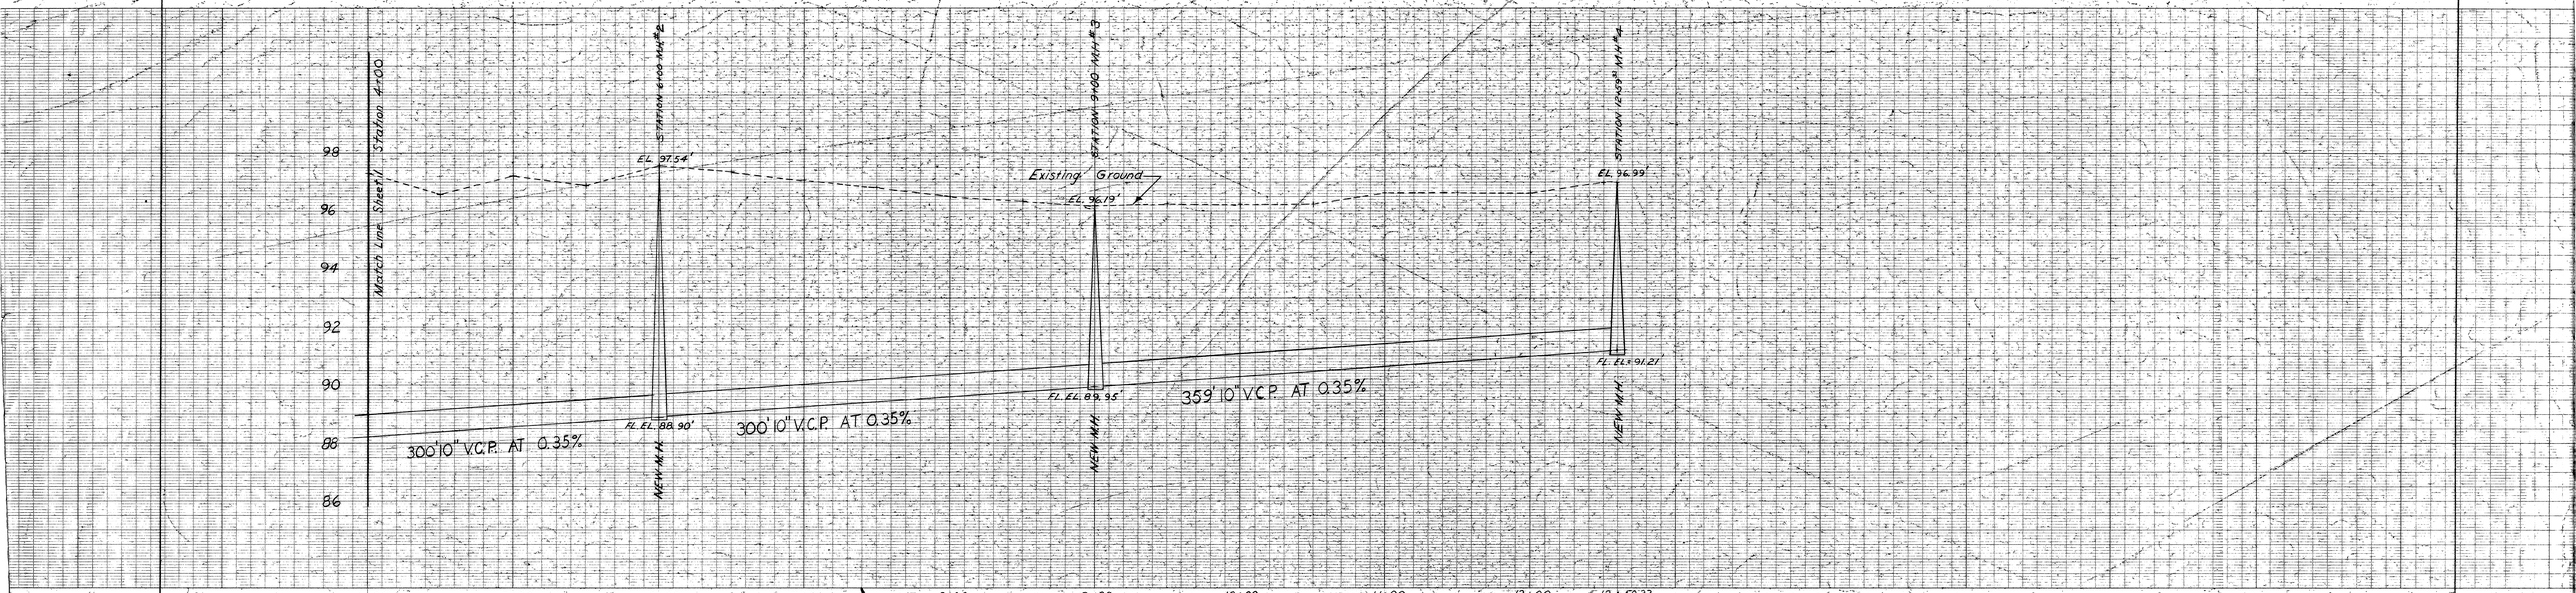

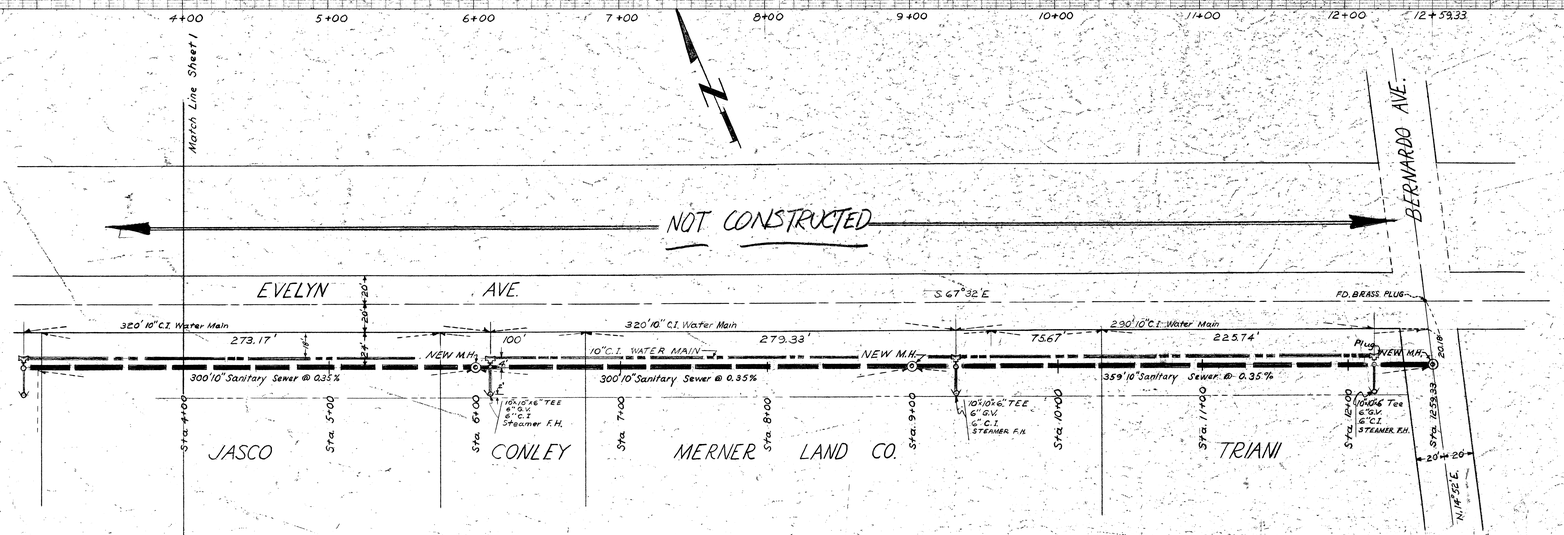

Note:

B.M. ~ North rim of M.H. at Station 0+00.
EL. = 97.10', FL. EL. = 86.80'

Ditch on Bernardo Street to be resurfaced with 12" of Rock Base and 3" A.C.

ALL work shall conform to the Specifications of the City of Mountain View

~~AS BUILT PLAN~~ 1/4/61

NOT BUILT

MICROFILMED FEB 65

2 of 2

CITY OF MOUNTAIN VIEW, CALIFORNIA	
EVELYN ~ BERNARDO SANITARY SEWER AND WATER MAIN EXTENSION	
ENGINEERING DIVISION DEPARTMENT OF PUBLIC WORKS	
Designed: h.m. + B.P. Drawn: h.m. Date: 5-18-56 Scale: 1"=40', Profile 1"=2'	BRAINERD PLEAN Date RCE 9412

FILE NO. 1262-2