MATCH LINE
SEE DWG EM-103002

N
E 2291000
E 2292000
E 2293000
E 2294000
E 2295000
E 2296000
E 2297000
N 401000
N 400000
N 399000
N 398000

SLUDGE POND

CLEANING STATION
RELOCATED GAS LINES
OVERHEAD POWER LINES
N399707.94
E2293162.25
SR WEIGH SCALES
SCRAP MARSHALLING YARD PHASE I-94 CAP CAP
SCALE HOUSE
GAS METER HOUSE
N399570
E229538
OFFICE, SCALE & PARKING
140'-0 OHIO POWER RIGHT-OF-WAY
20,000 GAL CAP NO.2 DIESEL OIL FUEL STORAGE TANK AND PUMP
CAPPED GAS WELL
PLANT GRADE EL 1080'-0
70
ELECTRICAL SUBSTATION (SIZED FOR 2MTPY FACILITY)
N399305
E2295093
SUBSTATION CONTROL BUILDING
EAST OHIO GAS CO RIGHT OF WAY
SLAG PROC PLANT (BY OTHERS)
WHIPPLE AVE
BAGHOUSE
N399164.17
E2294566.66
BAGHOUSE & COOLING WATER TOWER ELEC EQUIP ROOM
ELEC FCE & VAD COOLING TOWER PUMPHOUSE
N399110
E2294505
BOILER HOUSE
N398953
E2294266
GARAGE
RETURN WATER PUMP HOUSE
ARGON STORAGE TANK
N398953
E2294196
VAD COOLING TOWER
EL. 1070'-0
79
71
SCRAP AISLE
SERVICE AISLE
TRANSFORMER STORAGE
73
UNLOADING DOCK CARS & TRUCKS
SLAG HAUL ROAD
CHARGING AISLE
72
BIN AISLE
LADLE AISLE
41 CAR CAPACITY
LAYDOWN AREA
N 398350
E 2293125
BILLET CONDITIONING
TEEMING AISLE
STOOL PREP
77
78
CAPPED GAS WELL
BAGHOUSE
TRUCK DUMP STATION
RAMP
NOTES:
1. NOMINAL PLANT GRADE IN AREAS OF PROCESS BUILDING IS 1061'-0 ALL PLANT FLOORS (GROUND FLOORS) AT ELEV 1081'-6
2. PREVAILING WINDS ARE FROM THE SOUTHWEST EXCEPT IN THE MONTHS OF FEB AND MARCH. IN FEB AND MARCH PREVAILING WINDS ARE FROM THE NORTHWEST.
NORFOLK & WESTERN R.R.
LAYDOWN AREA
HOLD PREP & INGOT STRIPPING
N397911
E2294622.5
COVERED WALKWAY
UTILITY BRIDGE
BULK MATERIAL STORAGE BLDG (FUTURE)
FUTURE LAYDOWN AREA
ROLL SHOP
MILL MOTOR ROOM
FIREHOUSE
SLAG HAUL ROAD
UNLOADING DOCK
N 397990
E 2293075
46" BLOOMING MILL & 24" BILLET MILL
SOAKING PITS
RECEIVING & STORAGE
FUTURE
TRUCK SCALE
76
74
CAPPED GAS WELL
FIRE PROTECTION RESERVOIR & PUMP HOUSE
N397556
E2292580
75
GUARD HOUSE & GATE
30 CAR CAPACITY
EMPLOYEE PARKING LOT
LOCKER ROOM & SECURITY STATION
KROPF AVE
FAIRCREST ST

RELEASED FOR CONSTRUCTION

FIGURE B-3 SWMU Location Map for the Faircrest Section of Timken

REV	REDRAWN	
REV 1	GENERAL REV	EP / LGU
REV 2	REDRAWN	PS / LGU
REV 3	ADD GAS LINE & R/W REMOVED RAIL CAR DUMPER & TRACKS REV R.R. TRACKS REV STOOL PREP REV TEEMING AISLE REV PLANT AREA REPAIR BLDG ADDED SLAG HAUL ROAD REPAIR BLDG	PS / LGU
REV 4	REV PLANT ENTRANCE & FILL LINE ADDED & TRACK DELETED REV STATION LOC ADDED COVERED WALKWAY ADDED SINGLE GATES	PS / LGU
REV 5	REV R.R. CONNECT. STORAGE TANK REV R.R. TRACKS & TRACK DELETED REV STATION LOC ADDED REV R.R. TRACKS & BLDG DELETED REV SLAG PROC AREA REV HOLD PREP BLDG ADD ROLL LINE REV ROLL SHOP	PS / LGU
REV 6	REMOVED SITE OF FUTURE BLDG REMOVED FUTURE TRACKS	PS / LGU
REV 7	REMOVED FIRE & PUMP HOUSE REMOVED MEDICAL & WASH BLDG'S REV PLANT AREA & STORAGE BLDG. REV R.R. TRACKS ADDED SLAG RELAIN FACILITY	PS / LGU
REV 8	REV ALL BLDGS. REV SLAG AREA PROC PLANT	PS / LGU
REV 9	REV ELEC SUB STATION REDUCED REV GAS METER HOUSE REV R.R. TRACKS PLANT AREA REV SCRAP MILL EXISTING TOWER	PS / LGU
REV 10	REV BAGHOUSE, TRUCKS ADDED COOLING TOWER VALVAY REV TIME REV CO-GEN BLDG RELOCATE STATION EQUIP	PS / LGU
REV 11	RELOCATE TRACK PUMP HOUSE	PS / LGU
REV 12	RELOCATED BOILER HOUSE, PERSONNEL TRACKS & LAYDOWN BLDG. STATION REV CO-GEN BLDG	PS / LGU
REV 13	RELOCATED GUARD HOUSE, CAPACITY & LOCKER ROOM & REV PARKING LOT, REV PARKING LOT, REV TRACKS, REV BLDG. TIMKEN BUGHOUSE	PS / LGU
REV 14	REV HOUSE & SCALE HOUSE, BILLET BLDG. REV BILLET BLDG. & COOLING TOWER ADD COVERED WALKWAY & ADDED LOADING DOCK REV R.R. TRACKS & LOCKER ROOM PKG LOT REMOVED UNCOVERED PKG LOT REMOVED RETAIN WATER REV SLAG PROCESS AREA	PS / LGU
REV 15	REV NEW AREA BILLET BLDG. ADD COVERED WALK ADD NEW PKG LOT	PS / LGU
REV 16	GENERAL REVISION AS BUILT	PS / LGU

A AS BUILT ISSUE

DRAVO ENGINEERS AND CONSTRUCTORS

TIMKEN — PITTSBURGH, PENNSYLVANIA

APPR. S.L. STERMER	APPROVAL ISSUE	CONTRACT M-7205
APPR. S.R. SMITH	D.E. W. GAINE 2/17	ISSUE NO.
APPR. L.J. UPEDAL	J.E. L. UIZIO 2/2	DATE PRINTED
APPR. J.B. MUSAT	S.E. W.L. PATRICK 2/17	CODE 2081
APPR.	CONSTRUCTION ISSUE	AREA 01
APPR.	D.E. W. GAINE 2/17	
	J.E. L. UIZIO	
DATE 2-9-82	S.E. W.L. PATRICK 2/17	

THIS DRAWING WAS PREPARED BY THE TIMKEN COMPANY

SUPERSEDES	
SUPERSEDED BY	
DRAWN	R. A. STEPEST
CHECKED	L. G. UIZIO
APPROVED DATE	
ORIGINAL SCALE	1"=200'
PROJECTION	

TIMKEN
THE TIMKEN COMPANY
CANTON, OHIO, U.S.A.

PLOT PLAN
SOUTH AREA
PHASE I

EM 103001 16

12/06/85

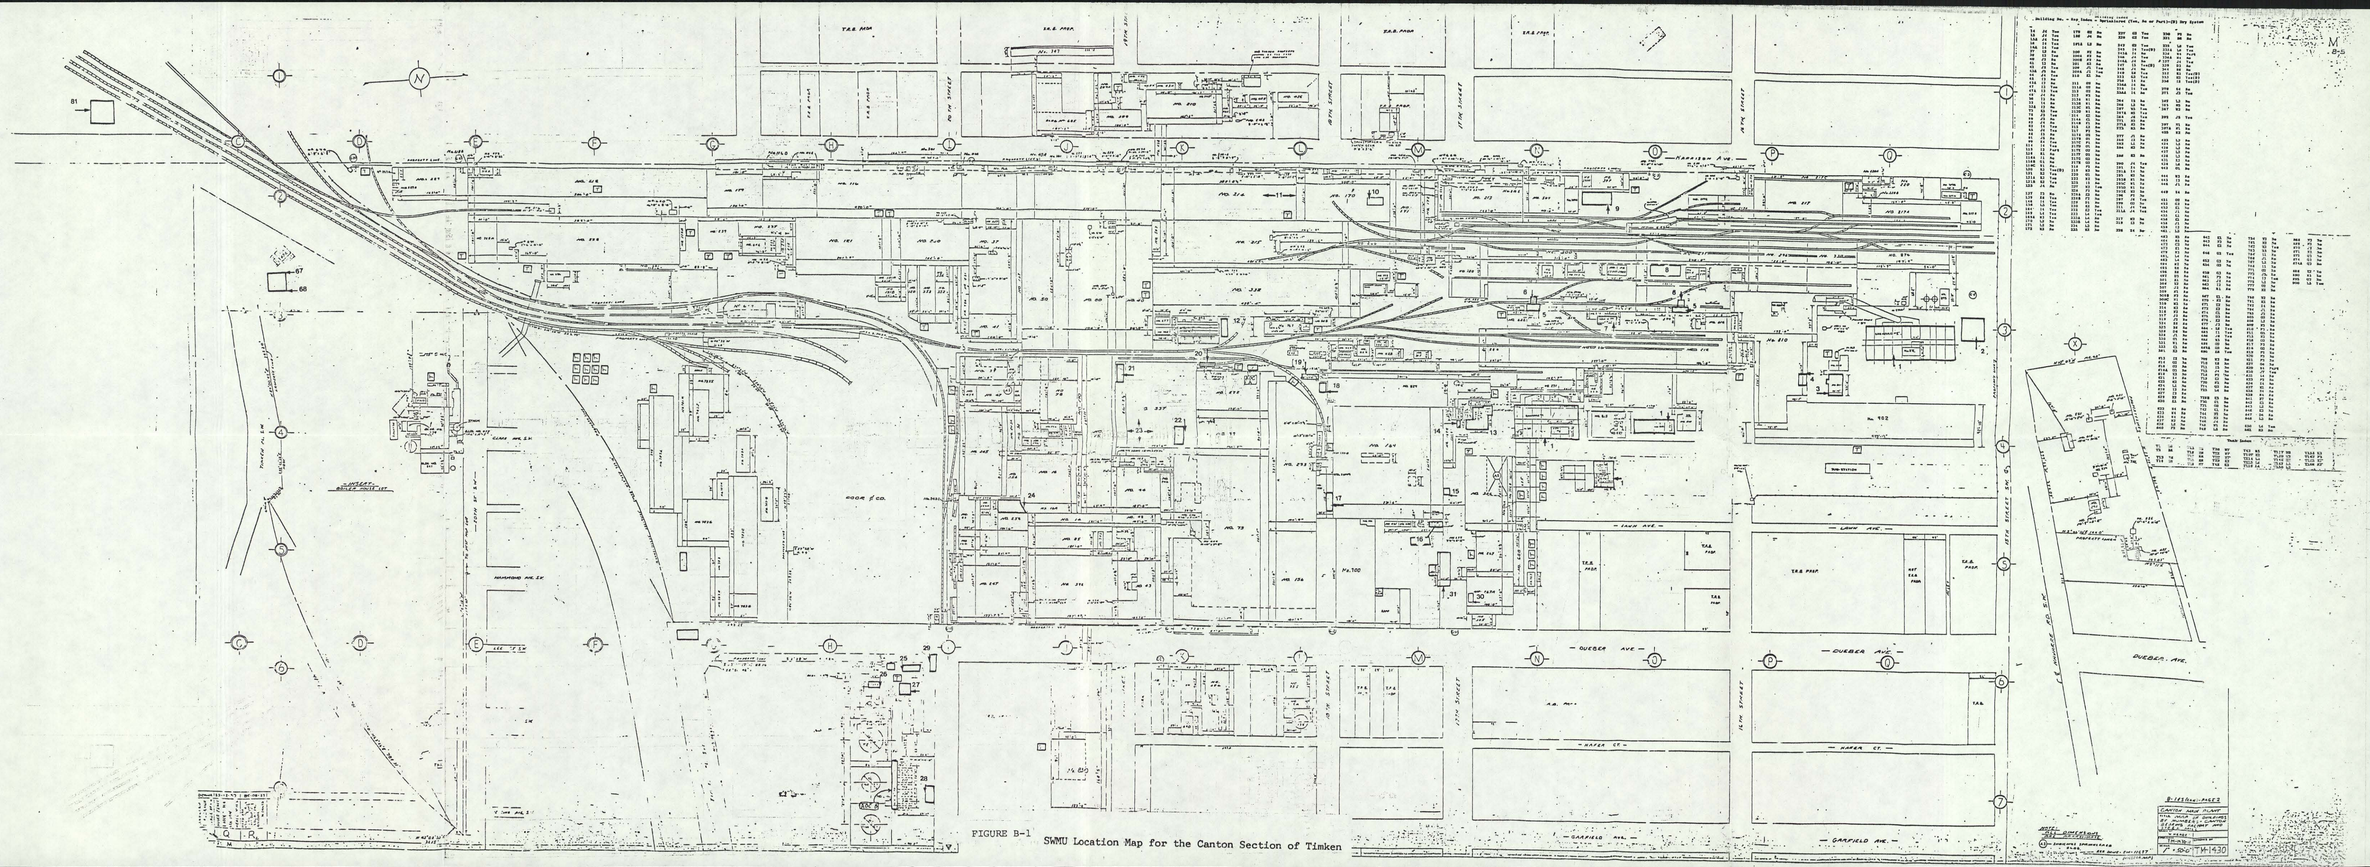

FIGURE B-1 SWMU Location Map for the Canton Section of Timken

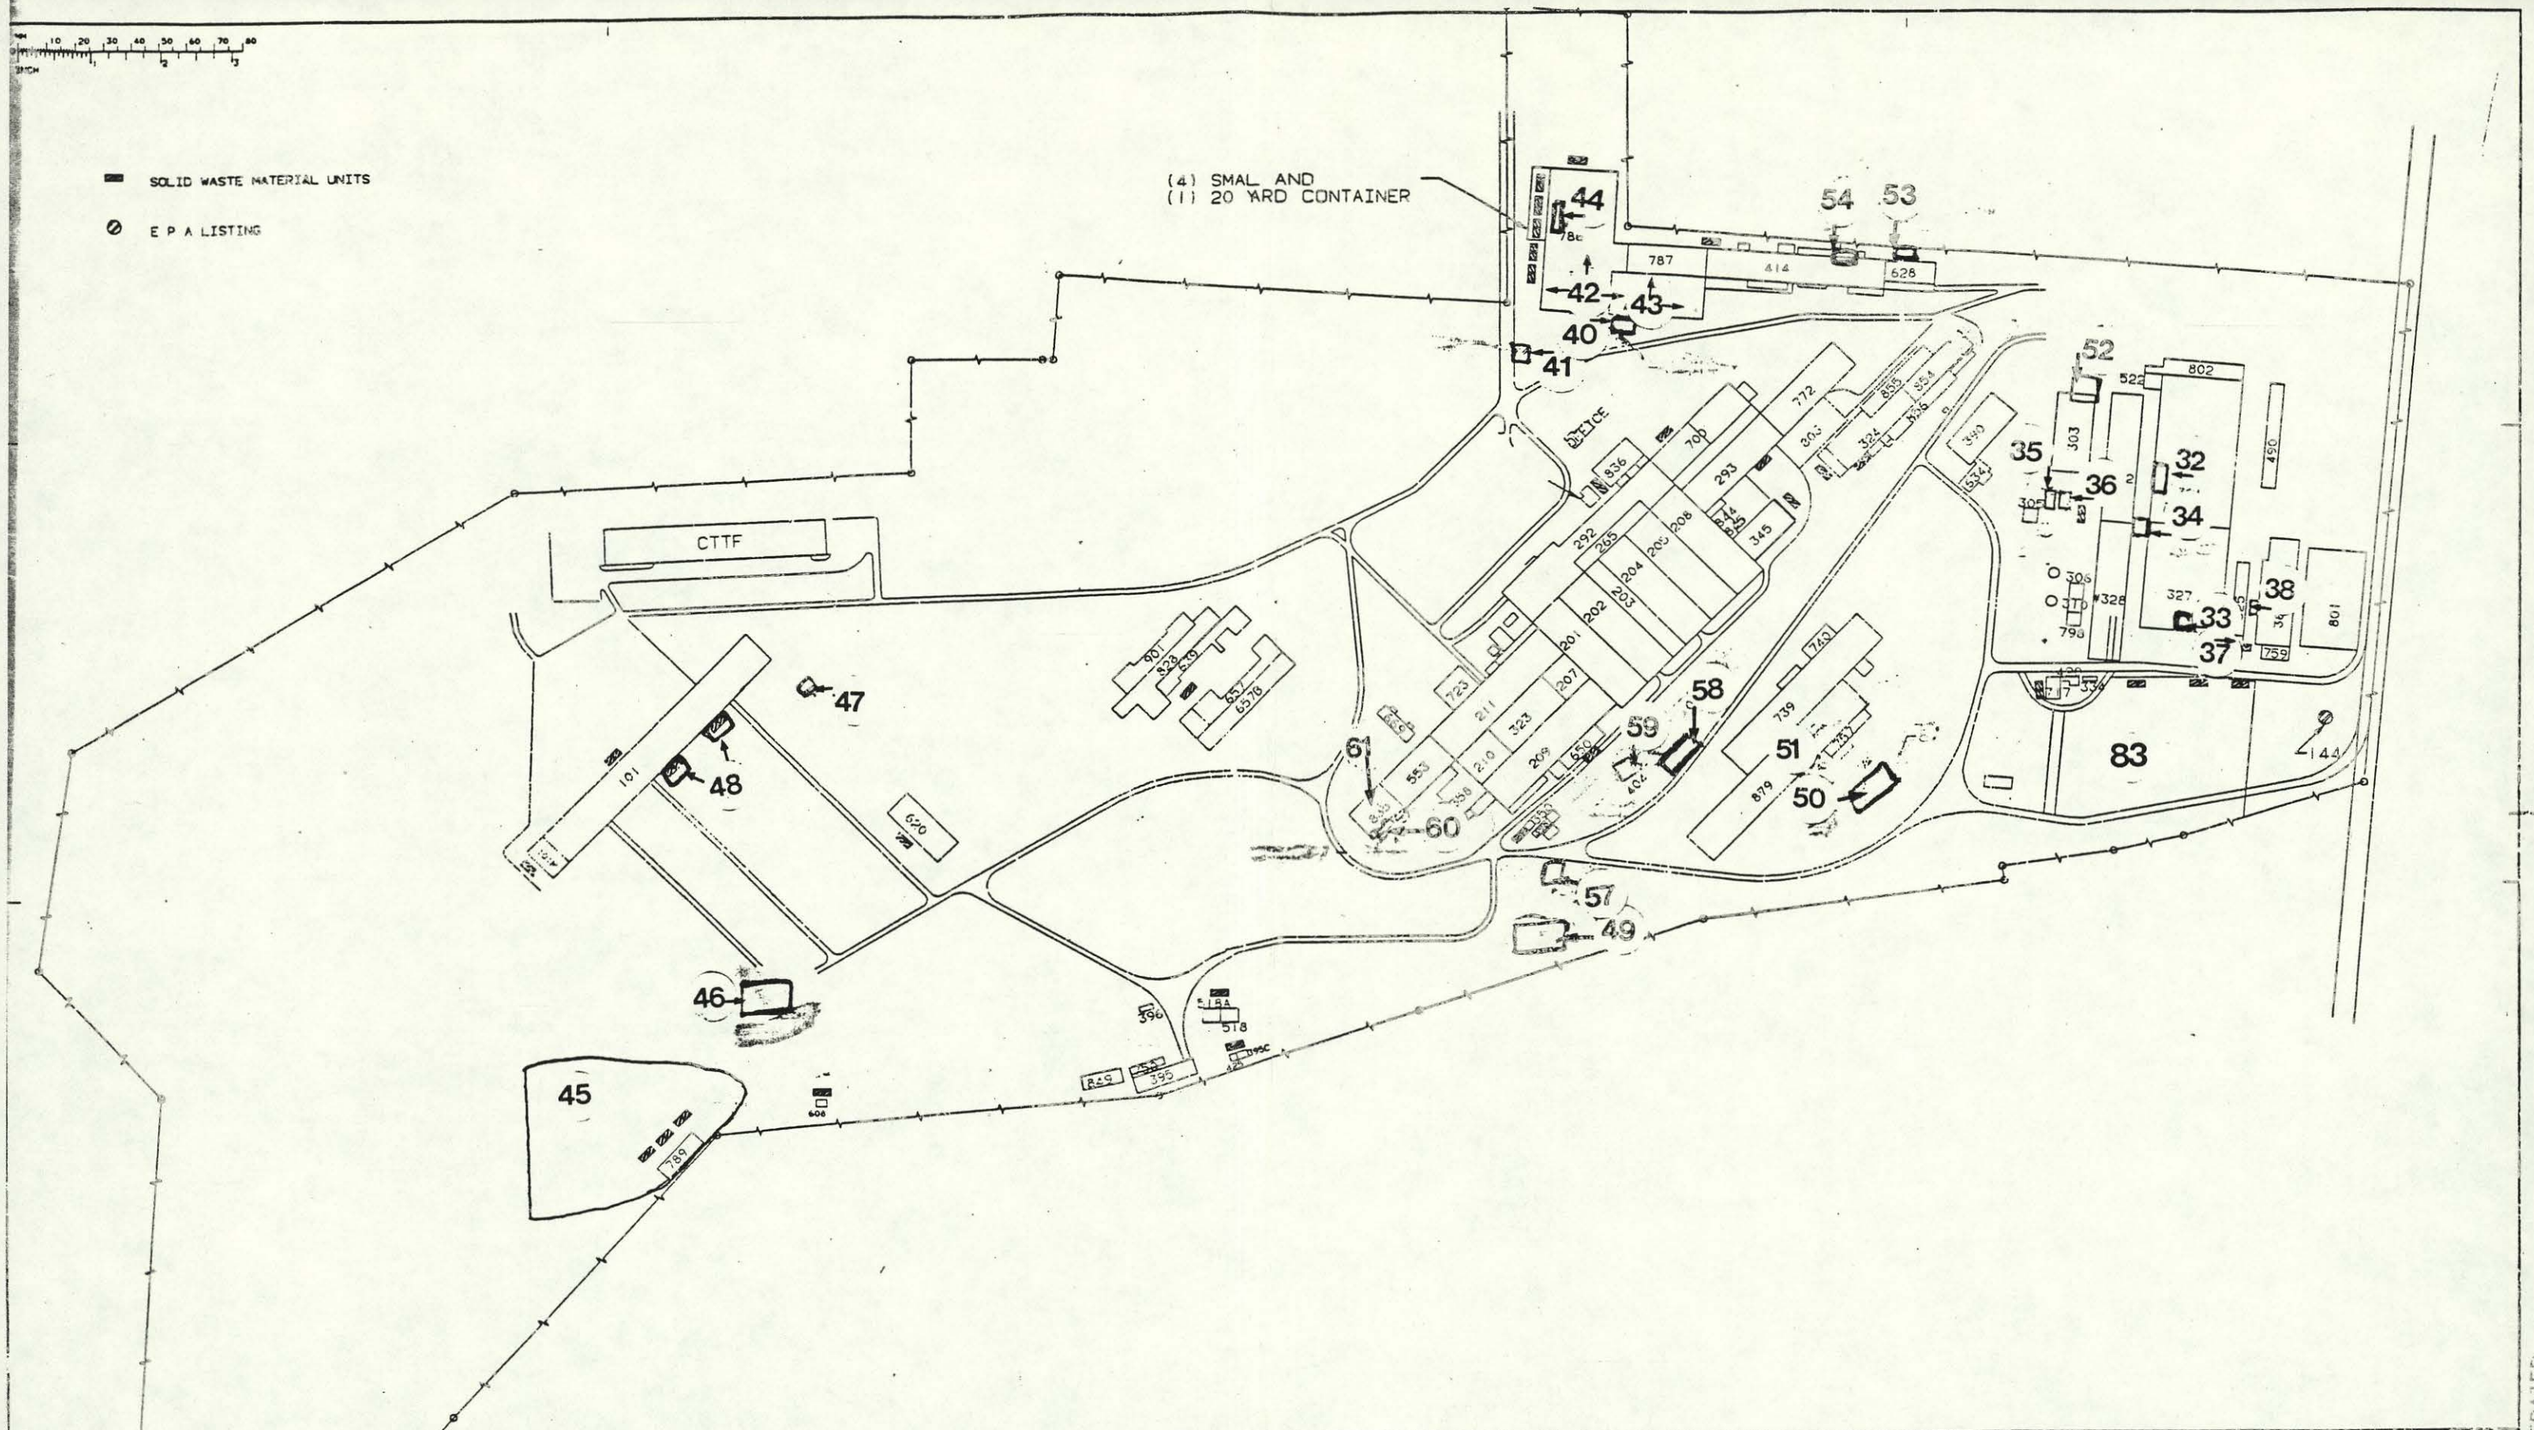

FIGURE B-2 SWMU LOCATION MAP FOR THI GAMBRINUS SECTION OF TIMKEN

SUPERSEDES

TIMKEN

THE TIMKEN COMPANY
CANTON, OHIO, U.S.A.

THIS DRAWING MUST NOT BE COPIED OR REPRODUCED WITHOUT THE CONSENT OF THE TIMKEN COMPANY

E.P.A. SOLID
MATERIAL WASTE UNITS
LAYOUT GAMBRINUS

PITTS

CHECKED

APPROVED

EM-DWG NO

COMPUTER GENERATED