36-10-604

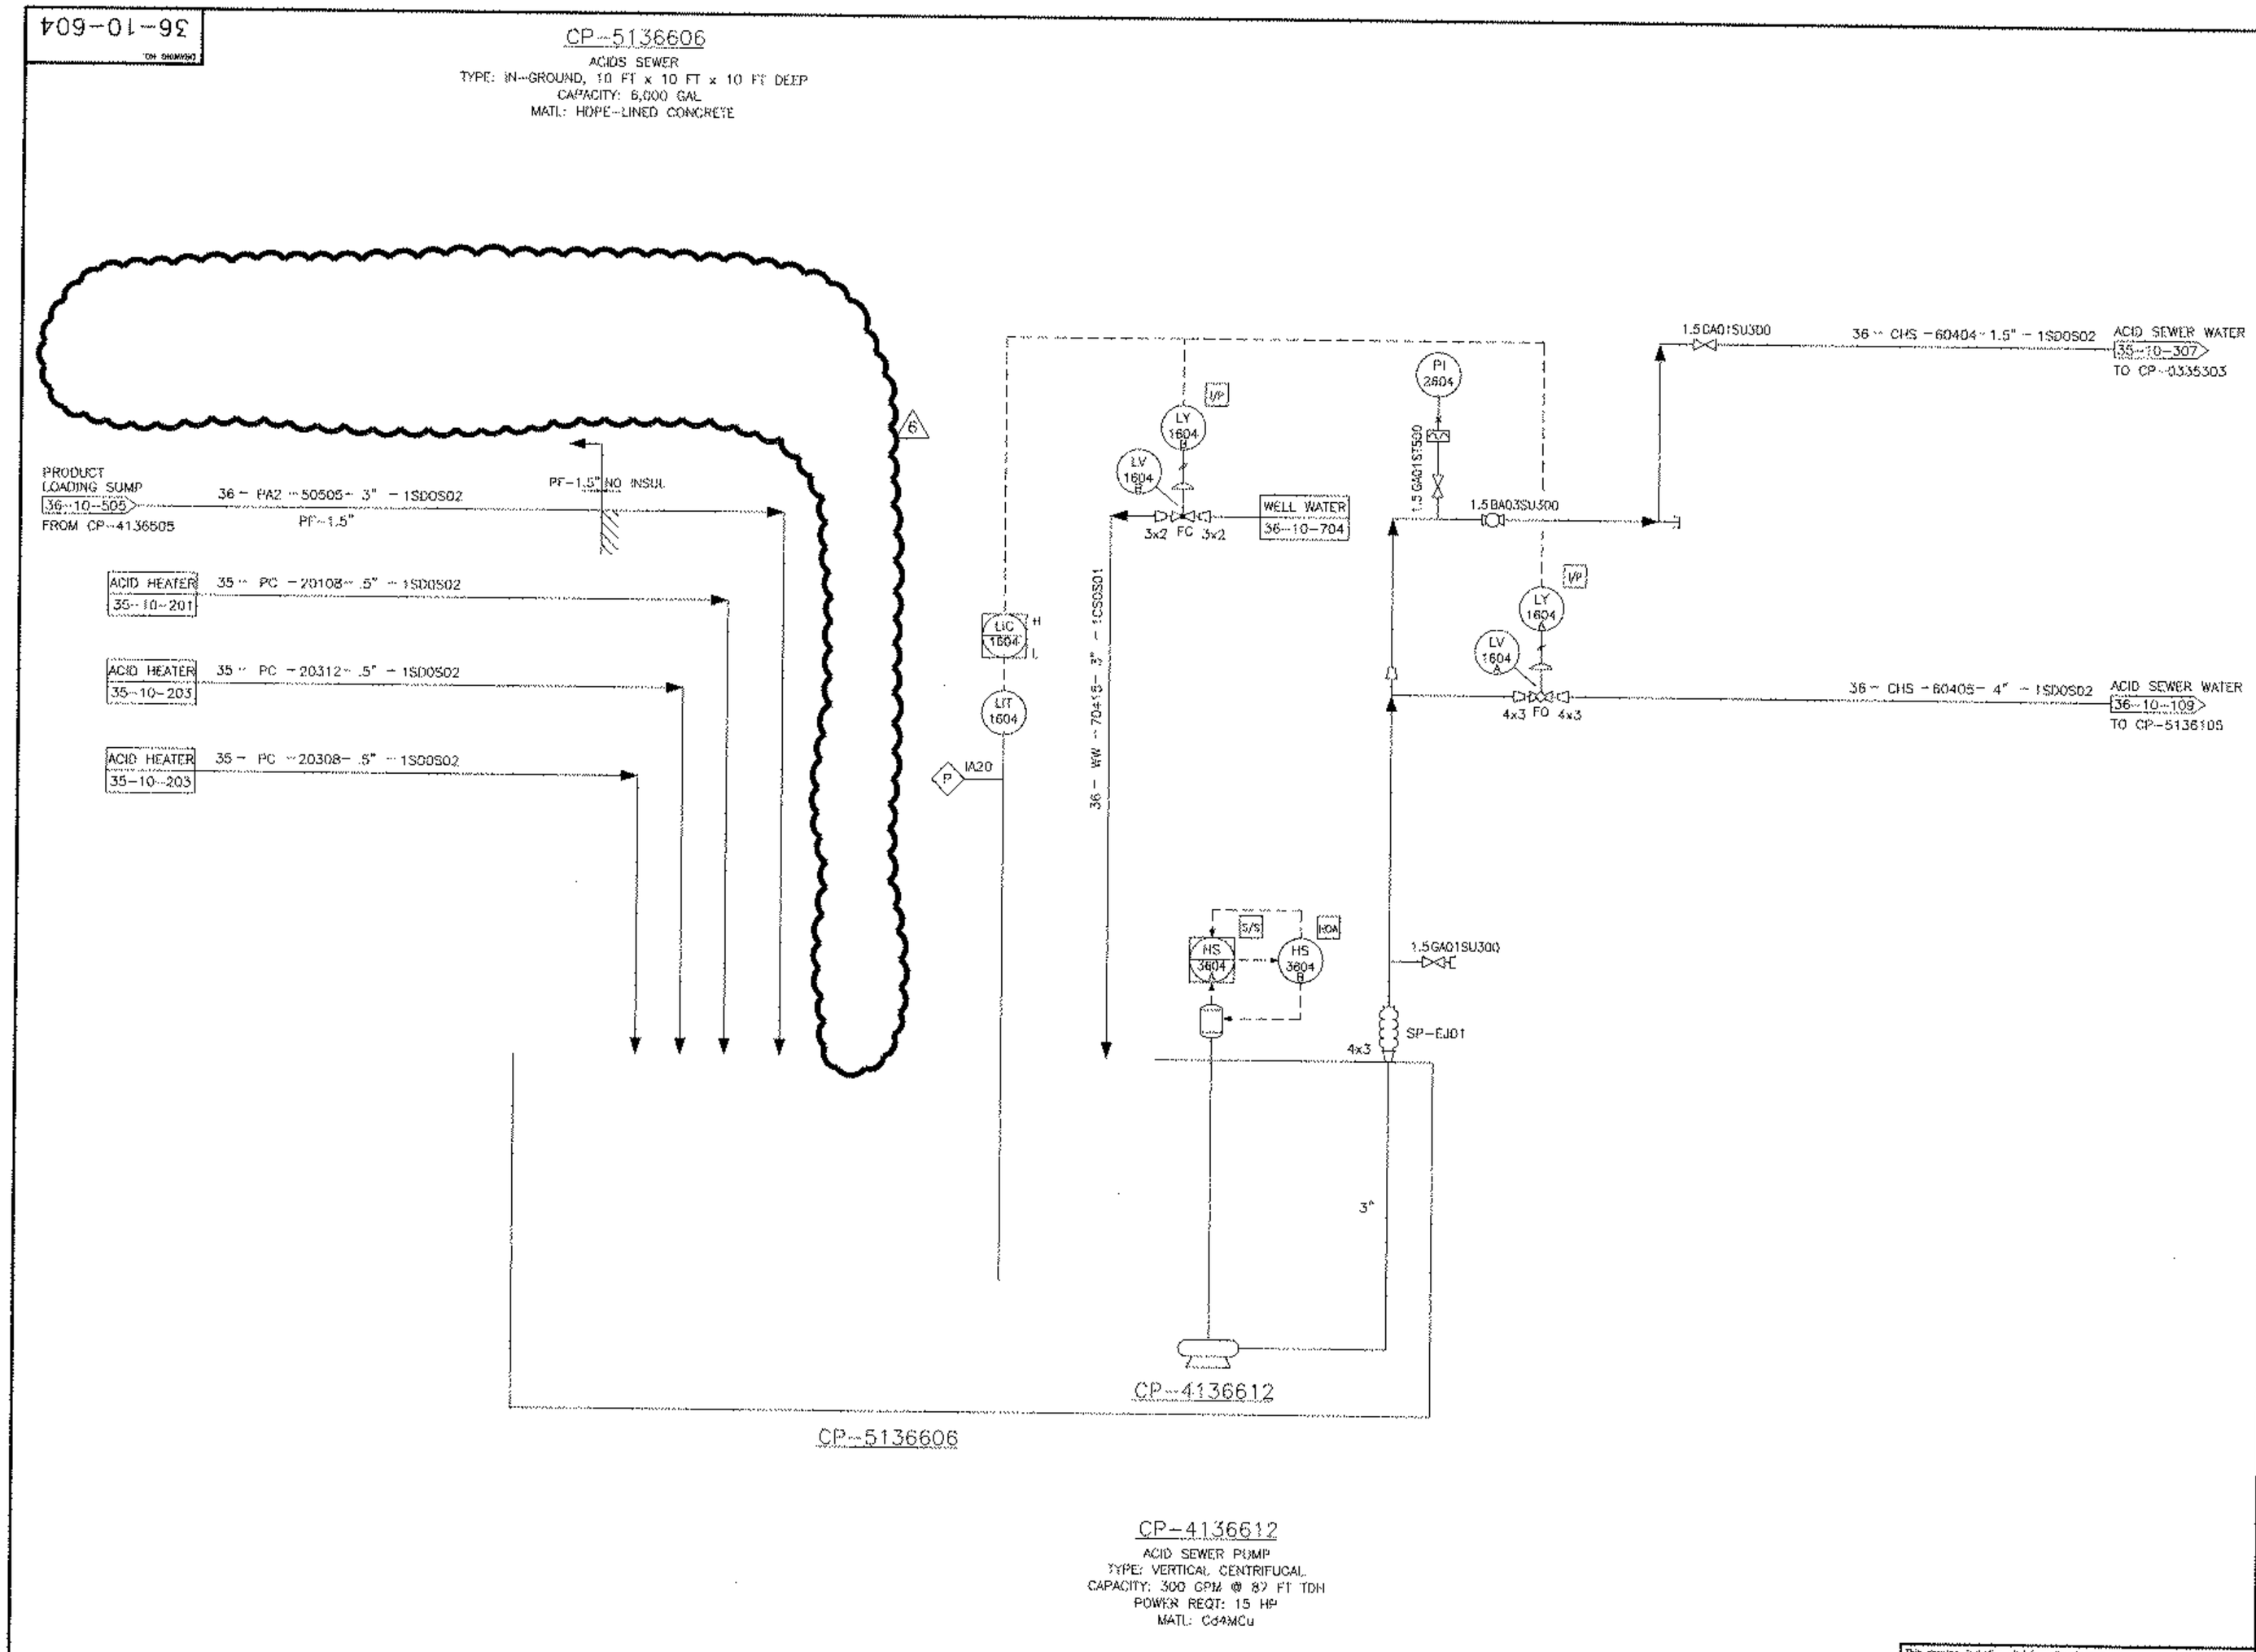

NOTES:

1. FOR GENERAL NOTES AND SYMBOLS, REFER TO DRAWING NOS. 35-10-098, 35-10-099.
2. LOCATE VALVES AS CLOSE TO TEES AS POSSIBLE.

AS BUILT
04/01/03

L#60405

JACOBS ENGINEERING®
Engineers and Constructors
P.O. Box 2008, Lakeland, Florida 33806-2008 • 363 E SR 540, Lakeland Florida 33803
Tel (940) 665-1211 Fax (940) 665-0283

FMC CORPORATION
FES - Princeton, NJ

REV	ZONE	DESCRIPTION	BY	CKD	DATE	APPD	APPD	APPD
6	-	ASBUILT PER ESR 20070	KV	MAG	4/1/03			

REV	ZONE	DESCRIPTION	BY	CKD	DATE	APPD	APPD	APPD
5	-	ASBUILT PROJECT #210062	CGH		3-15-02			
4	-	REISSUE FOR DESIGN, PROJECT #210062	CGH		12/8/01			
3	-	REISSUE FOR DESIGN						
2	-	ISSUE FOR HAZOPS	KP	CGH	5/16/00	JME	ALG	
1	-	REISSUE FOR DESIGN	FH	CGH	2/14/00	JME	ALG	
0	-	ISSUE FOR DESIGN	CGH	JME	10/25/99	JME		

This drawing, including all information thereon, is FMC property, is confidential, and must not be used, made public, or copied unless authorized by FMC. It is subject to return upon demand. FMC Corporation

APPROVED FOR CONSTRUCTION
SIGNATURE DATE
APPROVED FOR CONSTRUCTION
SIGNATURE DATE
APPROVED FOR CONSTRUCTION
SIGNATURE DATE

PROJ. MGR. J. KORETCHKO
CHECKER
DISP. LEAD
ORIGINATOR F. HICKS
DATE: 4/26/99
CAD FILE: 3610604_6

FMC PURIFIED PHOSPHORIC ACID PLANT
AT AGRIUM-CONDA PHOSPHATES
ACIDS SEWER
PIPING & INSTRUMENTATION DIAGRAM

SCALE	ORDER NO.	DRAWING NO.	REV.
NONE	28-T424-10	36-10-604	6

AGR-CBI_003902