36-10-604

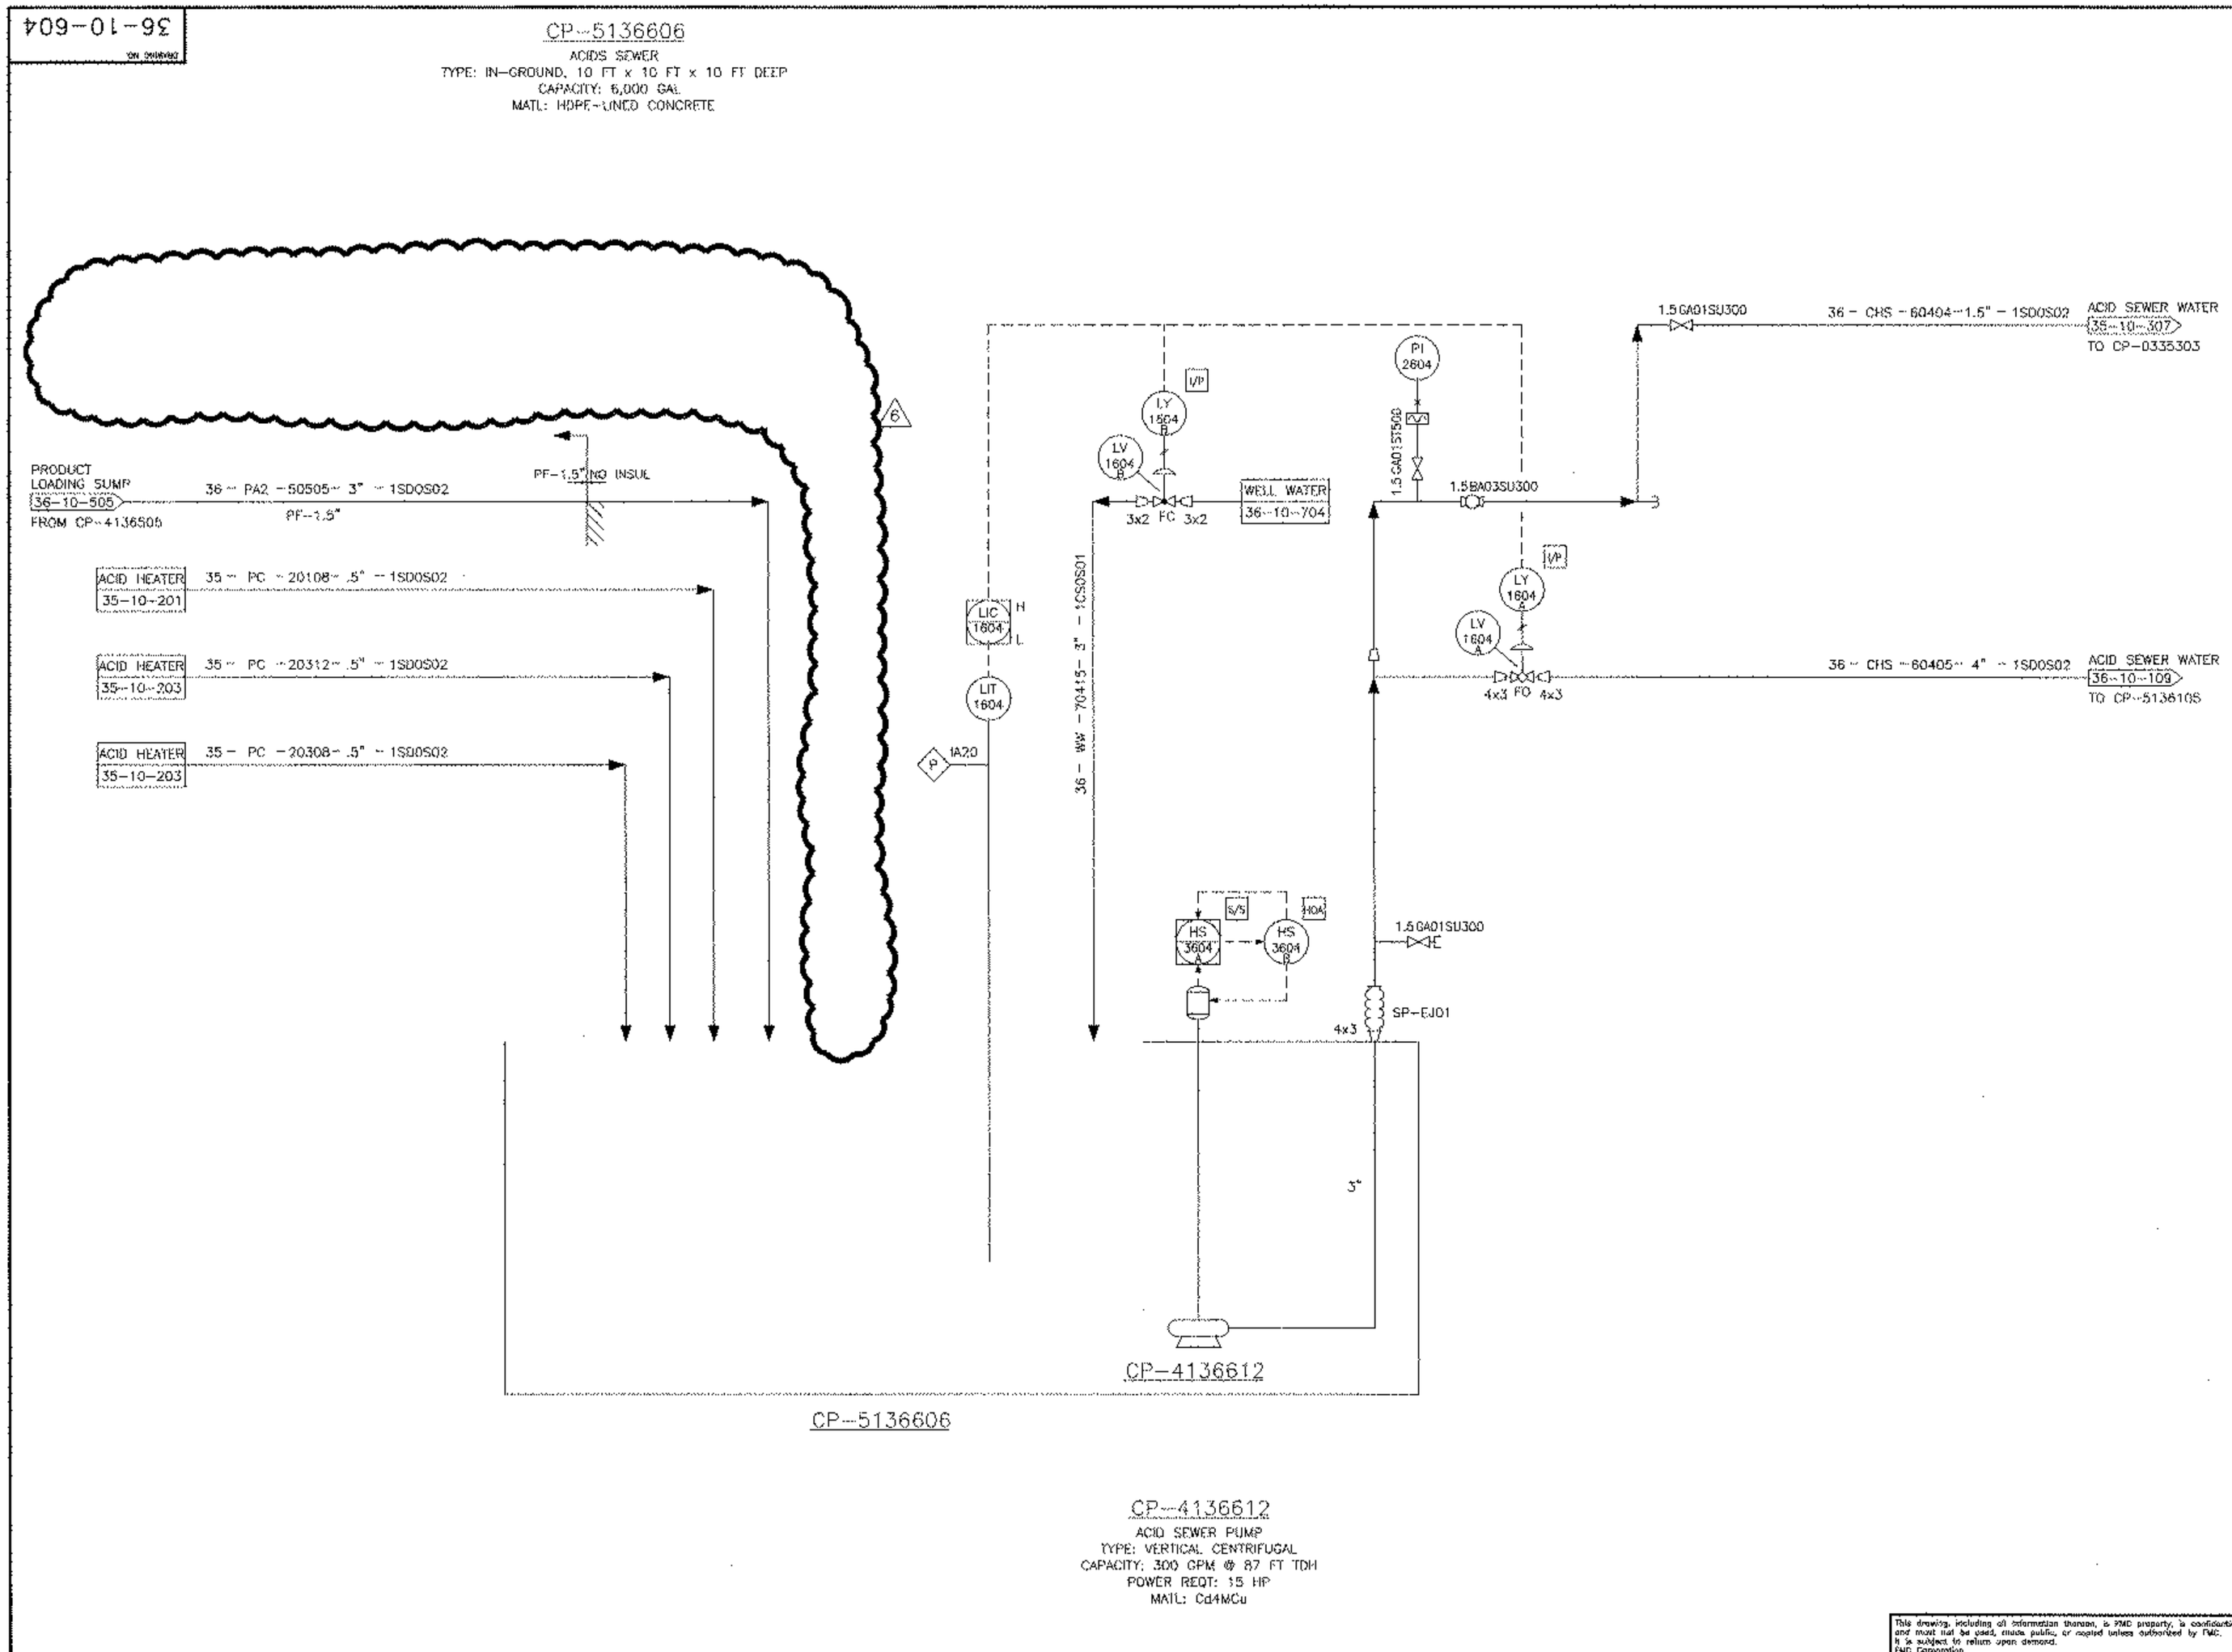

NOTES:

1. FOR GENERAL NOTES AND SYMBOLS, REFER TO DRAWING NOS. 35-10-098, 35-10-099.
2. LOCATE VALVES AS CLOSE TO TEES AS POSSIBLE.

AS BUILT
04/01/03

L#60405

JACOBS ENGINEERING®
Engineers and Constructors
P.O. Box 2008, Lakeland, Florida 33806-2008 Tel: (941) 665-1301
Fax: (941) 665-2023

FMC CORPORATION
FES - Princeton, NJ

This drawing, including all information thereon, is FMC property, is confidential, and must not be used, made public, or copied unless authorized by FMC. It is subject to return upon demand. FMC Corporation

REV	ZONE	DESCRIPTION	BY	CKD	DATE	APPD	APPD	APPD
8	–	ASBUILT PER ESR 20070	KV	MAG	4/1/03			

REV	ZONE	DESCRIPTION	BY	CKD	DATE	APPD	APPD	APPD
5	–	ASBUILT PROJECT #210062	CGH		3-15-02			
4	–	REISSUE FOR DESIGN, PROJECT #210062	CGH		12/8/01			
3	–	REISSUE FOR DESIGN						
2	–	ISSUE FOR HAZOPS	KP	CGH	5/16/00	JME	ALG	
1	–	REISSUE FOR DESIGN	FH	CGH	2/14/00	JME	ALG	
0	–	ISSUE FOR DESIGN	CGH	JME	10/25/99	JME		

APPROVED FOR CONSTRUCTION
SIGNATURE DATE
APPROVED FOR CONSTRUCTION
SIGNATURE DATE
APPROVED FOR CONSTRUCTION
SIGNATURE DATE

PROJ. MGR.: J. KORETCHKO
CHECKER:
DISP. LEAD:
ORIGINATOR: F. HICKS
DATE: 4/26/99
CAD FILE: 3610604_6

FMC PURIFIED PHOSPHORIC ACID PLANT
AT AGRIUM-CONDA PHOSPHATES
ACIDS SEWER
PIPING & INSTRUMENTATION DIAGRAM

SCALE	ORDER NO.	DRAWING NO.	REV.
NONE	28-T424-10	36-10-604	6

EXHIBIT B

AGR-CBI_003902
SUBJECT TO ALL APPLICABLE CONFIDENTIAL
BUSINESS INFORMATION PRIVILEGES