36-10-616

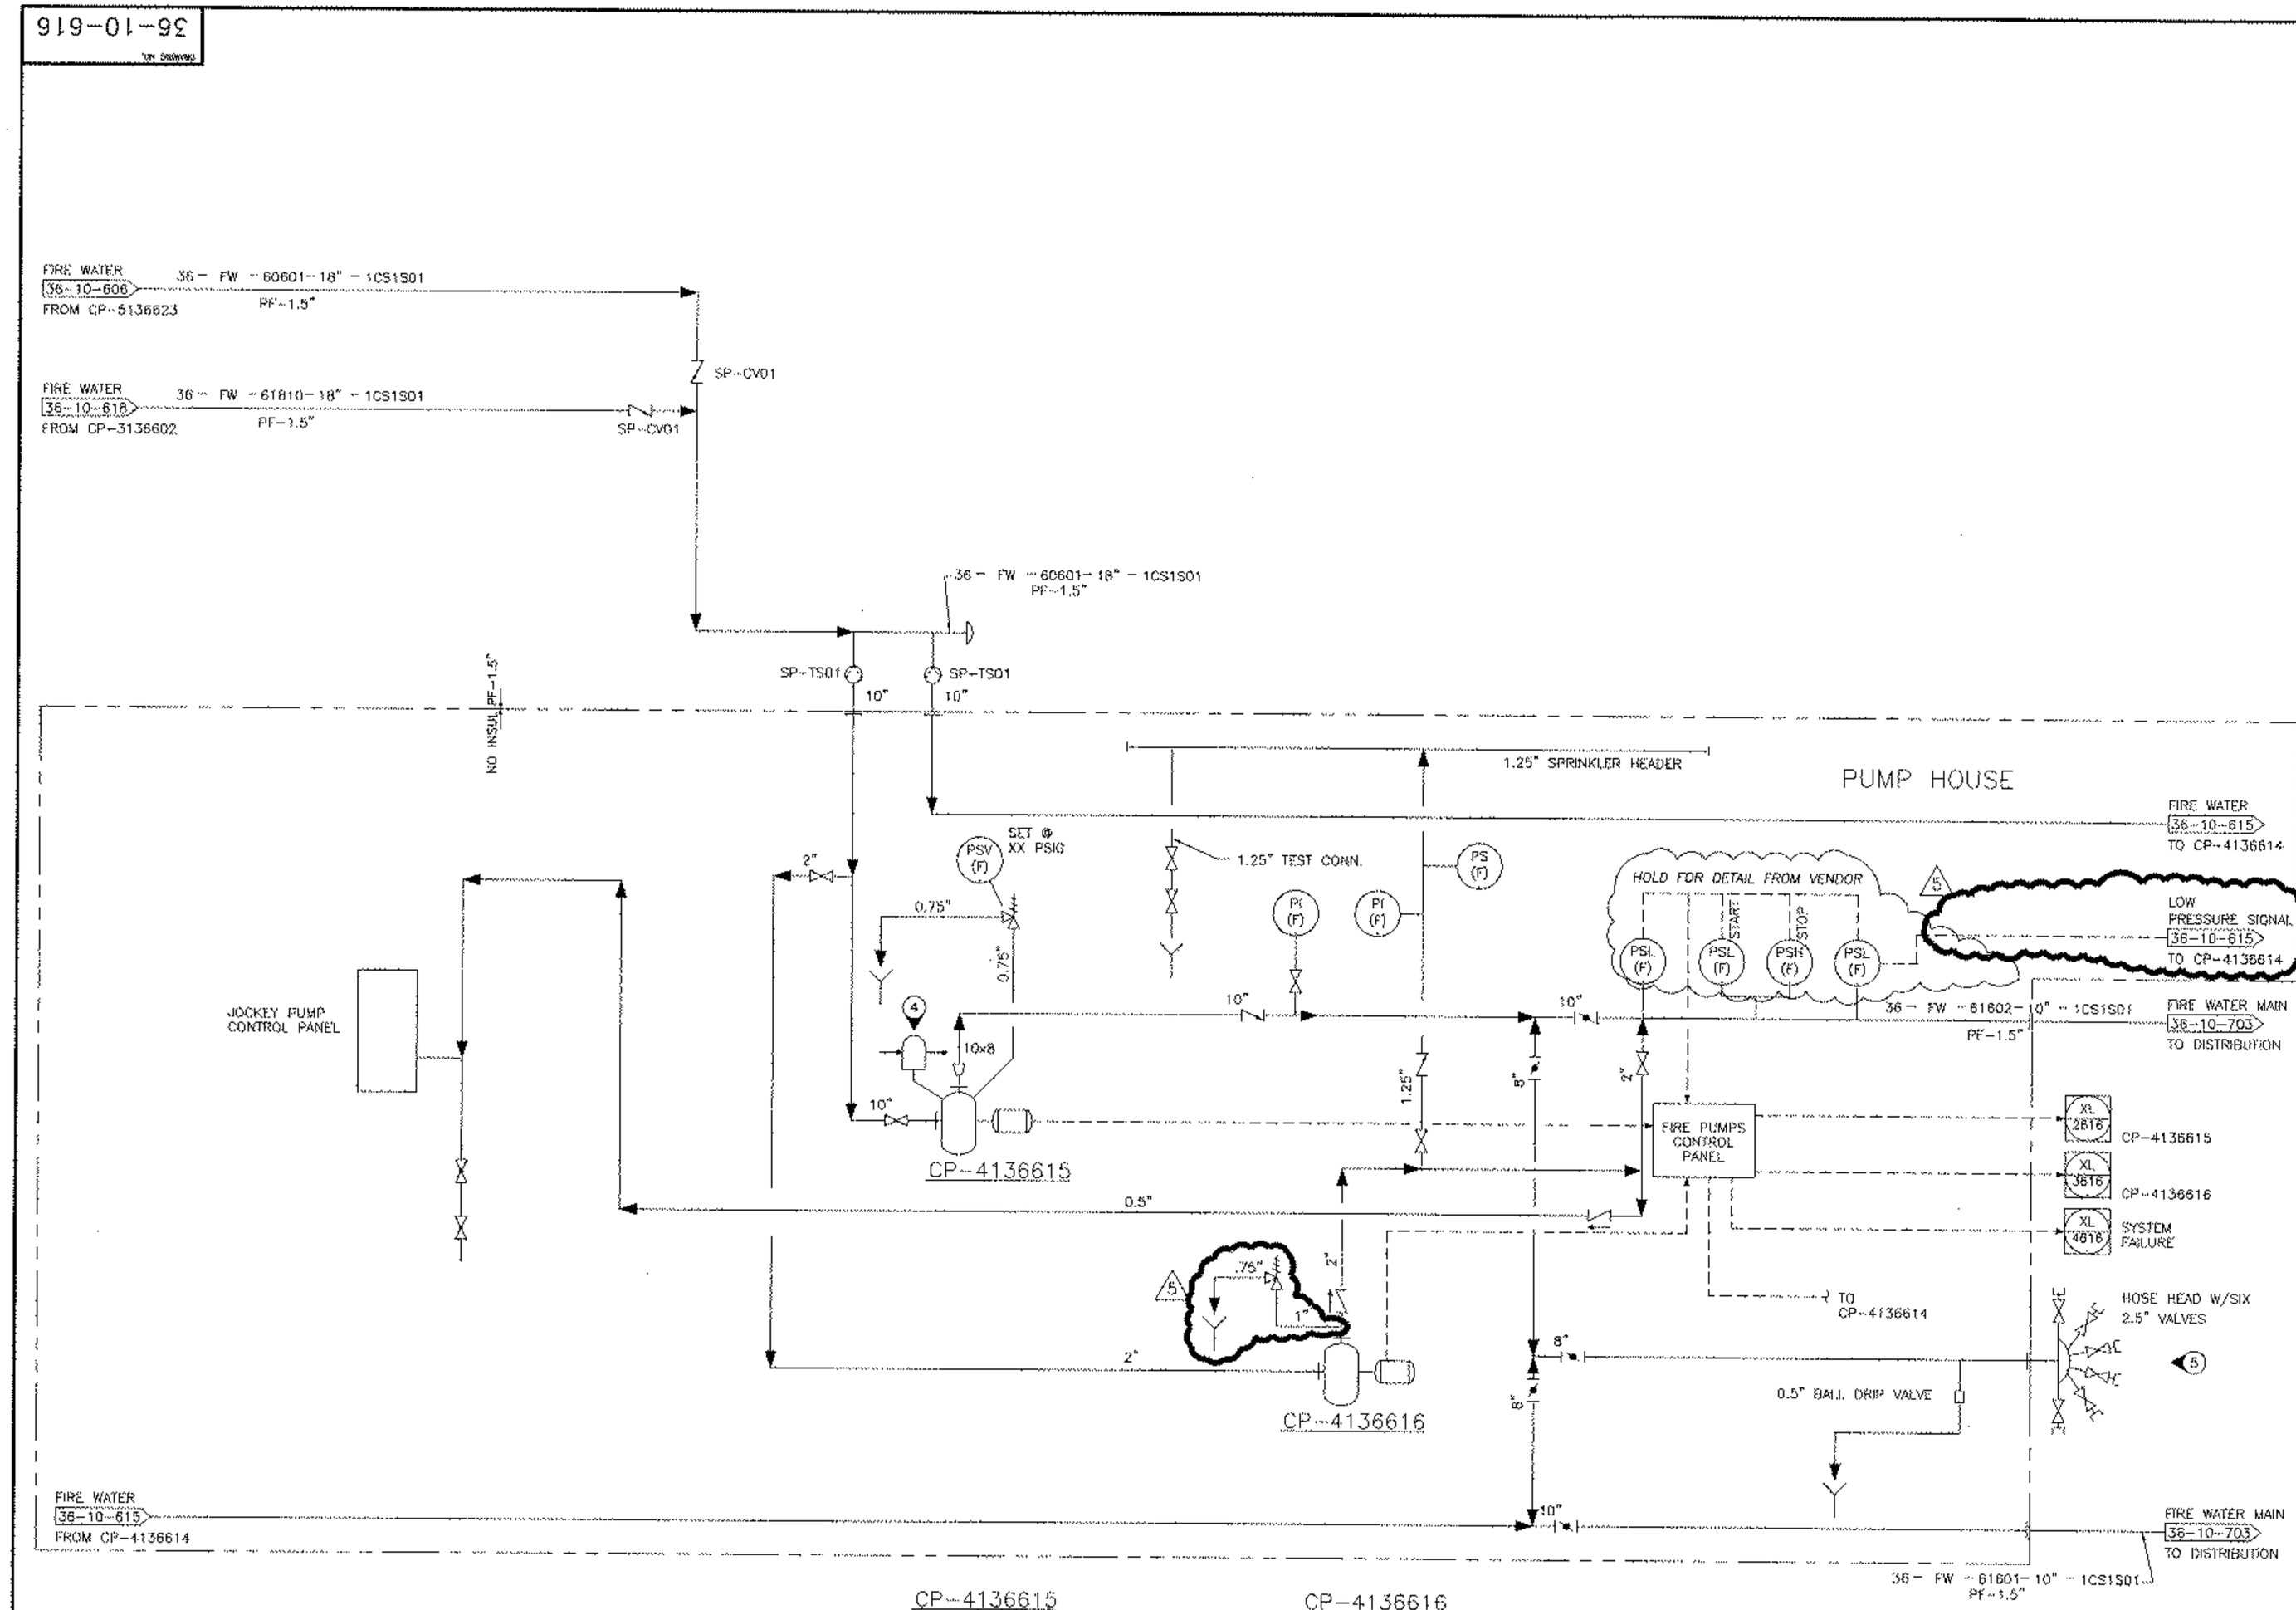

CP-4136615
FIRE WATER PUMP
CAPACITY: 2000 GPM @ 300 FT TDH
POWER REQT: 250 HP
MATL: DUCTILE IRON

CP-4136616
FIRE WATER JOCKEY PUMP
CAPACITY: 50 GPM @ 300 FT TDH
POWER REQT: 10HP
MATL: DUCTILE IRON

NOTES:

1. FOR GENERAL NOTES AND SYMBOLS, REFER TO DRAWING NOS. 35-10-098, 35-10-099
2. LOCATE VALVES AS CLOSE TO TEES AS POSSIBLE.
3. SUCTION AND DISCHARGE PIPING TO BE LOCATED BELOW FROST LINE.
4. LOCATE AUTOMATIC AIR RELEASE VALVE AT HIGHEST POINT IN THE DISCHARGE LINE BETWEEN PUMP AND CHECK VALVE.
5. FURNISH BY FIRE HOUSE CONTRACT, SHIP LOOSE FOR FIELD INSTALLATION.

AS BUILT
02/08/03

L#61612

JACOBS ENGINEERING
Engineers and Constructors
P.O. Box 2008, Lakeland, Florida 33806-2008 Fax (941) 665-3363

FMC CORPORATION
FES - Princeton, NJ

REV	ZONE	DESCRIPTION	BY	CKD	DATE	APPD	APPD	APPD
5	-	AS BUILT PER SDS 2001 WALK-DOWN	JH	MAG	2/8/03			
4	-	REISSUE FOR DESIGN	KP	JWH	10/13/00			
3	-	REISSUE FOR DESIGN	KP	JWH	8/28/00	JME	LE/ALG	
2	-	ISSUE FOR HAZOPS	KP	CGH	5/16/00	JME	ALG	
1	-	REISSUE FOR DESIGN	FH	CGH	2/16/00	JME	ALG	
0	-	ISSUE FOR DESIGN	CGH	JME	10/25/99	JME		

This drawing, including all information thereon, is FMC property, or confidential, and must not be used, made public, or copied unless authorized by FMC. It is subject to return upon demand. FMC Corporation

APPROVED FOR CONSTRUCTION
SIGNATURE DATE
APPROVED FOR CONSTRUCTION
SIGNATURE DATE
APPROVED FOR CONSTRUCTION
SIGNATURE DATE

PROJ. MGR.: J. KORETCHKO
CHECKER:
DISP. LEAD:
DESIGNATION: F. HICKS
DATE: 3/31/99
CAD FILE: 3610616_5

FMC PURIFIED PHOSPHORIC ACID PLANT AT AGRIUM-CONDA PHOSPHATES FIRE WATER PUMPS PIPING AND INSTRUMENTATION DIAGRAM

SCALE	ORDER NO.	DRAWING NO.	REV.
NONE	28-T424-10	36-10-616	5

EXHIBIT B

AGR-CBI_003903
SUBJECT TO ALL APPLICABLE CONFIDENTIAL