36-10-616

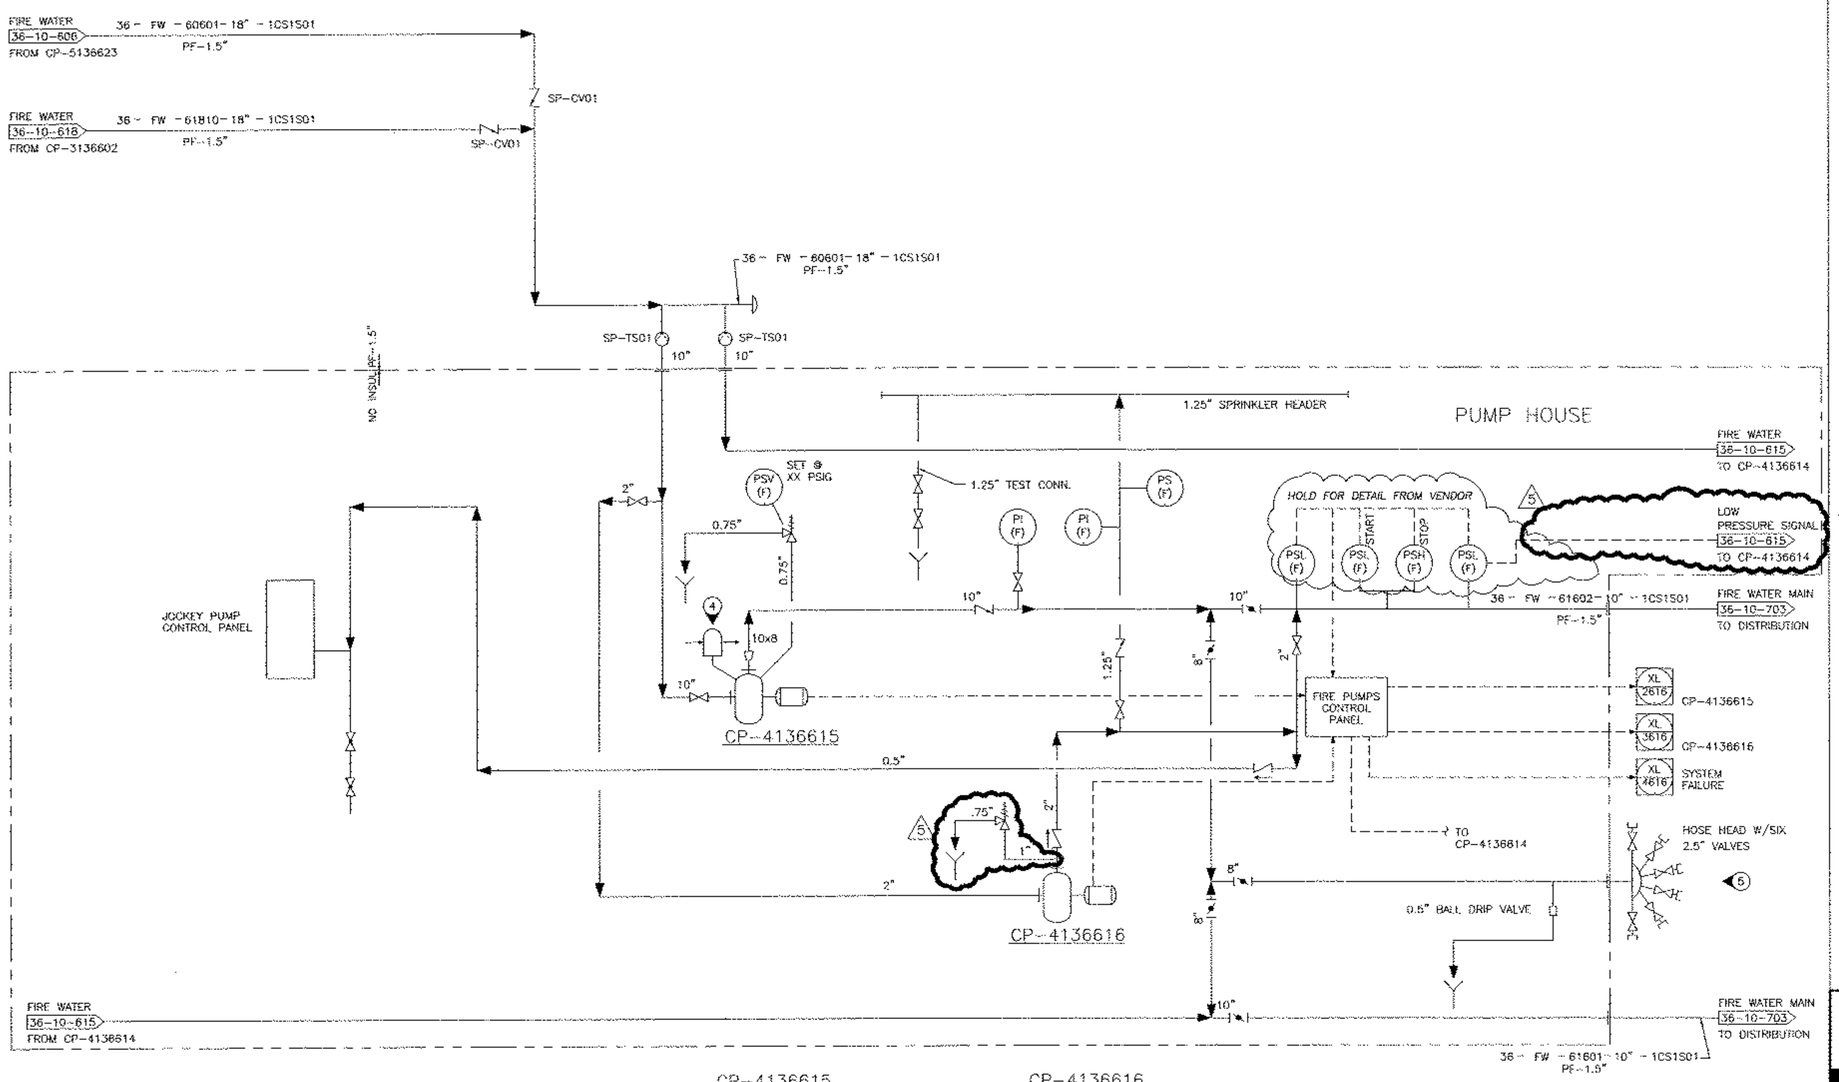

CP-4136615
FIRE WATER PUMP
CAPACITY: 2000 GPM @ 300 FT TDH
POWER REQT: 250 HP
MATL: DUCTILE IRON

CP-4136616
FIRE WATER JOCKEY PUMP
CAPACITY: 50 GPM @ 300 FT TDH
POWER REQT: 10HP
MATL: DUCTILE IRON

NOTES:

1. FOR GENERAL NOTES AND SYMBOLS, REFER TO DRAWING NOS. 35-10-098, 35-10-099
2. LOCATE VALVES AS CLOSE TO TEES AS POSSIBLE.
3. SUCTION AND DISCHARGE PIPING TO BE LOCATED BELOW FROST LINE.
4. LOCATE AUTOMATIC AIR RELEASE VALVE AT HIGHEST POINT IN THE DISCHARGE LINE BETWEEN PUMP AND CHECK VALVE.
5. FURNISH BY FIRE HOUSE CONTRACT, SHIP LOOSE FOR FIELD INSTALLATION.

AS BUILT
02/08/03

L#61612

JACOBS ENGINEERING®
Engineers and Constructors
P.O. Box 2019, Lakeland, Florida 33806-2019; 905 P SR 540, Lakeland Florida 33813
Tel (941) 665-1511 Fax (941) 665-3005

FMC CORPORATION
FES - Princeton, NJ

This drawing, including all information thereon, is FMC property, is confidential, and must not be used, made public, or copied unless authorized by FMC. It is subject to return upon demand. FMC Corporation

REV	ZONE	DESCRIPTION	BY	CKD	DATE	APPD	APPD	APPD
5	–	AS BUILT PER SDS 2001 WALK-DOWN	JH	MAG	2/8/03			
4	–	REISSUE FOR DESIGN	KP	JWH	10/13/00			
3	–	REISSUE FOR DESIGN	KP	JWH	8/28/00	JME	LE/ALG	
2	–	ISSUE FOR HAZOPS	KP	CGH	5/16/00	JME	ALG	
1	–	REISSUE FOR DESIGN	FH	CGH	2/16/00	JME	ALG	
0	–	ISSUE FOR DESIGN	CGH	JME	10/25/99	JME		

APPROVED FOR CONSTRUCTION
SIGNATURE DATE
APPROVED FOR CONSTRUCTION
SIGNATURE DATE
APPROVED FOR CONSTRUCTION
SIGNATURE DATE

FMC PROJ. MGR: J. KURETCHKO
CHECKER:
DISP. LEAD
DESIGNATOR: F. HICKS
DATE: 3/31/99
CAD FILE: 3610616_5

FMC PURIFIED PHOSPHORIC ACID PLANT
AT AGRIUM-CONDA PHOSPHATES
FIRE WATER PUMPS
PIPING AND INSTRUMENTATION DIAGRAM

SCALE	ORDER NO.	DRAWING NO.	REV.
NONE	28-T424-10	36-10-616	5

EXHIBIT B

AGR-CBI_003903
SUBJECT TO ALL APPLICABLE CONFIDENTIAL BUSINESS INFORMATION PRIVILEGES