DRAWING NO. 36-10-617

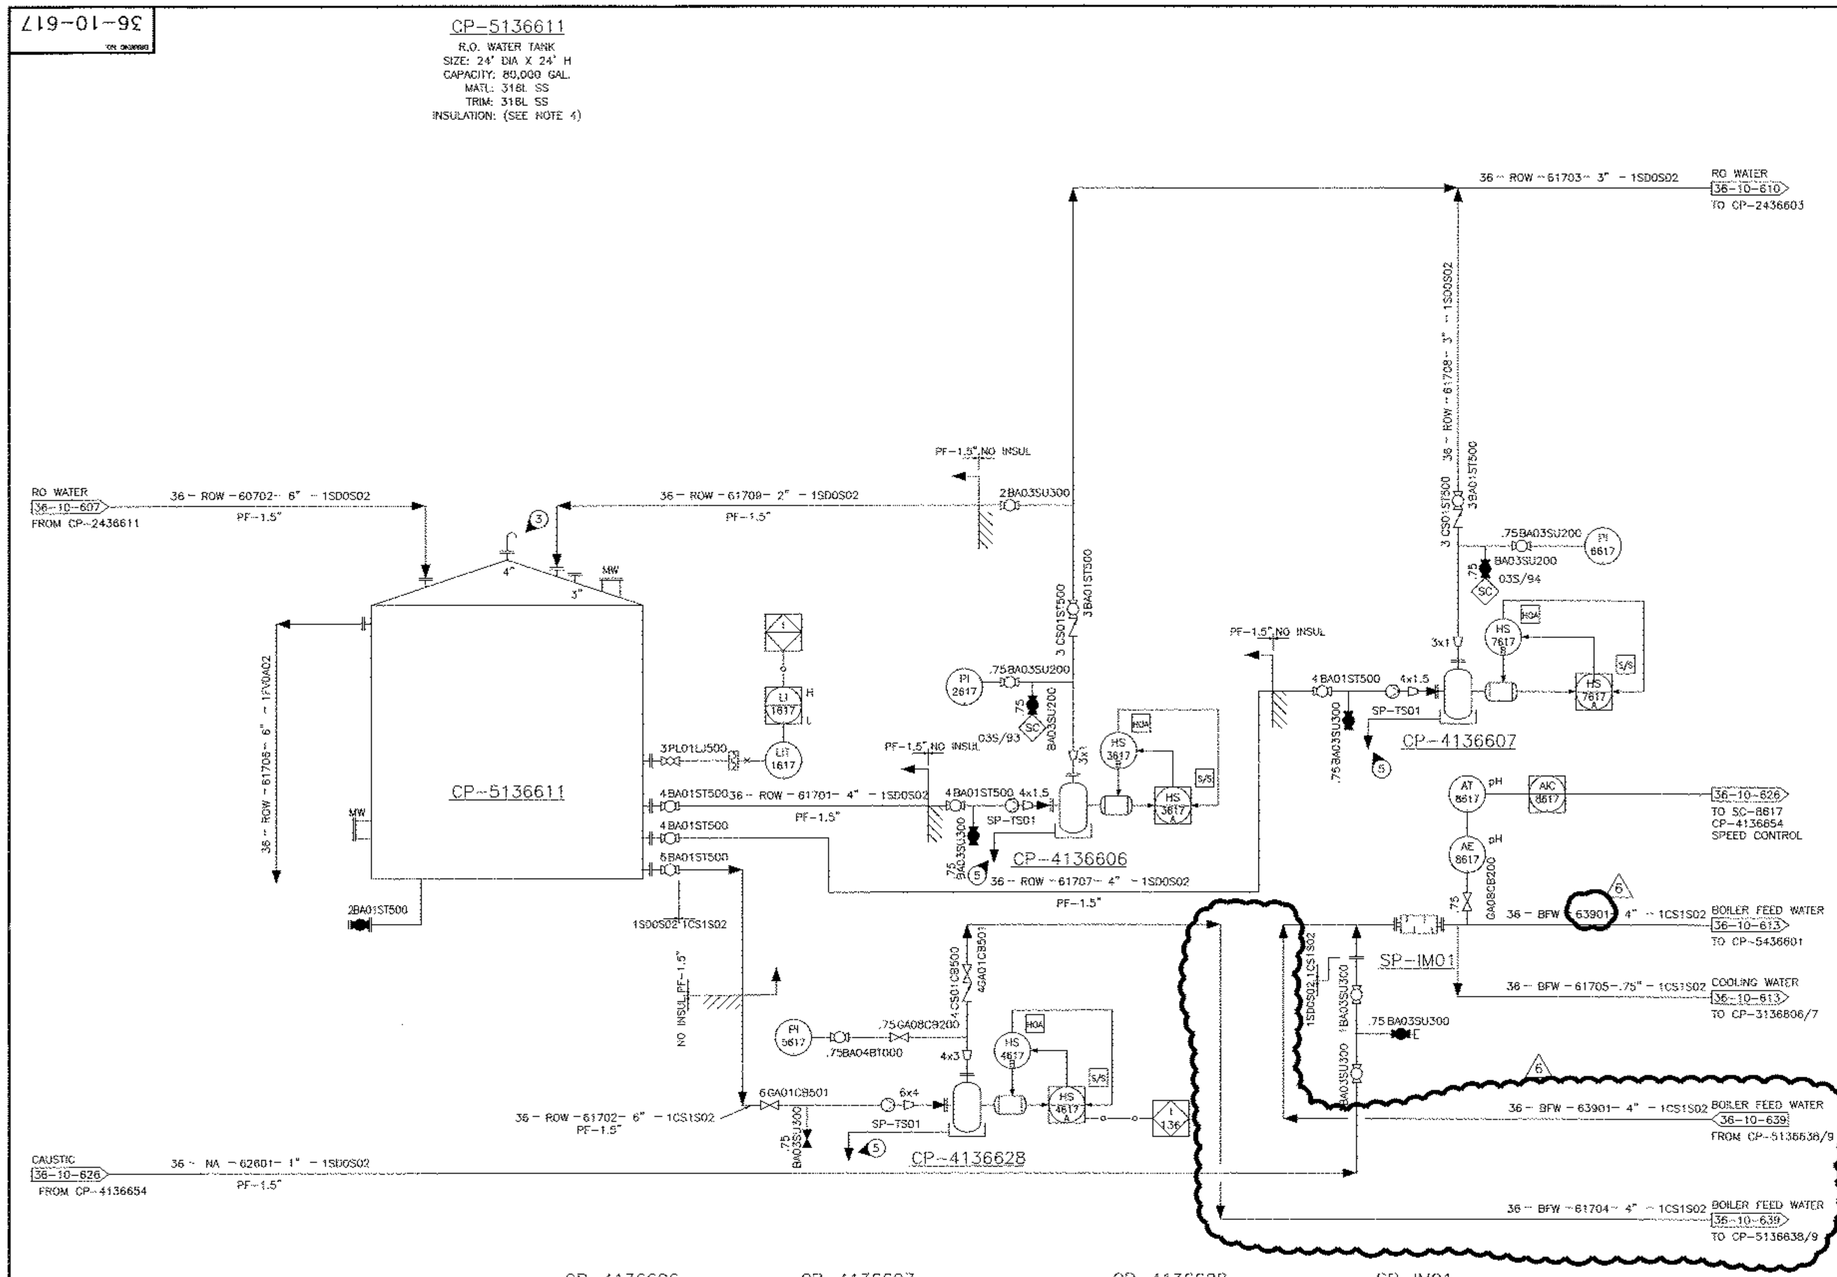

NOTES:

1. FOR GENERAL NOTES AND SYMBOLS, REFER TO DRAWING NOS. 35-10-098, 35-10-099.
2. LOCATE VALVES AS CLOSE TO TEES AS POSSIBLE.
3. PROVIDE W/BIRD SCREEN.
4. PF-1.5" INSULATION AND ELECTRICAL TRACING AT ALL SIDEWALL NOZZLES EXCEPT OVERFLOW AND MANWAYS FOR A RADIUS OF 2 FT. AROUND NOZZLE.
5. 1" DRAIN FROM PUMP DRAIN PAN TO SLAB (SPEC. 1SD0S02)

INTERLOCKS

- I-136 CP-4136628 SHUTDOWN STOPS CP-4136654.

AS BUILT
04/18/03

L#61709

CP-4136606
(WEST) PROCESS WATER PUMP
TYPE: HORIZONTAL CENTRIFUGAL
CAPACITY: 150 GPM @ 177 FT TDH
POWER REQD: 15 HP
MATL: 316 SS

CP-4136607
(EAST) PROCESS WATER PUMP
TYPE: HORIZONTAL CENTRIFUGAL
CAPACITY: 150 GPM @ 177 FT TDH
POWER REQD: 15HP
MATL: 316 SS

CP-4136628
CONDENSATE MAKEUP PUMP
TYPE: HORIZONTAL CENTRIFUGAL
CAPACITY: 350 GPM @ 83 FT TDH
POWER REQD: 15 HP
MATL: DI

SP-IM01
IN-LINE MIXER

REV	ZONE	DESCRIPTION	BY	CKD	DATE	APPD	APPD	APPD
6	–	AS BUILT PER ESR 20009	KV	MAG	4/18/03			
5	–	AS BUILT PER SDS 2001 WALK-DOWN	JH	MAG	2/8/03			
4	–	REISSUE FOR DESIGN	KP	JWH	10/13/00			
3	–	REISSUE FOR DESIGN	KP	JWH	8/28/00	JME	LE/ALG	
2	–	ISSUE FOR HAZOPS	KP	CGH	5/16/00	JME	ALG	
1	–	REISSUE FOR DESIGN	FH	CGH	2/14/00	JME	ALG	
0	–	ISSUE FOR DESIGN	CGH	JME	10/25/99	JME		

This drawing, including all information thereon, is FMC property, is confidential, and must not be used, made public, or copied unless authorized by FMC. It is subject to return upon demand. FMC Corporation

APPROVED FOR CONSTRUCTION — SIGNATURE — DATE
APPROVED FOR CONSTRUCTION — SIGNATURE — DATE
APPROVED FOR CONSTRUCTION — SIGNATURE — DATE

DRAWN BY: J. KORETCHKO
CHECKED:
DISP. LEAD:
ORIGINATOR: F. HICKS
DATE: 4/28/99
CAD FILE: 3610617_6

JACOBS ENGINEERING®
Engineers and Constructors
P.O. Box 2008, Lakeland, Florida 33802-2008 — 932 E 5th St, Lakeland Florida 33801
Tel (941) 665-2511 Fax (941) 665-2582

FMC CORPORATION
FES – Princeton, NJ

FMC PURIFIED PHOSPHORIC ACID PLANT
AT AGRIUM-CONDA PHOSPHATES
R.O. WATER FEED SYSTEM
PIPING & INSTRUMENTATION DIAGRAM

SCALE	ORDER NO.	DRAWING NO.	REV.
NONE	28-T424-10	36-10-617	6

EXHIBIT B

AGR-CBI_003904
SUBJECT TO ALL APPLICABLE CONFIDENTIAL BUSINESS INFORMATION PRIVILEGES