36-10-620

CP-1036602
INSTRUMENT AIR COMPRESSOR
PRESS: 500 SCFM @ 115 PSIG
MATL: CS
POWER REQT: 200 HP

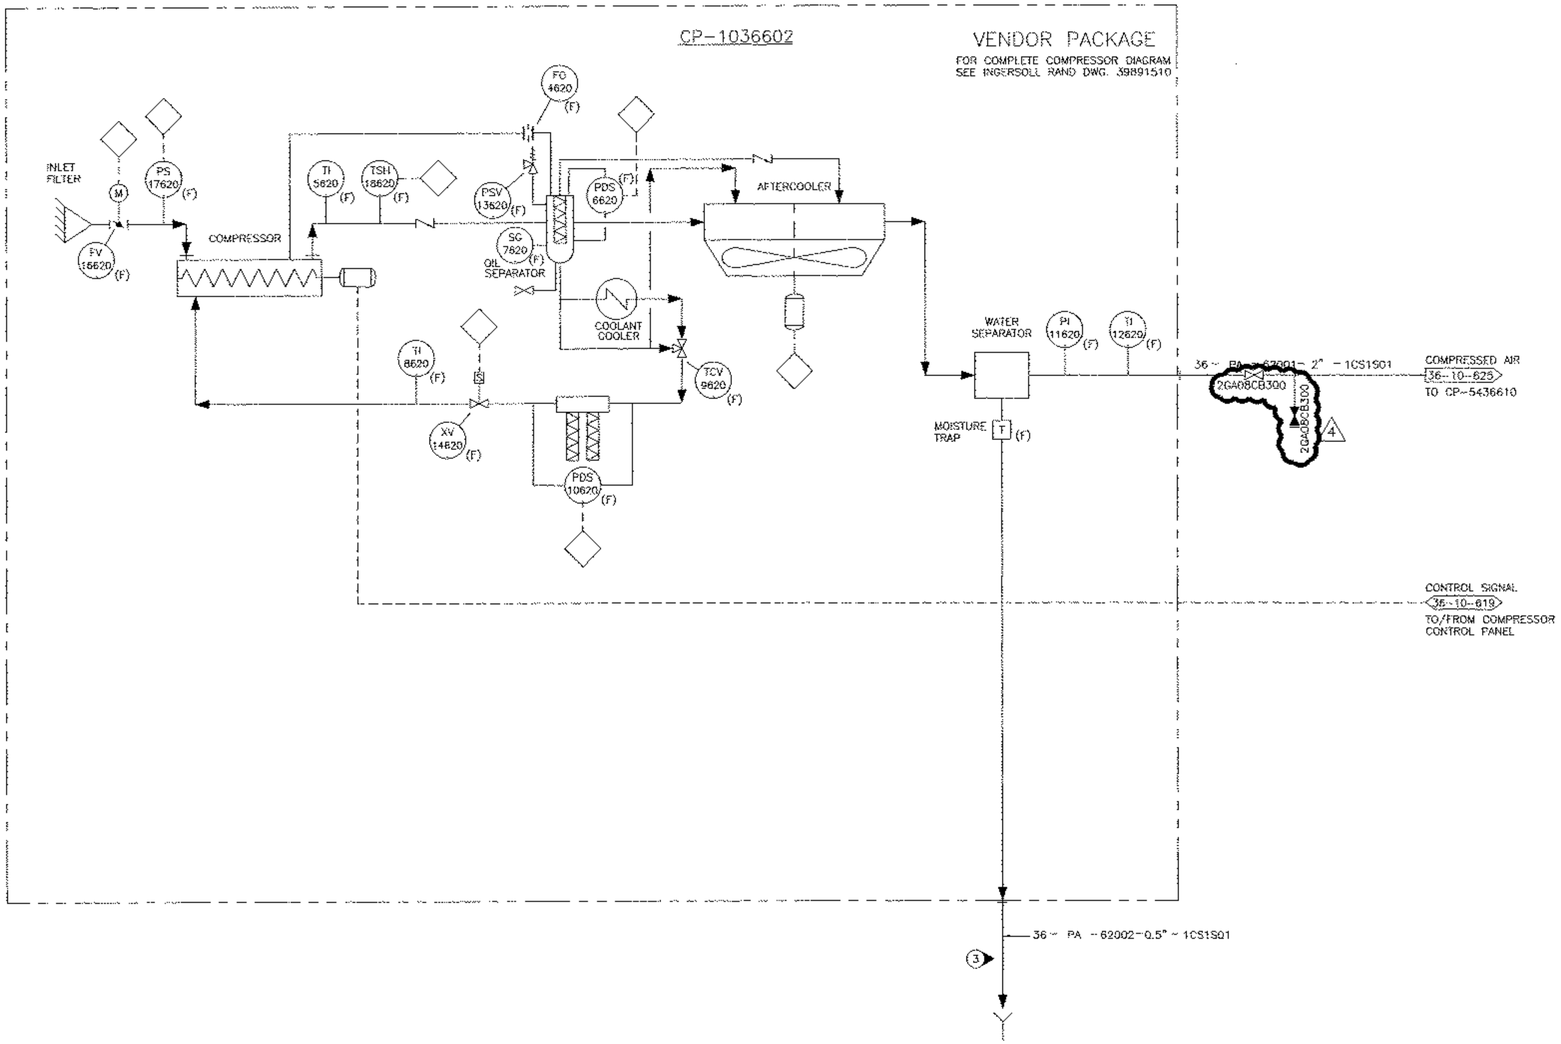

NOTES:

1. FOR GENERAL NOTES AND SYMBOLS, REFER TO DRAWING NOS. 35-10-098, 35-10-099
2. LOCATE VALVES AS CLOSE TO TEES AS POSSIBLE.
3. ROUTE TO DRAIN.

AS BUILT
02/09/03

JACOBS ENGINEERING®
Engineers and Constructors
P.O. Box 2008, Lakeland, Florida 33806-2008 Fax: (941) 665-3223

FMC CORPORATION
FES - Princeton, NJ

This drawing, including all information thereon, is FMC property, is confidential, and must not be used, made public, or copied unless authorized by FMC. It is subject to return upon demand. FMC Corporation

REV	ZONE	DESCRIPTION	BY	CKD	DATE	APPD	APPD	APPD
4	–	AS BUILT PER SDS 2001 WALK-DOWN	JH	MAG	2/9/03			
3	–	UPDATED PER VENDOR DATA	KP	JWH	8/28/03			
2	–	ISSUE FOR HAZOPS	KP	CGH	5/16/00	JME	ALG	
1	–	REISSUE FOR DESIGN	FH	CGH	2/16/00	JME	ALG	
0	–	ISSUE FOR DESIGN	CGH	JME	10/25/99	JME		

APPROVED FOR CONSTRUCTION
SIGNATURE DATE
APPROVED FOR CONSTRUCTION
SIGNATURE DATE
APPROVED FOR CONSTRUCTION
SIGNATURE DATE

PROJ. MGR. J. KORETCHKO
CHECKER
DISP. LEAD
ORIGINATOR F. HICKS
DATE 3/30/99
CAD FILE 3610620_4

FMC PURIFIED PHOSPHORIC ACID PLANT
AT AGRIUM-CONDA PHOSPHATES
INSTRUMENT AIR COMPRESSORS
PIPING AND INSTRUMENTATION DIAGRAM

SCALE	ORDER NO.	DRAWING NO.	REV.
NONE	28-T424-10	36-10-620	4

EXHIBIT B

AGR-CBI_003906
SUBJECT TO ALL APPLICABLE CONFIDENTIAL BUSINESS INFORMATION PRIVILEGES