35-10-201

DRAWING NO.

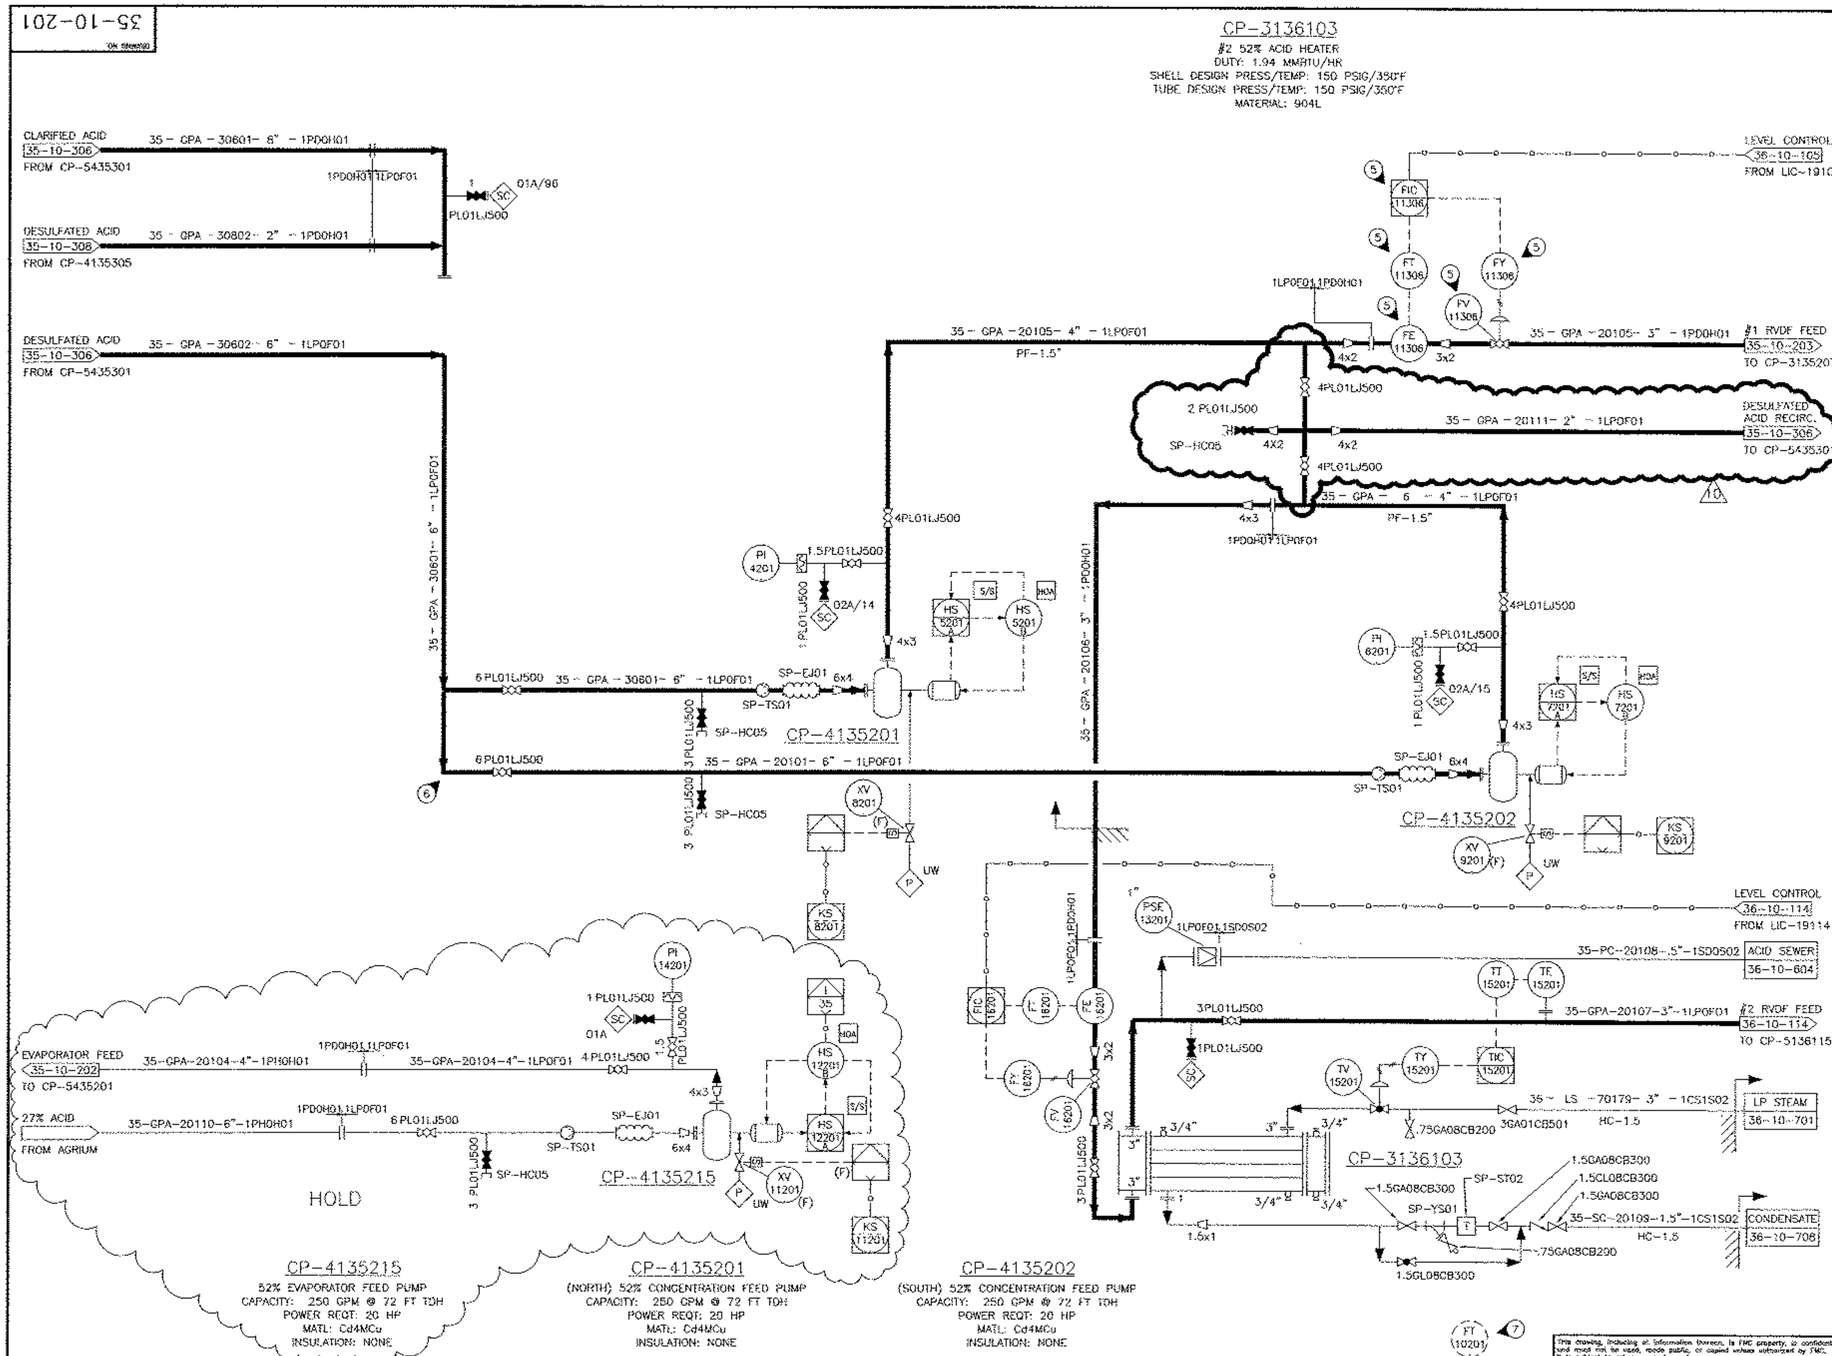

NOTES:

1. FOR GENERAL NOTES AND SYMBOLS, REFER TO DRAWING NOS. 35-10-098, 35-10-099.
2. LOCATE VALVES AS CLOSE TO TEES AS POSSIBLE.
3. DELETED
4. NO POCKETS
5. INSTRUMENTS FE-11306, FT-11306, FIC-11306, FV-11306 AND FY-11306 RELOCATED FROM DRAWING 35-10-306.
6. RE-INSTALL PIPING.
7. INSTRUMENTS FE-10201, FT-10201, FIC-10201, FV-10201 AND FY-10201 RELOCATED TO DRAWING 36-10-112.

INTERLOCKS

- I-35 CP-4135214 S/D CLOSES FV-2202.

AS BUILT
04/14/03

L#20111

JACOBS ENGINEERING®
Engineers and Constructors
P.O. Box 2008, Lakeland, Florida 33802-2008, 1993 S 59 SW, Lakeland Florida 33803
Tel (941) 665-1551 Fax (941) 665-9303

FMC CORPORATION
FES - Princeton, NJ

REV	ZONE	DESCRIPTION	BY	CKD	DATE	APPD	APPD	APPD
10		AS BUILT PER ESR 20073	KV	MAG	4/14/03			
9	–	RELOCATED INSTRUMENTS PER NOTES 5 AND 7	MAG		3/6/03			
8	–	AS BUILT PER ESR 20036	CGH		12/6/02			
7	–	AS BUILT PROJECT #210062	CGH		3/15/02			
6	–	REISSUE FOR DESIGN, PROJECT #210062	CGH		12/17/01			
5	–	REISSUE FOR DESIGN						
4	–	REISSUE FOR DESIGN	KP	JWH	8/28/00	JME		ALG/LE
3	–	ISSUE FOR HAZOPS	KP	CGH	5/8/00	JME	WRY	ALG/TCS
2	–	REISSUE FOR DESIGN	BM	CGH	2/1/00	ALG	JME	
1	–	GENERAL REVISION	CGH	JME	11/24/99	JME		
0	–	ISSUED FOR DESIGN	CGH	JME	10/25/99	JME		

This drawing, including all information thereon, is FMC property, is confidential, and must not be used, made public, or copied without written consent by FMC. It is subject to return upon demand. FMC Corporation

APPROVED FOR CONSTRUCTION — SIGNATURE — DATE
APPROVED FOR CONSTRUCTION — SIGNATURE — DATE
APPROVED FOR CONSTRUCTION — SIGNATURE — DATE

PROJ. MGR. J. KORETCHKO
CHECKER
DISP. LEAD
DESIGNATOR P. WATERS
DATE 5/7/99
CAD FILE 3510201_10

FMC PURIFIED PHOSPHORIC ACID PLANT AT AGRIUM-CONDA PHOSPHATES 52% CONCENTRATION FEED PIPING & INSTRUMENTATION DIAGRAM

SCALE	ORDER NO.	DRAWING NO.	REV.
NONE	28-T424-10	35-10-201	10

AGR-CBI_003909
SUBJECT TO ALL APPLICABLE CONFIDENTIAL BUSINESS INFORMATION PRIVILEGES