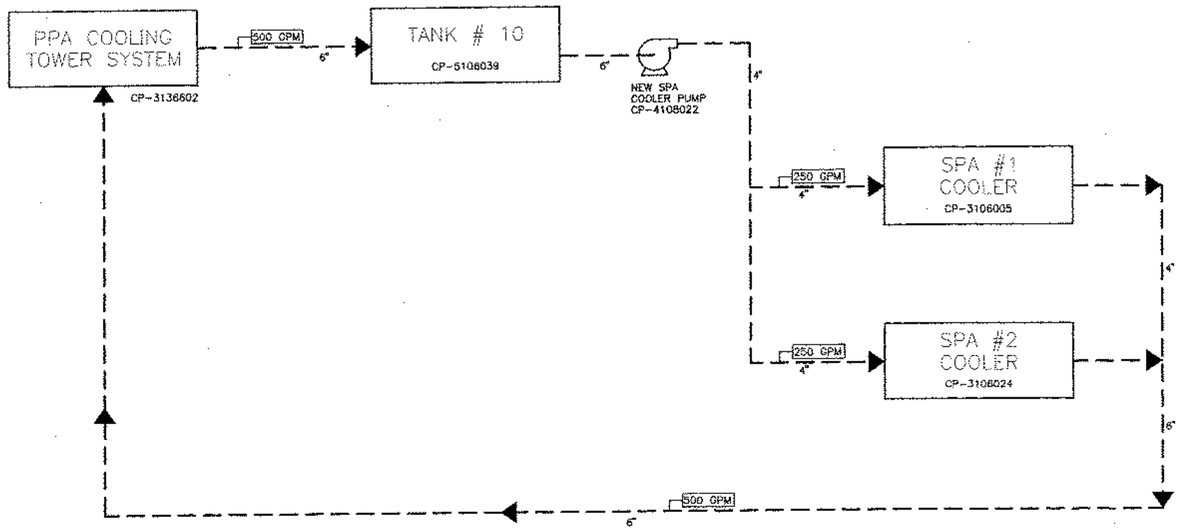

GENERAL NOTES

Drawing No.	Description
Reference Drawing	

No.	Date	Revision	Dwn.	Chk'd.	App'd.
0	02/18/03	AS-BUILT - ADDED CP NUMBERS	KHA		

	DRAWING APPROVAL	DATE
PROJECT MANAGER	[signature]	3/6/03
ENGINEERING	[signature]	3/6/03
OPERATIONS		
MAINTENANCE		
SUPERVISION		
RISK MANAGEMENT		

Agrium 3010 CONDA ROAD SODA SPRINGS, ID. 83276

PHOS ACID
PHOS ACID SPA COOLERS TO PPA TOWER
PFD

NOTICE

THIS DRAWING IS THE PROPERTY OF AGRIUM CPO, INC. AND IS LENT TO THE BORROWER FOR HIS CONFIDENTIAL USE ONLY AND IS SUBJECT TO RETURN UPON REQUEST AND SHALL NOT BE REPRODUCED, COPIED, LENT OR OTHERWISE DISPOSED OF DIRECTLY OR INDIRECTLY, NOR USED FOR ANY PURPOSE OTHER THAN THAT FOR WHICH IT IS SPECIFICALLY FURNISHED.

Dwn.: JSS	Chk'd.:	Drawing No.: 06-10-024	Rev. 0
Approved:			
Project No.:			
Scale: NONE		Sheet 1 of 1	

Drawing Name and Location: R:\DWGS\DRAWINGS\06- PHOS ACID\10\06-10-024.dwg Last accessed: Feb 28, 2003-8:22am by: kstone

EXHIBIT 6

AGR-CBI_003890
SUBJECT TO ALL APPLICABLE CONFIDENTIAL BUSINESS INFORMATION PRIVILEGES