35-10-206

CP-3135204
(SOUTH) 52% WATER COOLER
DUTY: 37.2 M BTU/H
SURFACE AREA: XXX SQ FT
DES PRESS @ TEMP: 150 PSIG @ 150°F
MATL: HASTELLOY G-30
INSULATION: NONE

CP-3135205
(MIDDLE) 52% WATER COOLER
DUTY: 37.2 M BTU/H
SURFACE AREA: XXX SQ FT
DES PRESS @ TEMP: 150 PSIG @ 150°F
MATL: HASTELLOY G-30
INSULATION: NONE

CP-3135206
(NORTH) 52% WATER COOLER
DUTY: 37.2 M BTU/H
SURFACE AREA: XXX SQ FT
DES PRESS @ TEMP: 150 PSIG @ 150°F
MATL: HASTELLOY G-30
INSULATION: NONE

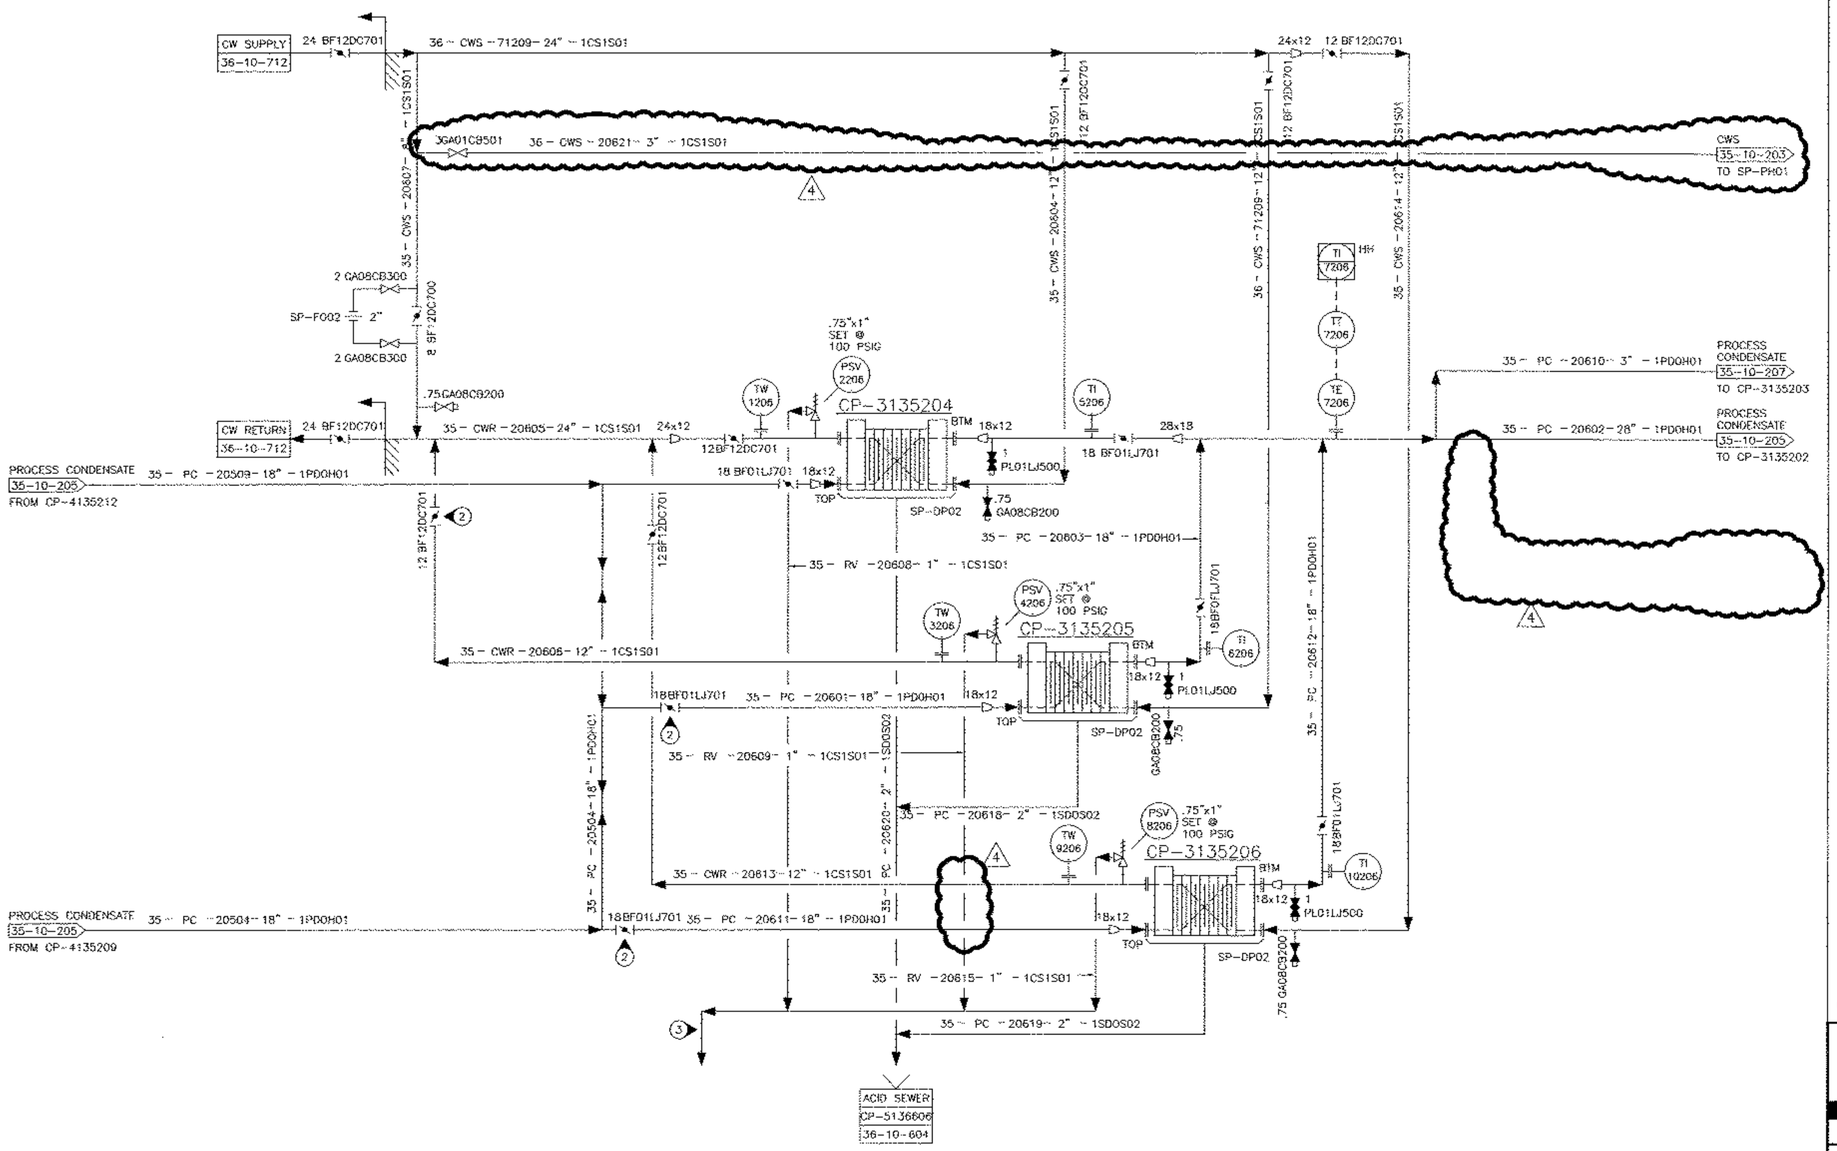

NOTES:

1. FOR GENERAL NOTES AND SYMBOLS, REFER TO DRAWING NOS. 35-10-098, 35-10-099.
2. LOCATE VALVES AS CLOSE TO TEES AS POSSIBLE.
3. ROUTE TO SAFE LOCATION AT GRADE.

AS BUILT
01/15/03

L#20621

JACOBS ENGINEERING
Engineers and Constructors
P.O. Box 8088, Lakeland, Florida 33806-2089; 966 E SR 540, Lakeland Florida 33803
Tel: (941) 665-1511 Fax (941) 665-2083

FMC CORPORATION
FES - Princeton, NJ

This drawing, including all information thereon, is FMC property, is confidential and must not be used, made public, or copied unless authorized by FMC. It is subject to return upon demand. FMC Corporation

REV	ZONE	DESCRIPTION	BY	CKD	DATE	APPD	APPD	APPD
4	–	AS BUILT PER SDS 2001 WALK-DOWN	JH	MAG	1/15/03			
3	–	REISSUE FOR DESIGN	KP		8/28/00			
2	–	REISSUE FOR DESIGN	KP	CGH	5/8/00	JME	WRY	ALQ/TCS
1		GENERAL REVISION	CGH	JME	11/24/99	JME		
0		ISSUE FOR DESIGN	CGH	JME	10/25/99	JME		

(end)

APPROVED FOR CONSTRUCTION — SIGNATURE — DATE
APPROVED FOR CONSTRUCTION — SIGNATURE — DATE
APPROVED FOR CONSTRUCTION — SIGNATURE — DATE

PROJ. MGR. J. KORETCHKO
DESIGNER
DESIG. LEAD
DESIGNATOR R. PEDROSO
DATE 5/14/99
CAD FILE 3510206_4

FMC PURIFIED PHOSPHORIC ACID PLANT
AT AGRIUM-CONDA PHOSPHATES
52% EVAPORATION: CONDENSATE COOLER
PIPING & INSTRUMENTATION DIAGRAM

SCALE	ORDER NO.	DRAWING NO.	REV.
NONE	28-T424-10	35-10-206	4

EXHIBIT B

AGR-CBI_003894
SUBJECT TO ALL APPLICABLE CONFIDENTIAL BUSINESS INFORMATION PRIVILEGES