35-10-208

CP-5135206
GREEN ACID STORAGE SUMP
TYPE: IN GROUND
SIZE: 8'x8'x8'
MATL: COATED CONCRETE

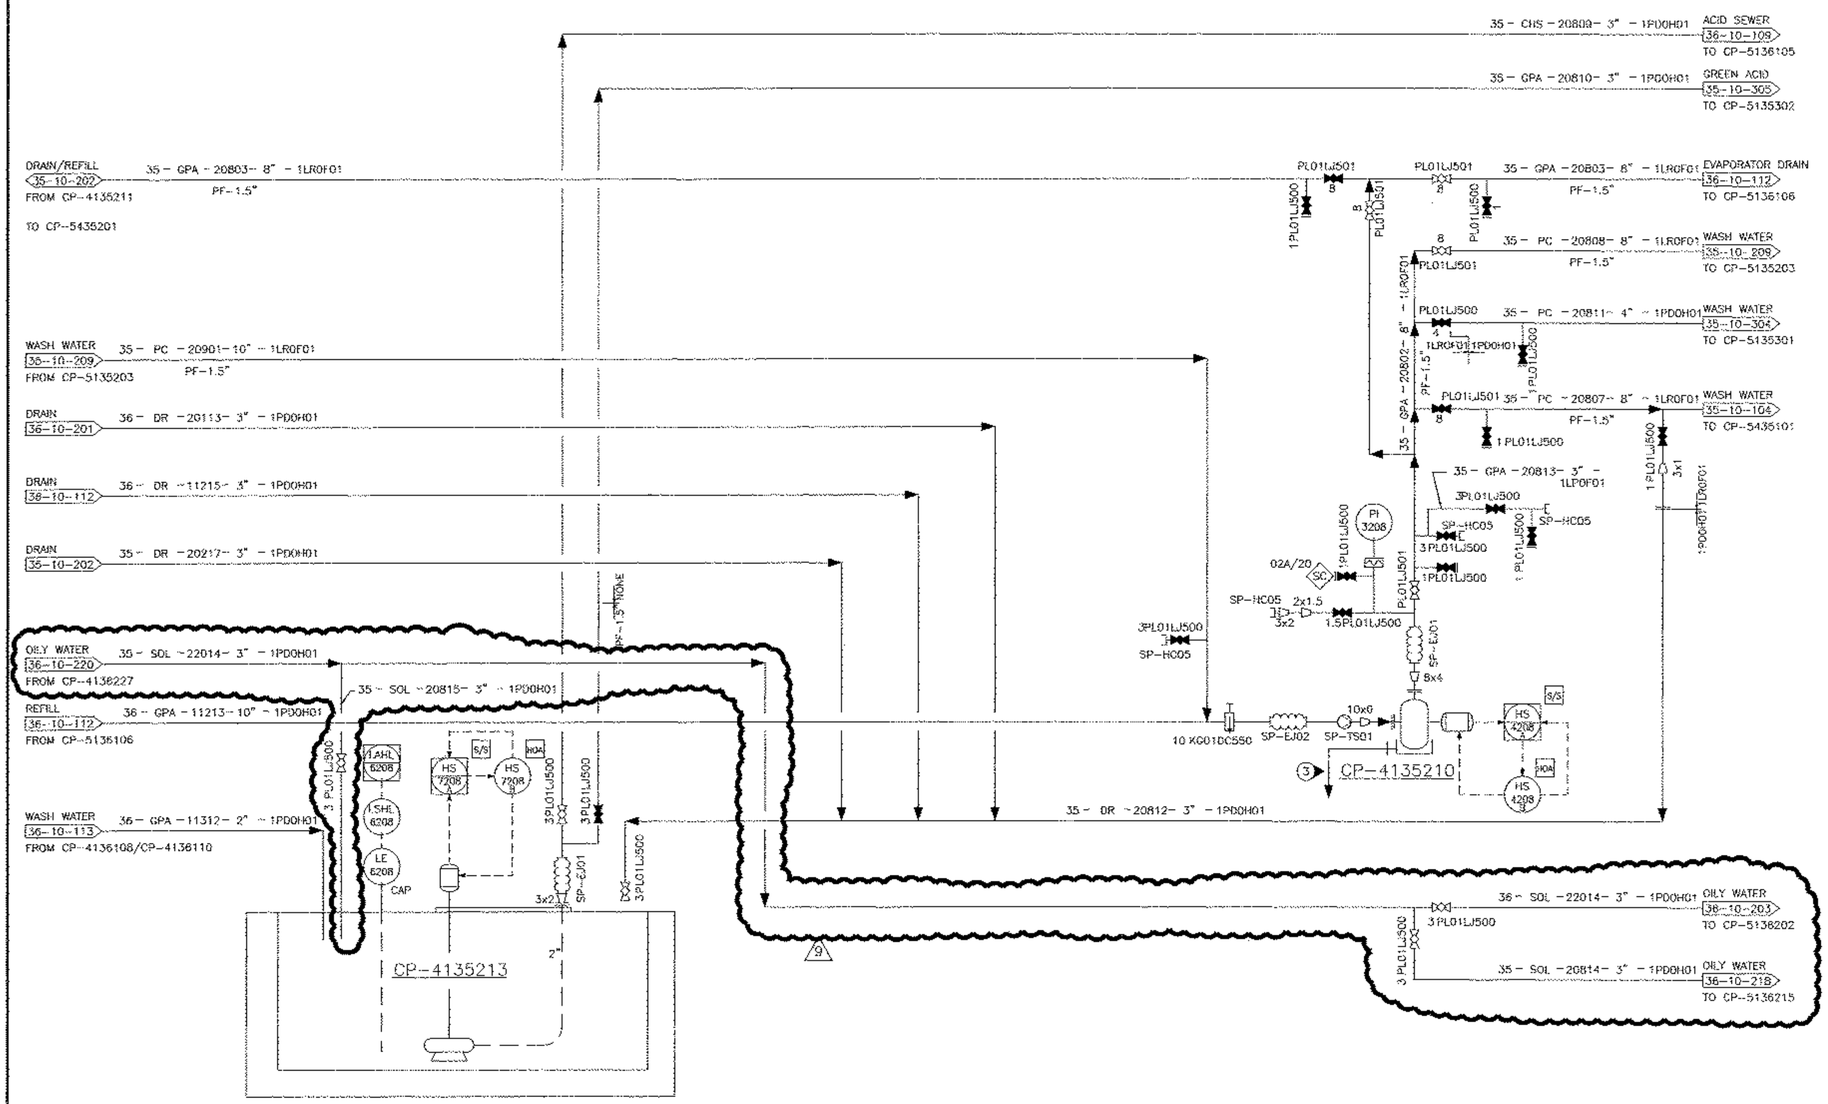

CP-5135206

CP-4135213
GREEN ACID STORAGE SUMP PUMP
CAPACITY: 100 GPM @ 23 FT TDH
POWER REQT: 5 HP
MATL: Cd4MCu
INSULATION: NONE

CP-4135210
WASH/DRAIN PUMP
CAPACITY: 600 GPM @ 73 FT TDH
POWER REQT: 20 HP
MATL: Cd4MCu
INSULATION: NONE

NOTES:

1. FOR GENERAL NOTES AND SYMBOLS, REFER TO DRAWING NOS. 35-10-098, 35-10-099.
2. LOCATE VALVES AS CLOSE TO TEES AS POSSIBLE.
3. 1" DRAIN FROM PUMP DRAIN PAN TO SLAB (SPEC. 15D0S02).

INTERLOCKS

AS BUILT
05/18/03

L#20815

JACOBS ENGINEERING®
Engineers and Constructors
P.O. Box 8088, Lakeland, Florida 33806-2088; 985 E SR 540, Lakeland Florida 33815
Tel: (941) 665-1511 Fax: (941) 665-2083

FMC CORPORATION
FES - Princeton, NJ

REV	ZONE	DESCRIPTION	BY	CKD	DATE	APPD	APPD	APPD
9	--	AS BUILT PER ESR 20017	MAG		5/18/03			
8	--	AS BUILT PER ESR 20070	KV	MAG	4/1/03			
7	--	AS BUILT PER SDS 2001 & CURRENT WALK DOWN	JH	MAG	1/15/03			
6	--	AS BUILT PROJECT #210062	CGH		3/15/02			

REV	ZONE	DESCRIPTION	BY	CKD	DATE	APPD	APPD	APPD
5	--	REISSUE FOR DESIGN PROJECT #210062	CGH		1/18/02			
4	--	REISSUE FOR DESIGN	JWN		8/28/00			
3	--	ISSUE FOR HAZOPS	KP	CGH	5/8/00	JME	WRY	AG/YCS
2	--	REISSUE FOR DESIGN	BM	CGH	2/1/00	JME		
1	--	GENERAL REVISION	CGH	JME	11/24/99	JME		
0	--	ISSUE FOR DESIGN	CGH	JME	10/25/99	JME		

This drawing, including all information thereon, is FMC property, is confidential and must not be used, made public, or copied unless authorized by FMC. It is subject to return upon demand. FMC Corporation.

APPROVED FOR CONSTRUCTION — SIGNATURE — DATE
APPROVED FOR CONSTRUCTION — SIGNATURE — DATE
APPROVED FOR CONSTRUCTION — SIGNATURE — DATE

PROJ. MGR: J. KORETCHKO
CHECKED:
DSP. LEAD:
DESIGNATOR: R. PEDROSO
DATE: 5/9/99
CAD FILE: 3510208_9

FMC PURIFIED PHOSPHORIC ACID PLANT AT AGRIUM-CONDA PHOSPHATES 52% EVAPORATOR DRAIN/FILL SYSTEM PIPING & INSTRUMENTATION DIAGRAM

SCALE	ORDER NO.	DRAWING NO.	REV.
NONE	28-T424-10	35-10-208	9

EXHIBIT B

AGR-CBI_003896
SUBJECT TO ALL APPLICABLE CONFIDENTIAL BUSINESS INFORMATION PRIVILEGES