36-10-112

CP-0136106
52% ACID SURGE TANK AGITATOR
POWER REQT: 7.5 HP
MATL: 904L SS

CP-5136106
52% ACID SURGE TANK
SIZE: 36'-0" ID x 28'-0" S/S
CAPACITY: 200,000 GAL
DES PRESS @ TEMP: -4/24 "WG @ 200°F
MATL: RLCS
TRIM: Cd4MCu/904L SS
INSULATION: NONE

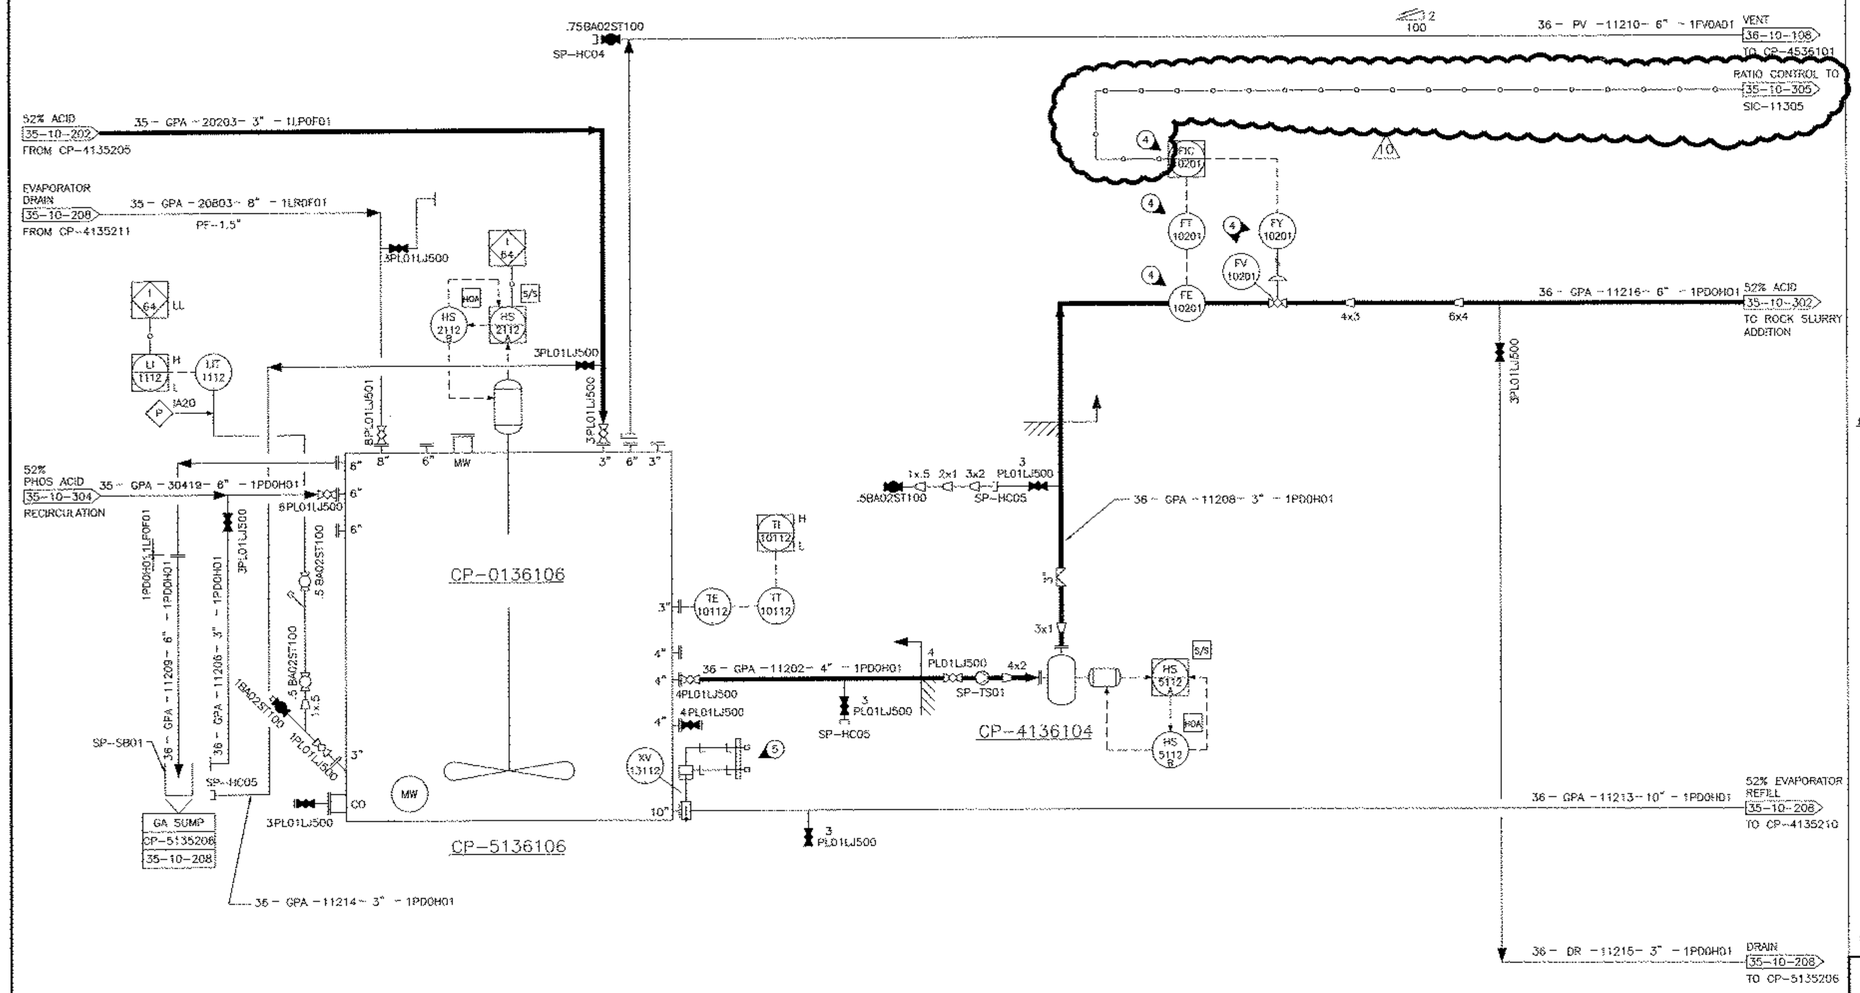

CP-4136104
(WEST) 52% FILTER FEED PUMP
CAPACITY: 110 GPM @ 220 FT TDH
POWER REQT: 40 HP, 3600 RPM
MATL: Cd4MCu
INSULATION: NONE

NOTES:

1. FOR GENERAL NOTES AND SYMBOLS, REFER TO DRAWING NOS. 35-10-098, 35-10-099.
2. LOCATE VALVES AS CLOSE TO TEES AS POSSIBLE.
3. NO POCKETS.
4. INSTRUMENTS FE-10201, FT-10201, FIC-10201, FV-10201 AND FY-10201 RELOCATED FROM DRAWING 36-10-201.
5. SEE DRAWING 35-10-209 FOR VALVE HYDRAULIC UNIT.

INTERLOCKS

* I-64 LOW-LOW LEVEL AT LI-1112 STOPS CP-0136106.

AS BUILT
04/14/03

L#11216

JACOBS ENGINEERING®
Engineers and Constructors
P.O. Box 2090, Lakeland, Florida 33802-2090, 505 E SR 540, Lakeland Florida 33843
Tel: (863) 665-7000 Fax: (863) 665-5069

FMC CORPORATION
FES - Princeton, NJ

REV	ZONE	DESCRIPTION	BY	CKD	DATE	APPD	APPD	APPD
10	-	AS BUILT PER ESR 20027	KV	MAG	4/14/03			
9	-	AS BUILT PER ESR 20041	MAG		3/10/03			
8	-	RELOCATED INSTRUMENTS PER NOTE 4	MAG		3/6/03			
7	-	AS BUILT PER ESR 20057	MD		12/05/02			
6	-	AS BUILT PER WALK-DOWN	MAG		12/05/02			
5	-	AS BUILT PER SDS 2001 WALK DOWN	JH		10/22/02			
4	-	REISSUE FOR DESIGN	RJS		11/22/00			
3	-	ISSUE FOR HAZOPS	KP	CGH	5/8/00	JME	WRY	ALG/TCS
2	-	REISSUE FOR DESIGN	KP	CGH	2/3/00	JME	ALG	KP
1	-	GENERAL REVISION	CGH	JME	11/24/99	JME		
0	-	ISSUE FOR DESIGN	CGH	RIP	10/25/99	JME		

This drawing, including all information thereon, is FMC property, is confidential, and must not be used, made public, or copied unless authorized by FMC. It is subject to return upon demand. FMC Corporation

APPROVED FOR CONSTRUCTION — SIGNATURE — DATE
APPROVED FOR CONSTRUCTION — SIGNATURE — DATE
APPROVED FOR CONSTRUCTION — SIGNATURE — DATE

FIELD MGR: J. KORETCHKO
CHECKER:
MFG. LEAD:
ORIGINATOR: R. PEDROSO
DATE: 5/12/99
CAD FILE: 3610112_10

FMC PURIFIED PHOSPHORIC ACID PLANT AT AGRIUM-CONDA PHOSPHATES 52% ACID SURGE TANK PIPING & INSTRUMENTATION DIAGRAM

SCALE	ORDER NO.	DRAWING NO.	REV.
NONE	28-T424-10	36-10-112	10

EXHIBIT B
AGR-CBI_003899
SUBJECT TO ALL APPLICABLE CONFIDENTIAL BUSINESS INFORMATION PRIVILEGES