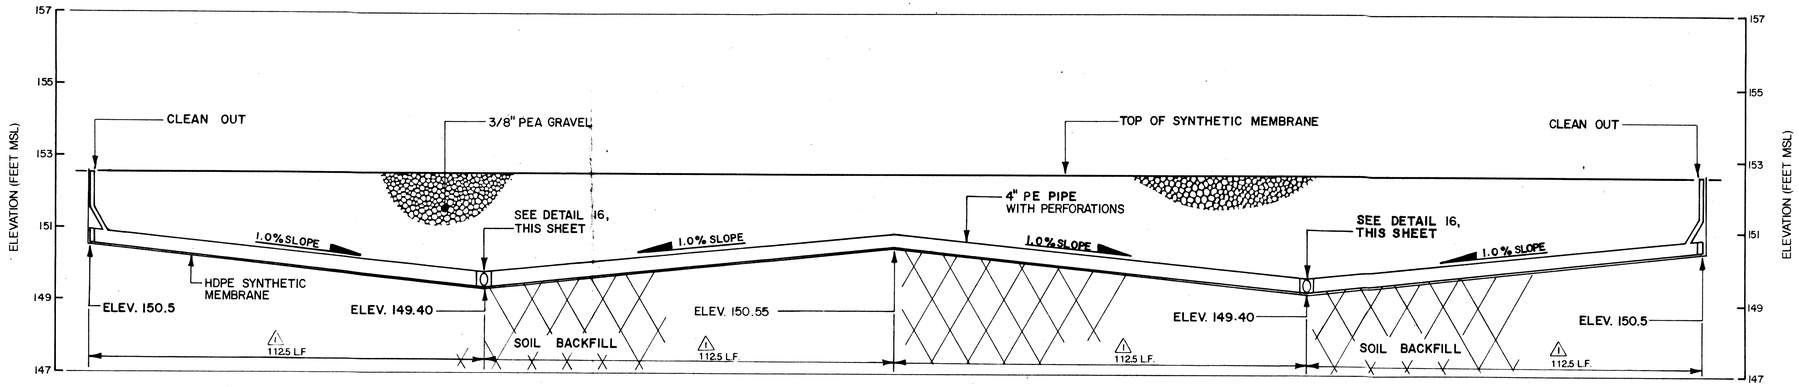

CAP DRAIN PROFILES
(NORTH AND SOUTH SIDES)

SCALE
HORZ. 1"=20'
VERT. 1"=2'

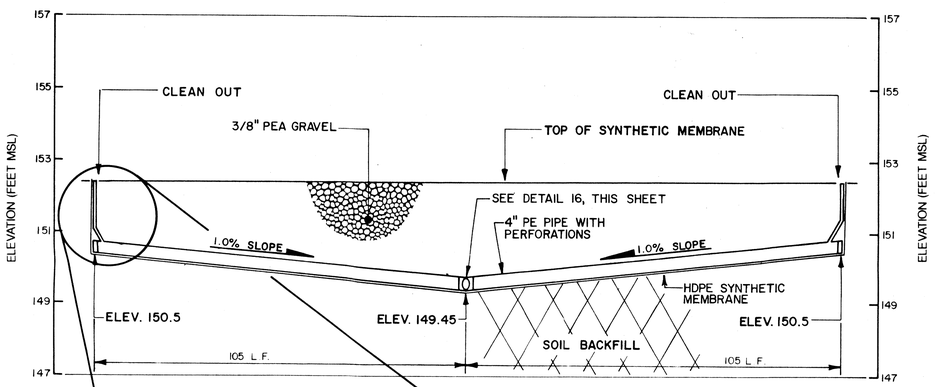

CAP DRAIN PROFILES
(EAST AND WEST SIDES)

SCALE
HORZ. 1"=20'
VERT. 1"=2'

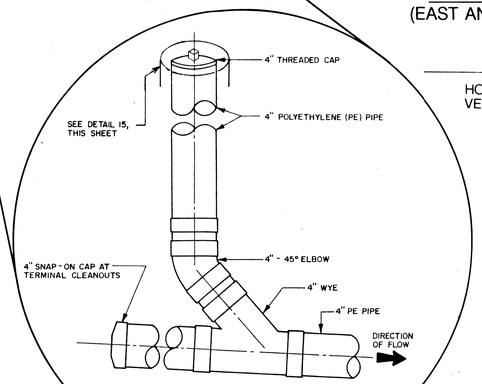

TYPICAL CLEANOUT
N.T.S.
DETAIL 14

NOTE:
FOR LEACHATE DETECTION PIPES, ON SHEET 9 OF 16, CLEANOUTS ARE SCHEDULE 80 PVC MATERIAL.

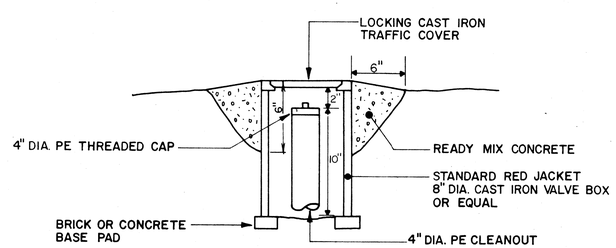

TYPICAL FRAME AND COVER CLEANOUT
N.T.S.
DETAIL 15

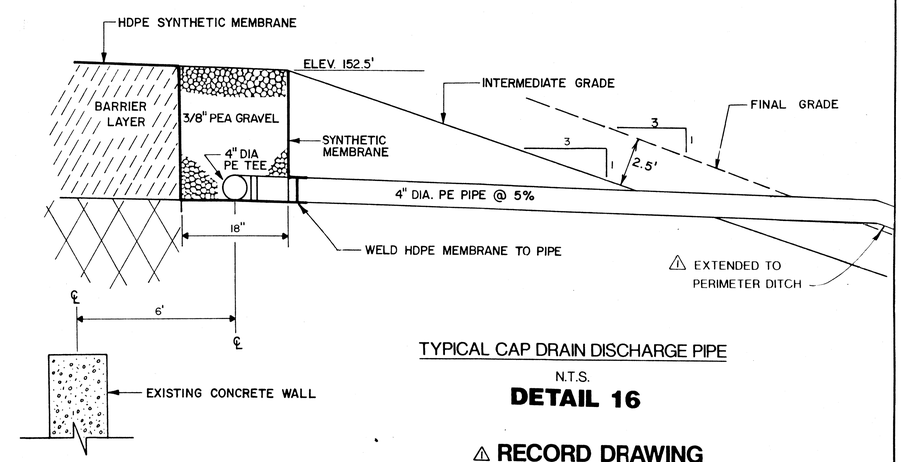

TYPICAL CAP DRAIN DISCHARGE PIPE
N.T.S.
DETAIL 16

RECORD DRAWING

SHEET 12 OF 16

DRAWING CONFIDENTIAL: THIS DRAWING AND ALL INFORMATION CONTAINED THEREON IS AND SHALL REMAIN THE PROPERTY OF G&M CONSULTING ENGINEERS, INC. AS AN INSTRUMENT OF PROFESSIONAL SERVICE. THIS INFORMATION SHALL NOT BE USED, IN WHOLE OR IN PART, WITHOUT THE FULL KNOWLEDGE AND PRIOR WRITTEN CONSENT OF G&M CONSULTING ENGINEERS.

SCALE VERIFICATION
THIS BAR REPRESENTS ONE INCH ON THE ORIGINAL DRAWING:
0 1"
USE TO VERIFY FIGURE SCALE

REV. NO.	DATE	DESCRIPTION	BY	APPR.
1	9-24-91	REVISED PER REC. DRAW.	A.A.A.	J.G.

DRAWING NO: FLOO18-CWP-D12	
DRAWN BY: KEN CARROLL	DATE: MARCH 18, 1989
CHECKED: C. Duncan	DATE: May 20, 1989
APPROVED: J. PETERSOHN	DATE: MAY 20, 1989

GERAGHTY & MILLER ENGINEERS, INC.

CAP DRAIN DETAILS
RCRA LANDFILL CLOSURE
MARTIN MARIETTA CORPORATION
THE DALLES, OREGON

BAY REPROGRAPHICS 301904