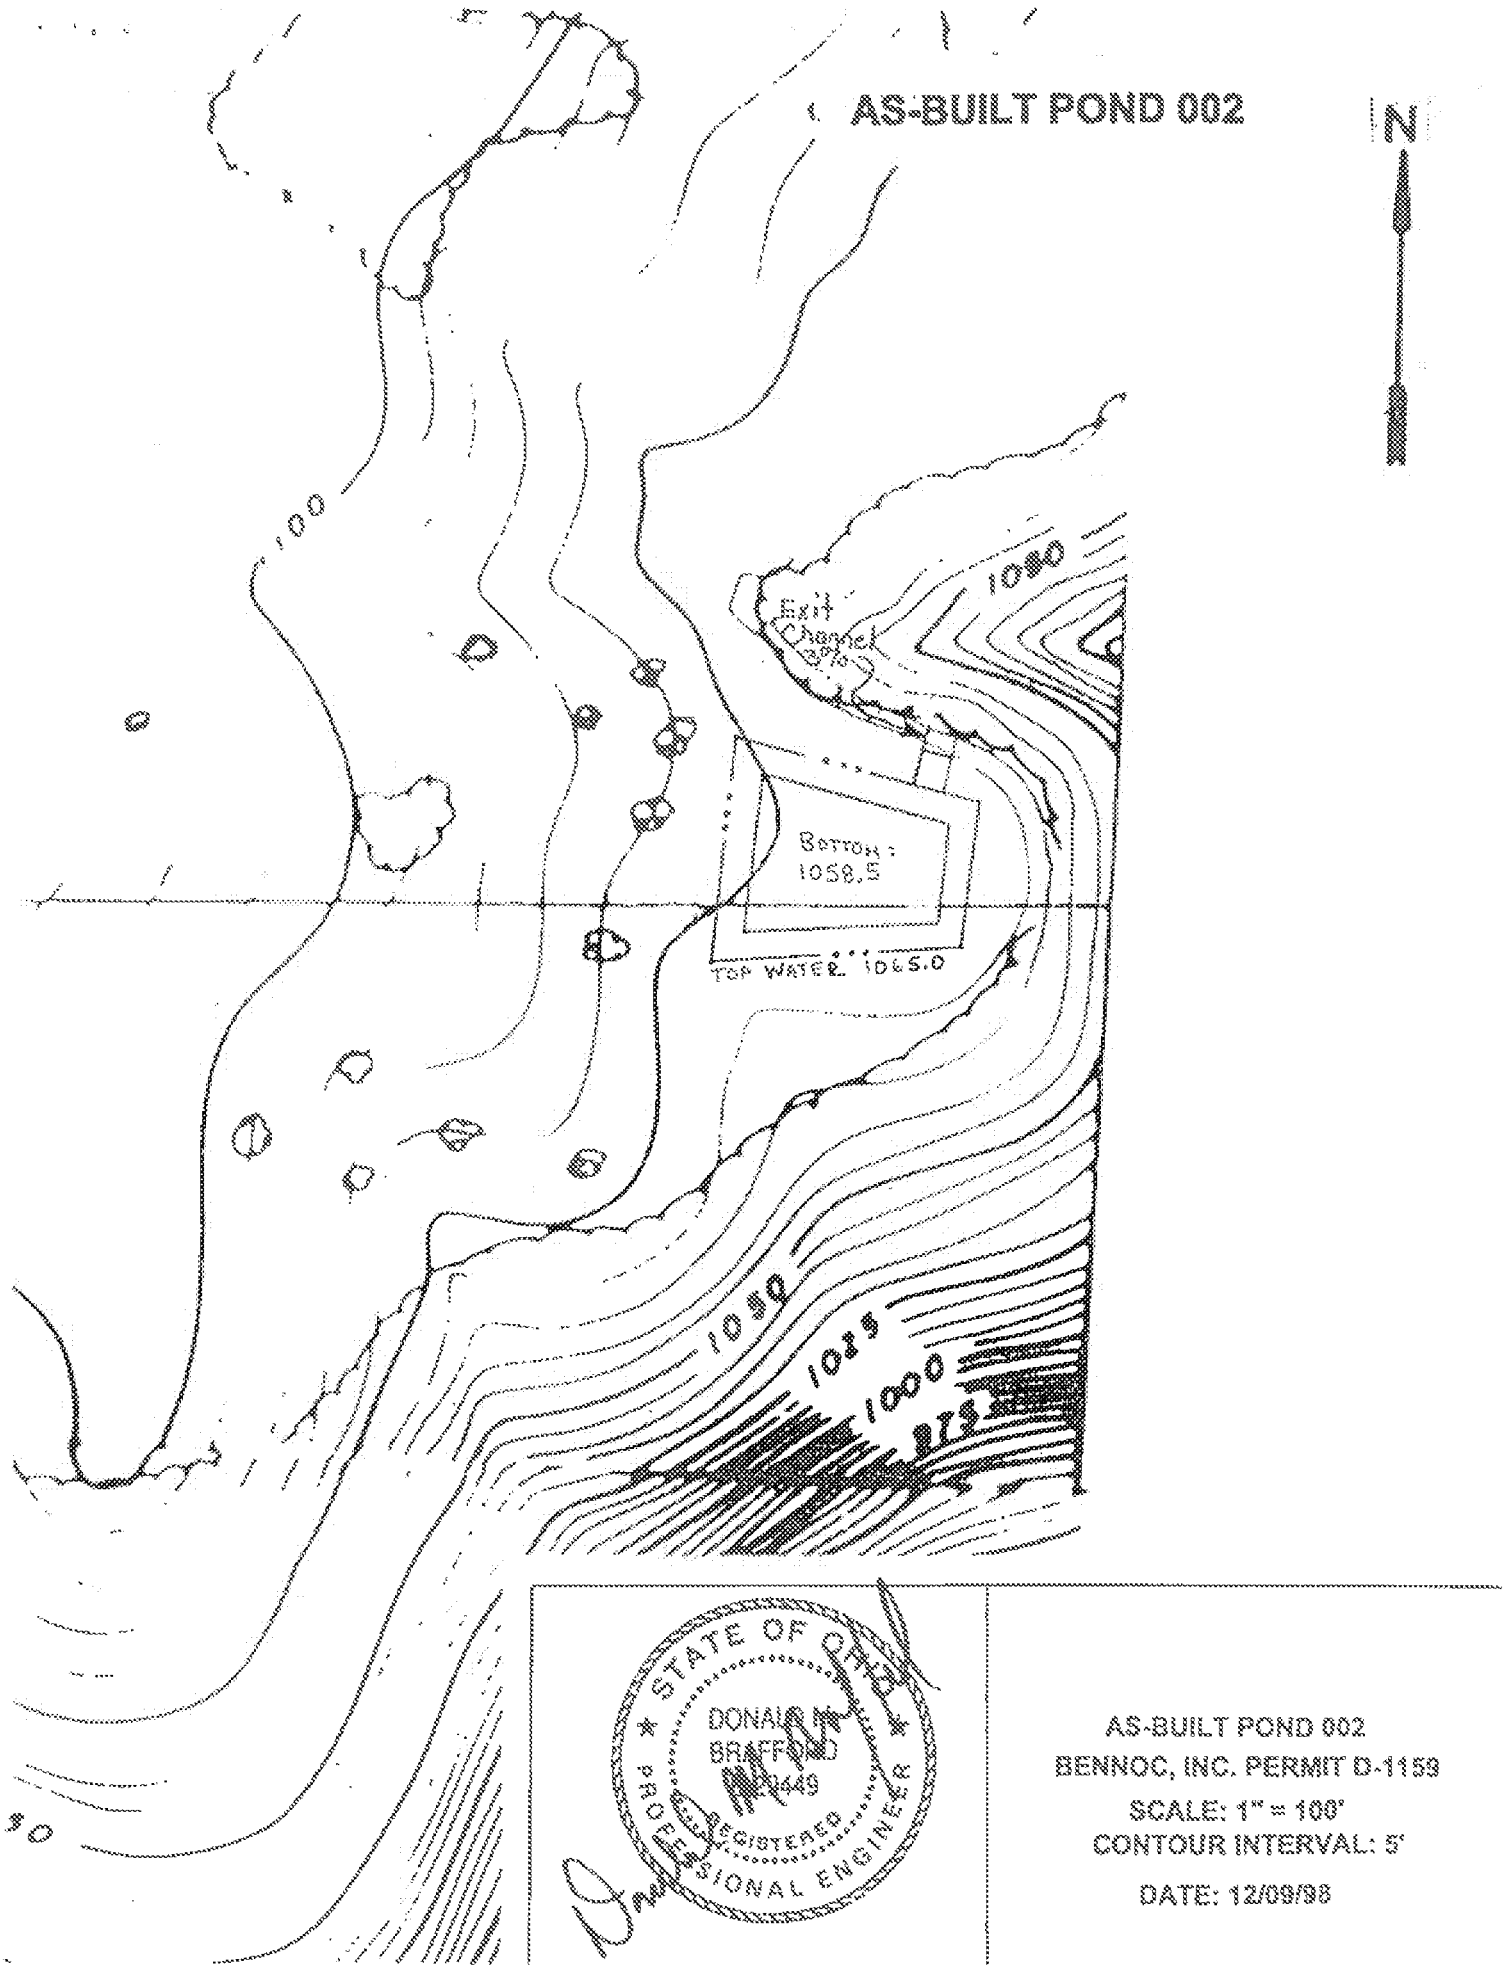

AS-BUILT POND 002
BENNOC, INC. PERMIT D-1159
SCALE: 1" = 100'
CONTOUR INTERVAL: 5'
DATE: 12/09/98