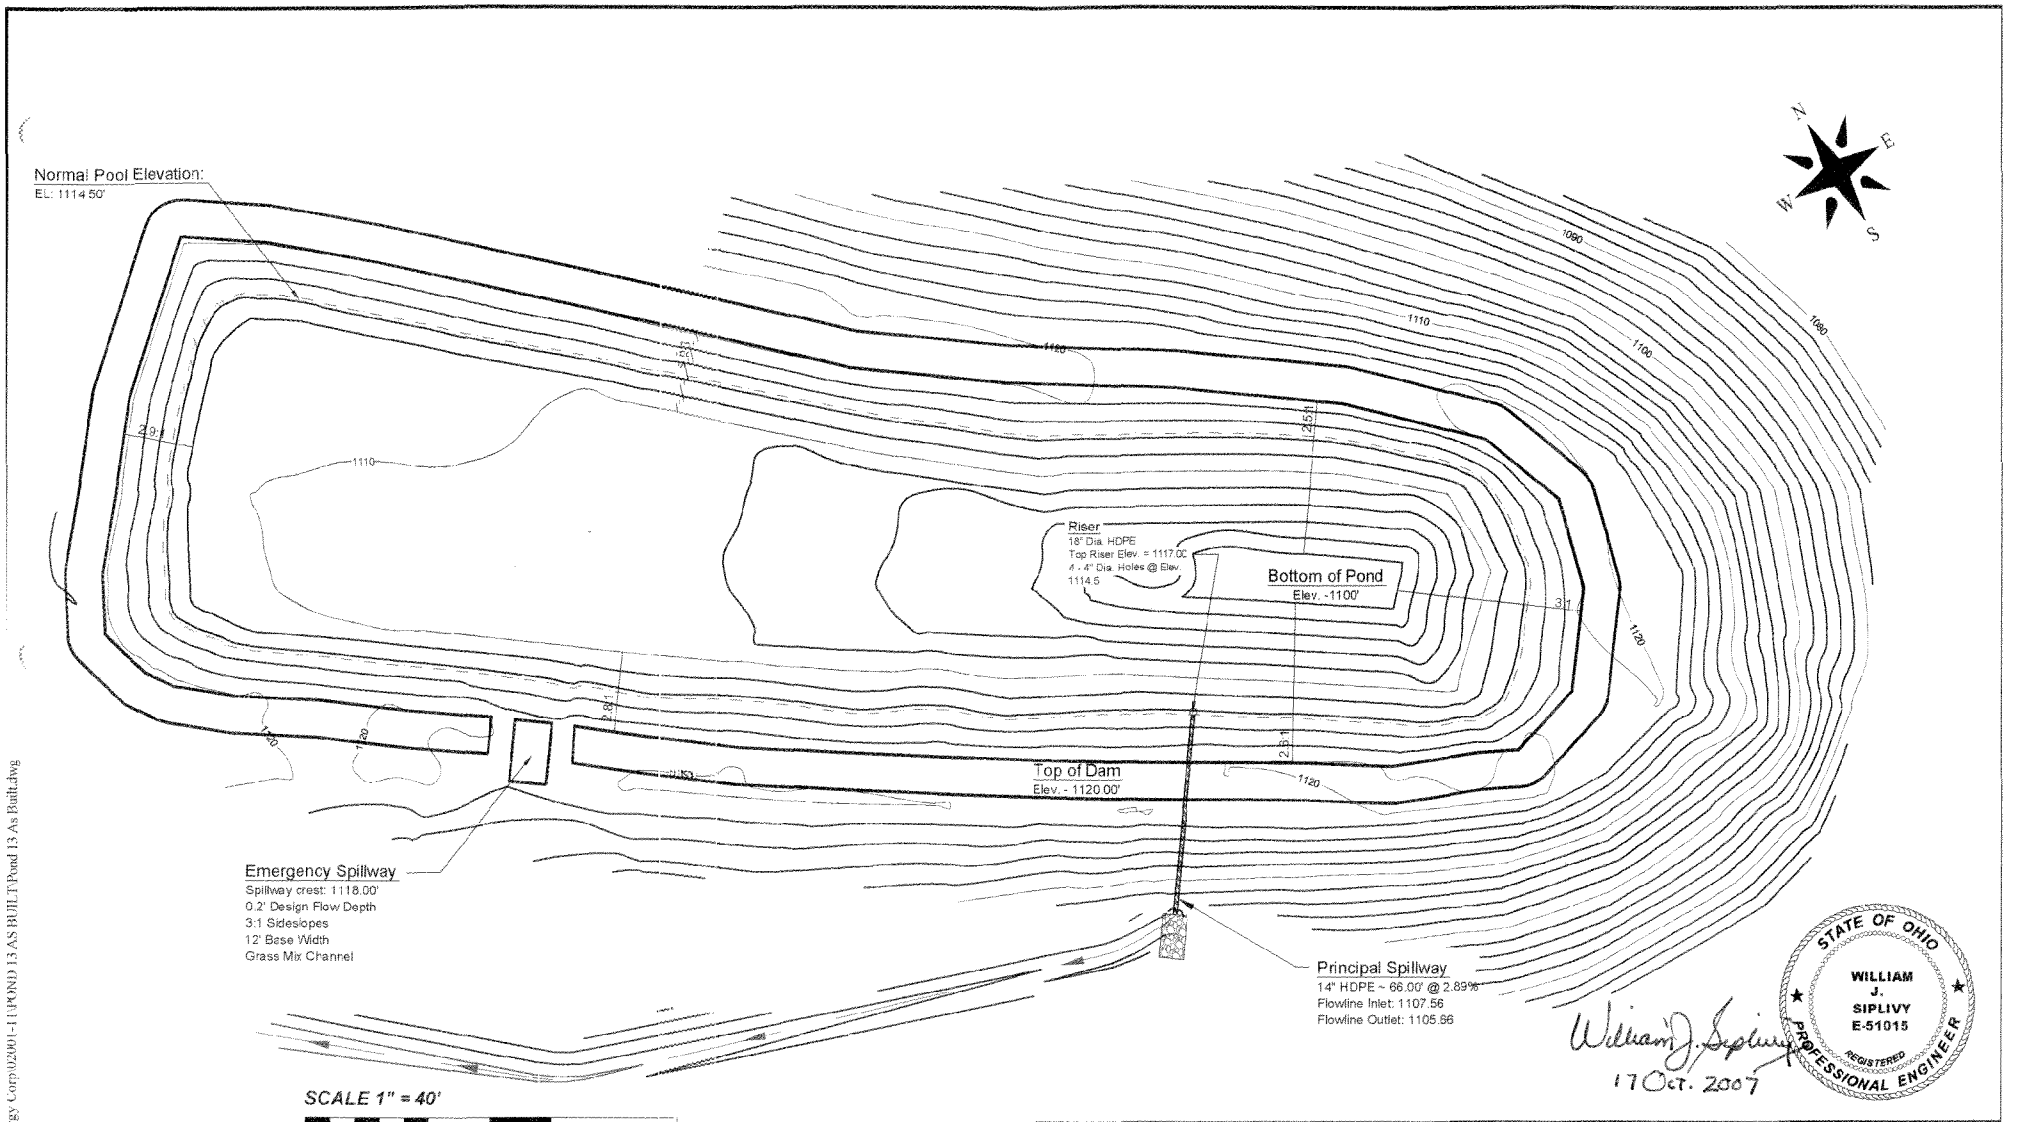

STATE OF OHIO
WILLIAM J. SIPLIVY
E-51015
REGISTERED
PROFESSIONAL ENGINEER

William J. Siplivy
17 Oct. 2007

Jack A. HAMILTON & Associates, Inc.
242 High St., Box 471
Flushing, Ohio 43977
Ph. (740) 968-4947
Fax: (740) 968-4225
e-mail: hamilton@1st.net
www.hamiltonandassoc.com

IMPOUNDMENT PLAN **POND 013 As-Built**		
Applicant: AMERICAN ENERGY CORPORATION		
CENTURY MINE		
Township: Wayne		County: BELMONT
Page 1 of 1		Scale: 1" = 40'
Date: 6/18/07	PERMIT D-0425	Comm #02001-11

Z:\Jobs\Client\American Energy Corp\02001-11\POND 13 AS BUILT\Pond 13 As Built.dwg

AEC 16818