# AS-BUILT EXCAVATED POND 019

## PLAN VIEW

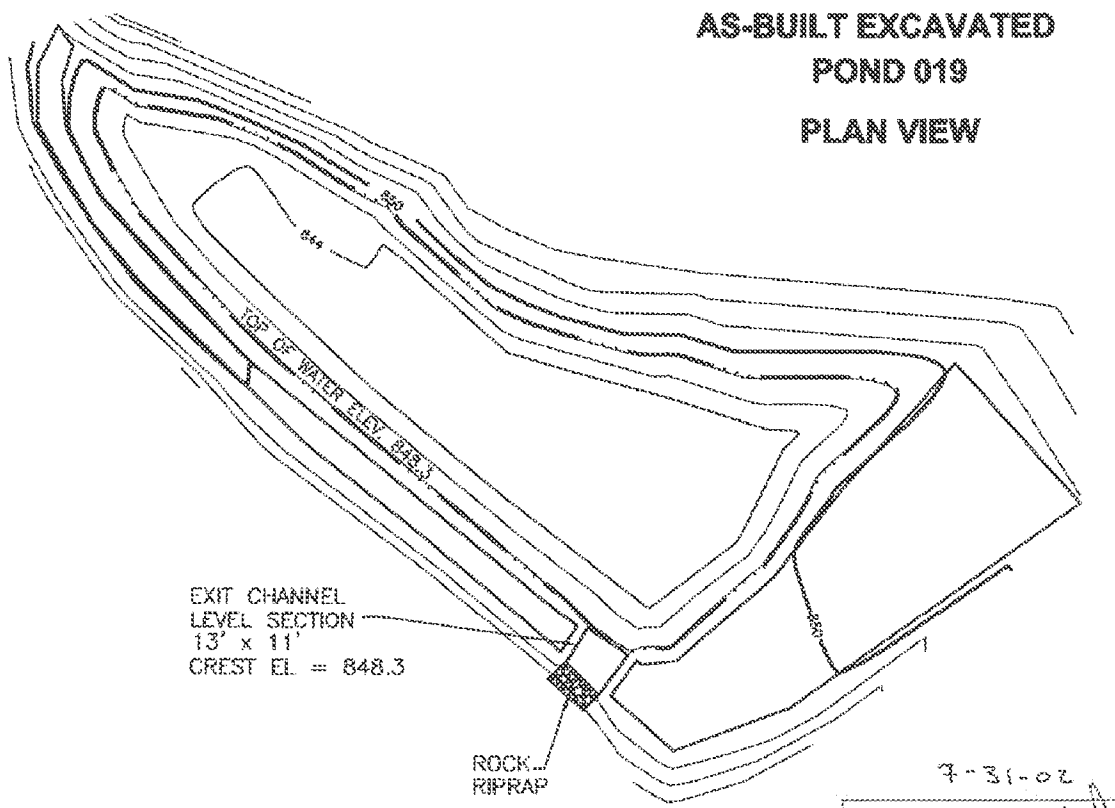


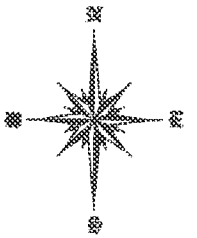


7-31-02

STATE OF OHIO
DONALD M. BRAMFORD
E-28449
REGISTERED
PROFESSIONAL ENGINEER

Addendum To Attachment 20, Item 7.

**AS-BUILT EXCAVATED POND 019**

| | | |
|---|---|---|
| Applicant: AMERICAN ENERGY CORPORATION D-0425 | | |
| Section: 4 | Township: 8 | Range: 5 |
| Township: WAYNE | County: BELMONT | |
| Scale: 1" = 40' | Contour Interval: 2' | |
| Date Prepared: 07/29/02 | Comm #02001-S | DWG: AB_POND019 |


Jack L. HAMILTON & Associates, Inc.
342 High St., Box 471
Flushing, Ohio 43977
Ph: (740) 968-4947
Fax: (740) 968-4225
e-mail: hamilton@1st.net
www.hamiltonassoc.com


DRAWN BY: SSU

AEC 16822