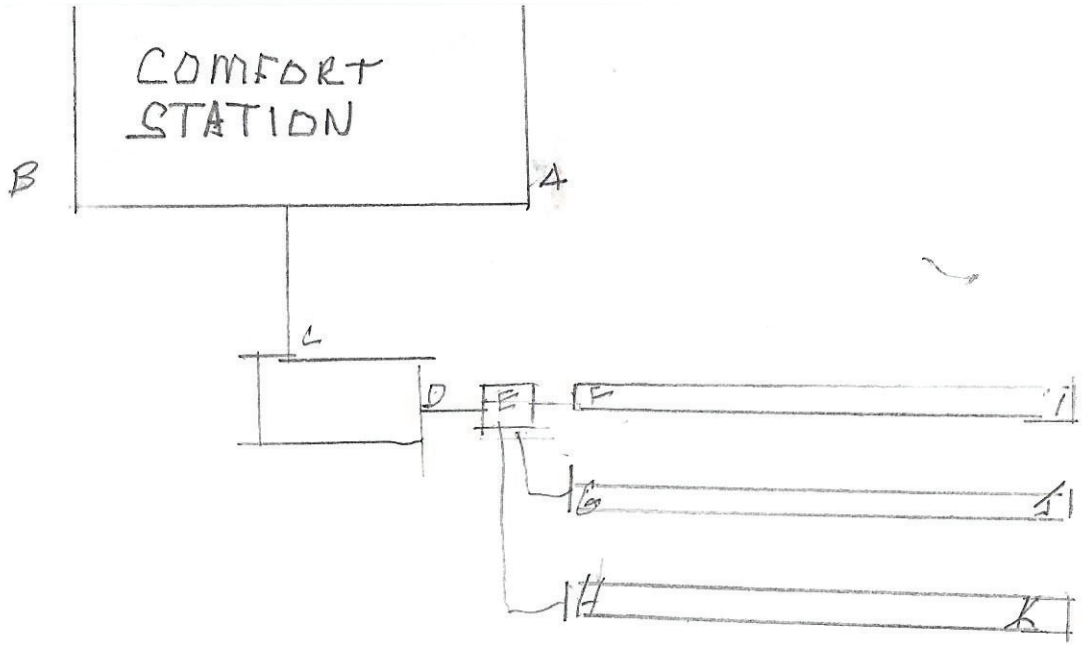


| | C | D | E | F | G | H | I | J | K |
|---|---|---|---|---|---|---|---|---|---|
| A | 17' | 15' | 15' | 16' | 21' | 27'2" | 33'9" | 37' | 41'10" |
| B | 15' | 23'7" | 26'10" | 28'2" | 31'6" | 36'4" | 52'4" | 54' | 57'6" |
| Elevations 3'7" | 5'9" | 5'11" | 5'9.5" | 6'4" | 6'6.5" | 7'2" | 6'4" | 6'7" | 7'2.25" |