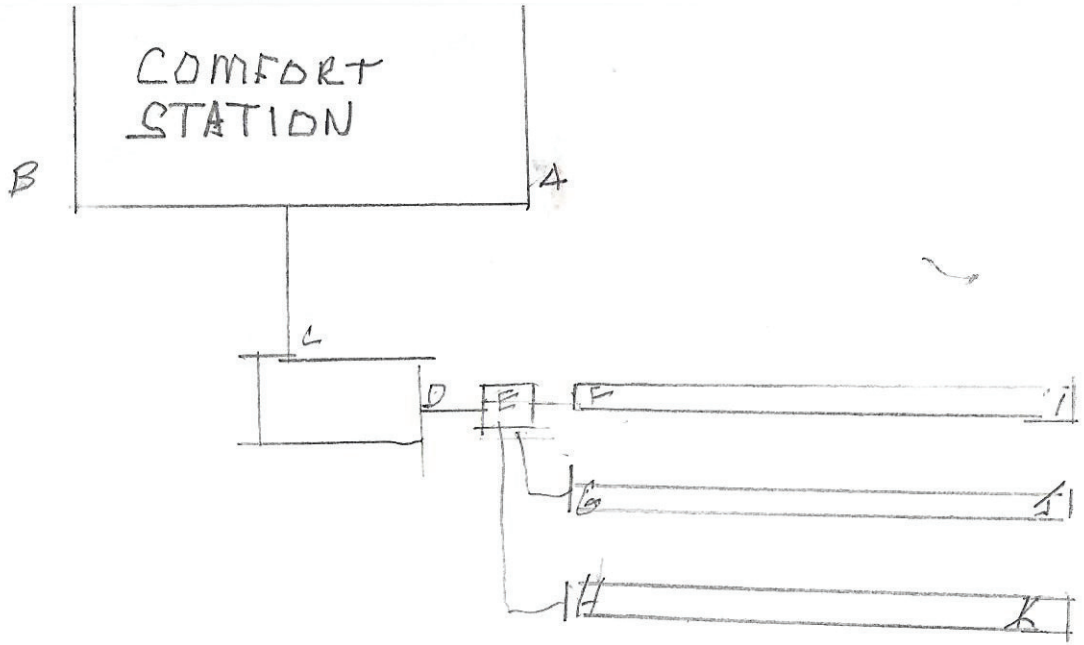

	C	D	E	F	G	H	I	J	K
A	17'	15'	15'	16'	21'	27'2"	33'9"	37'	41'10"
B	15'	23'7"	26'10"	28'2"	31'6"	36'4"	52'4"	54'	57'6"
Elevations 3'7"	5'9"	5'11"	5'9.5"	6'4"	6'6.5"	7'2"	6'4"	6'7"	7'2.25"