CTE-24MF-1

BILL OF MATERIAL	WORK ORDER NO.
REFERENCE DRAWINGS	
DRAWING NO.	TITLE

NOTE: FOR GENERAL PIPING AND INSTRUMENTATION NOTES, LEGENDS AND SYMBOLOGY REFER TO DRAWING NO. CTE-25MP-55

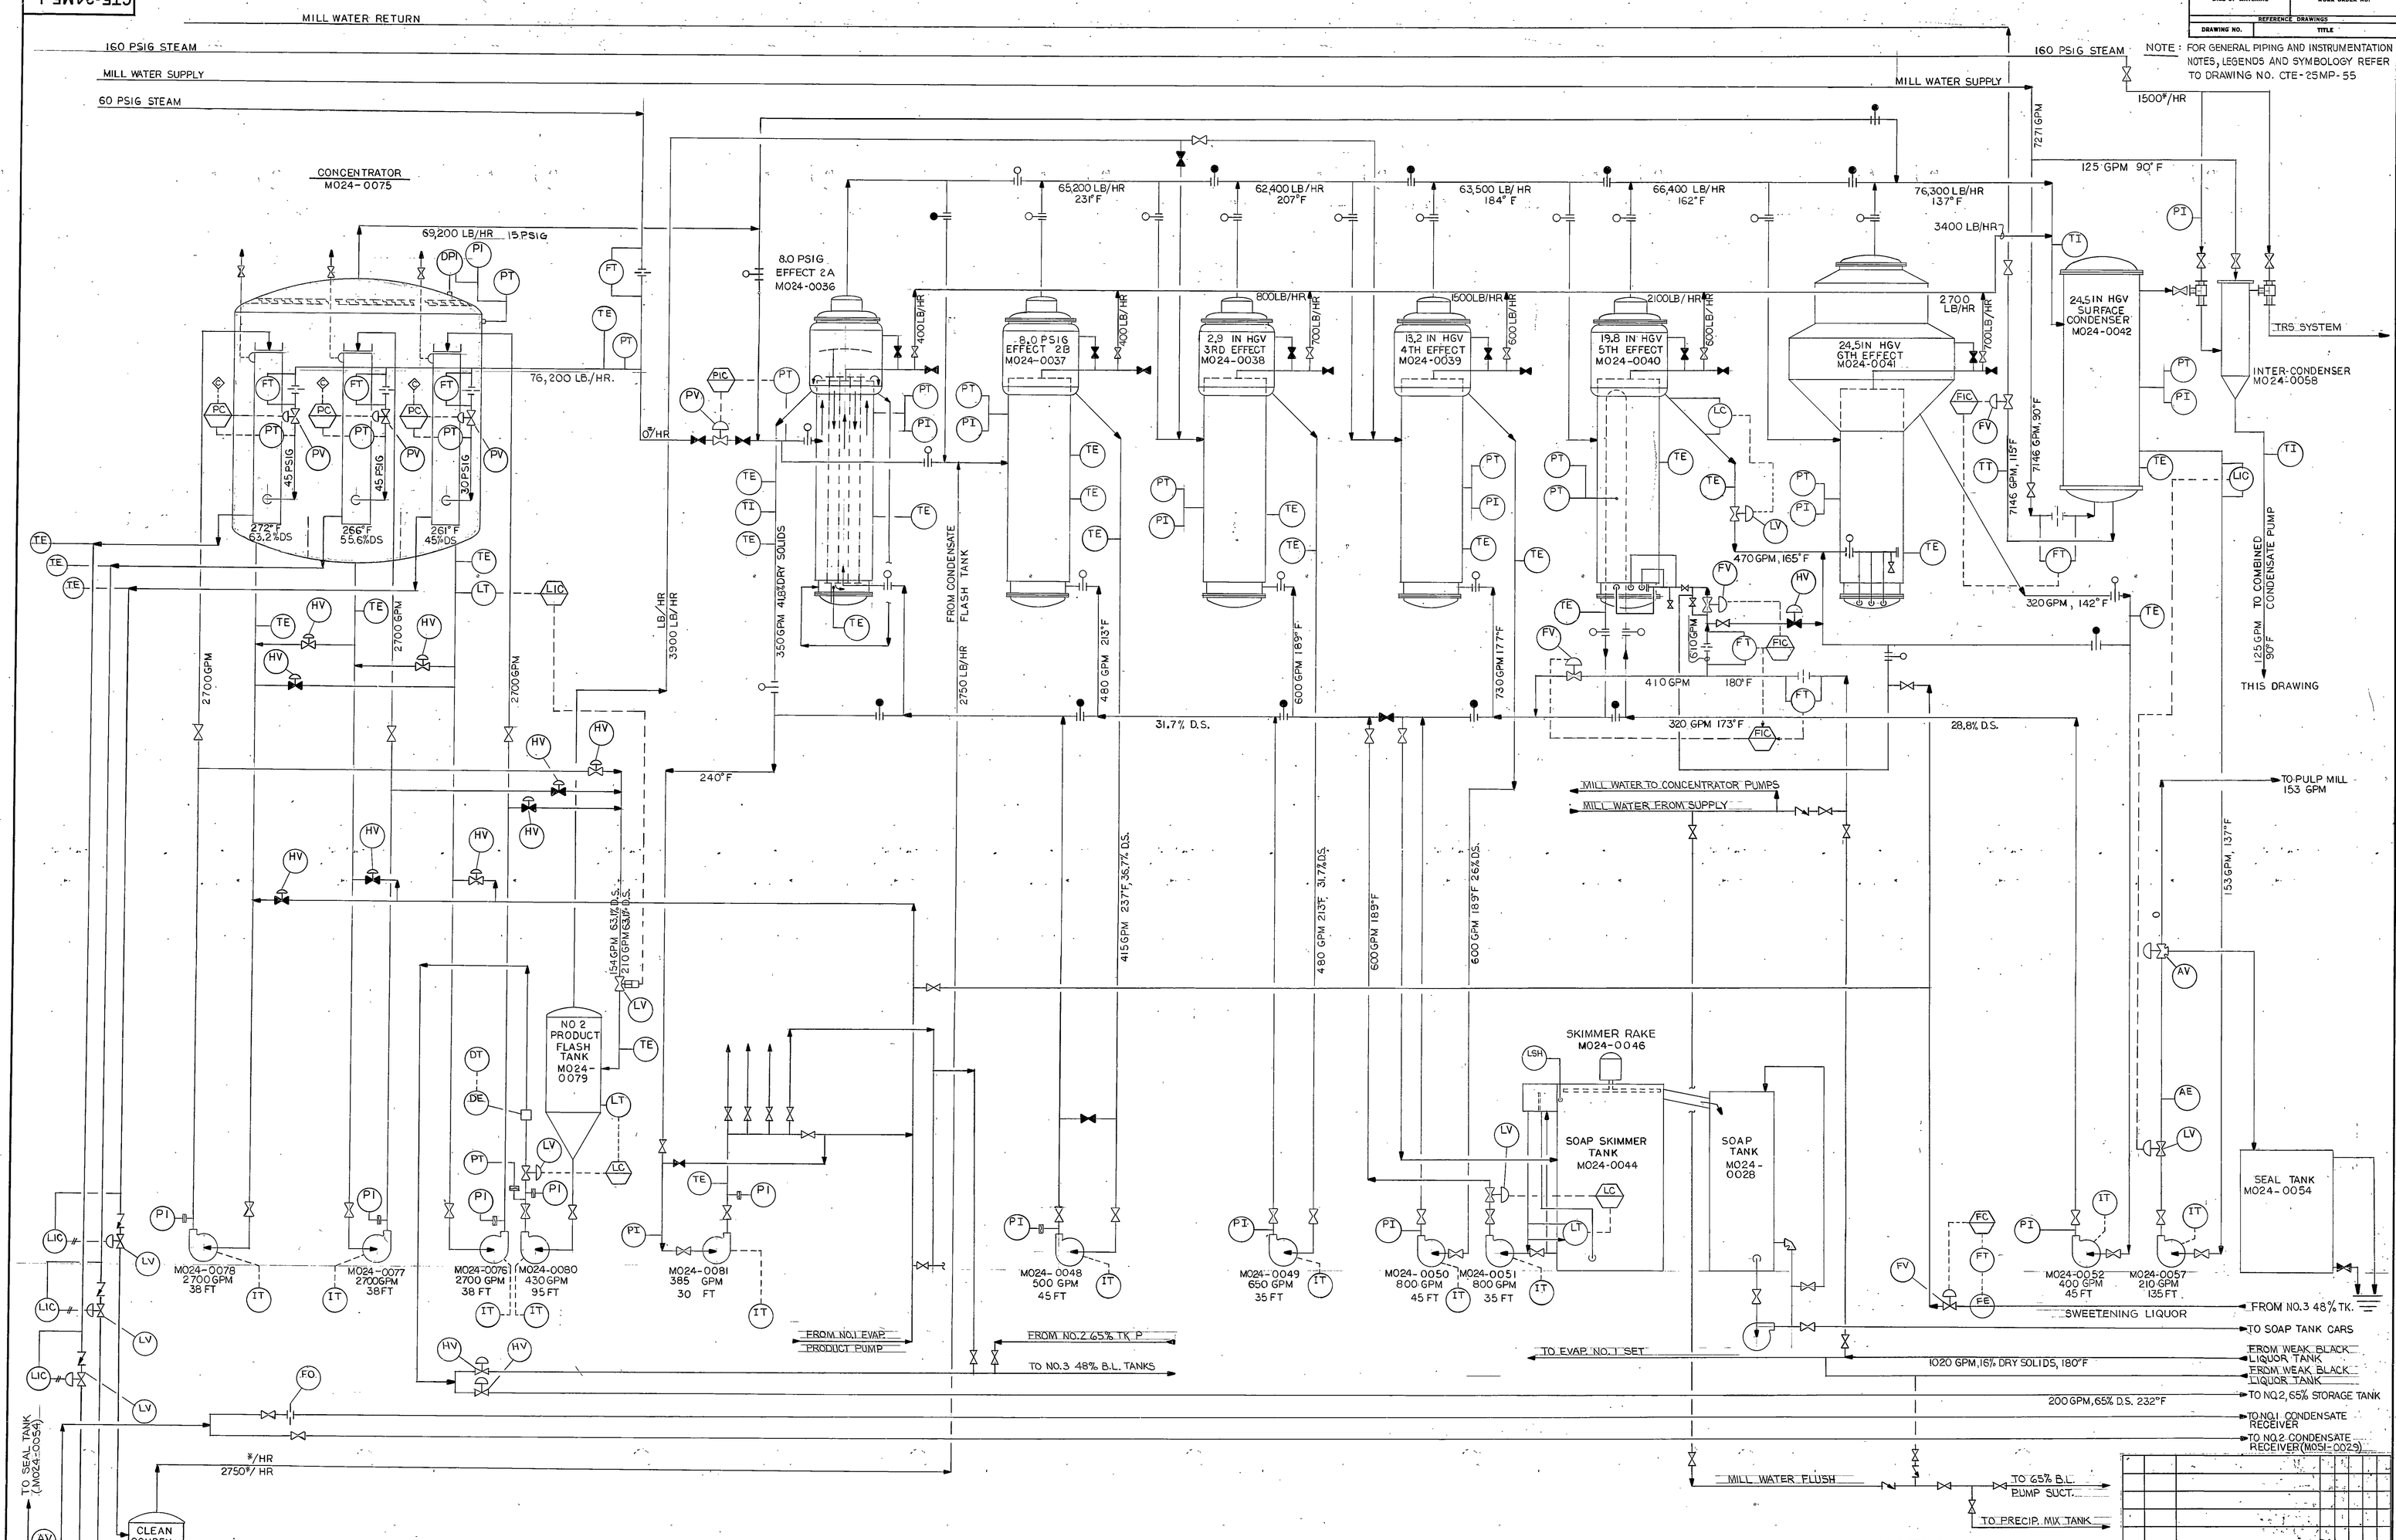

NOTES

1. DESIGN – 650 AD TONS/DAY
2. LB DRY SOLIDS/AD TON = 3158

REV.	DATE	DESCRIPTION	DRAWN	CHECKED	FIELD ENG.	PROJ. MGR.
1	1-31-85	AS BUILT				
0	6/8/84	RELEASED FOR CONSTRUCTION	WLF	MLF		
C	5/4/84	GENERAL UPDATE				
B	2/22/84	RELEASED FOR DESIGN				
A	1-3-84	FOR CLIENT APPROVAL				

NOTICE

This drawing is issued for:
- ☐ INFORMATION/REFERENCE
- ☐ BID
- ☐ CONTRACT
- ☒ CONSTRUCTION/FABRICATION

This drawing taken with other documents show the general requirements of the work and is not complete as to scope or detail.

MAIN 1893 CHAS. T. MAIN, INC. BOSTON CHARLOTTE

JOB NO. 2426-22-1000

MAIN DWG NO.

BOWATER CAROLINA CORPORATION CATAWBA, S. C.

NO.2 REC. BOILER CONVERSION EVAPORATOR PROCESS FLOW DIAGRAM

DR. CRA | SCALE NONE | DATE 11/5/82 | CKD. | APD.

DRAWING NO. CTE-24MF-1