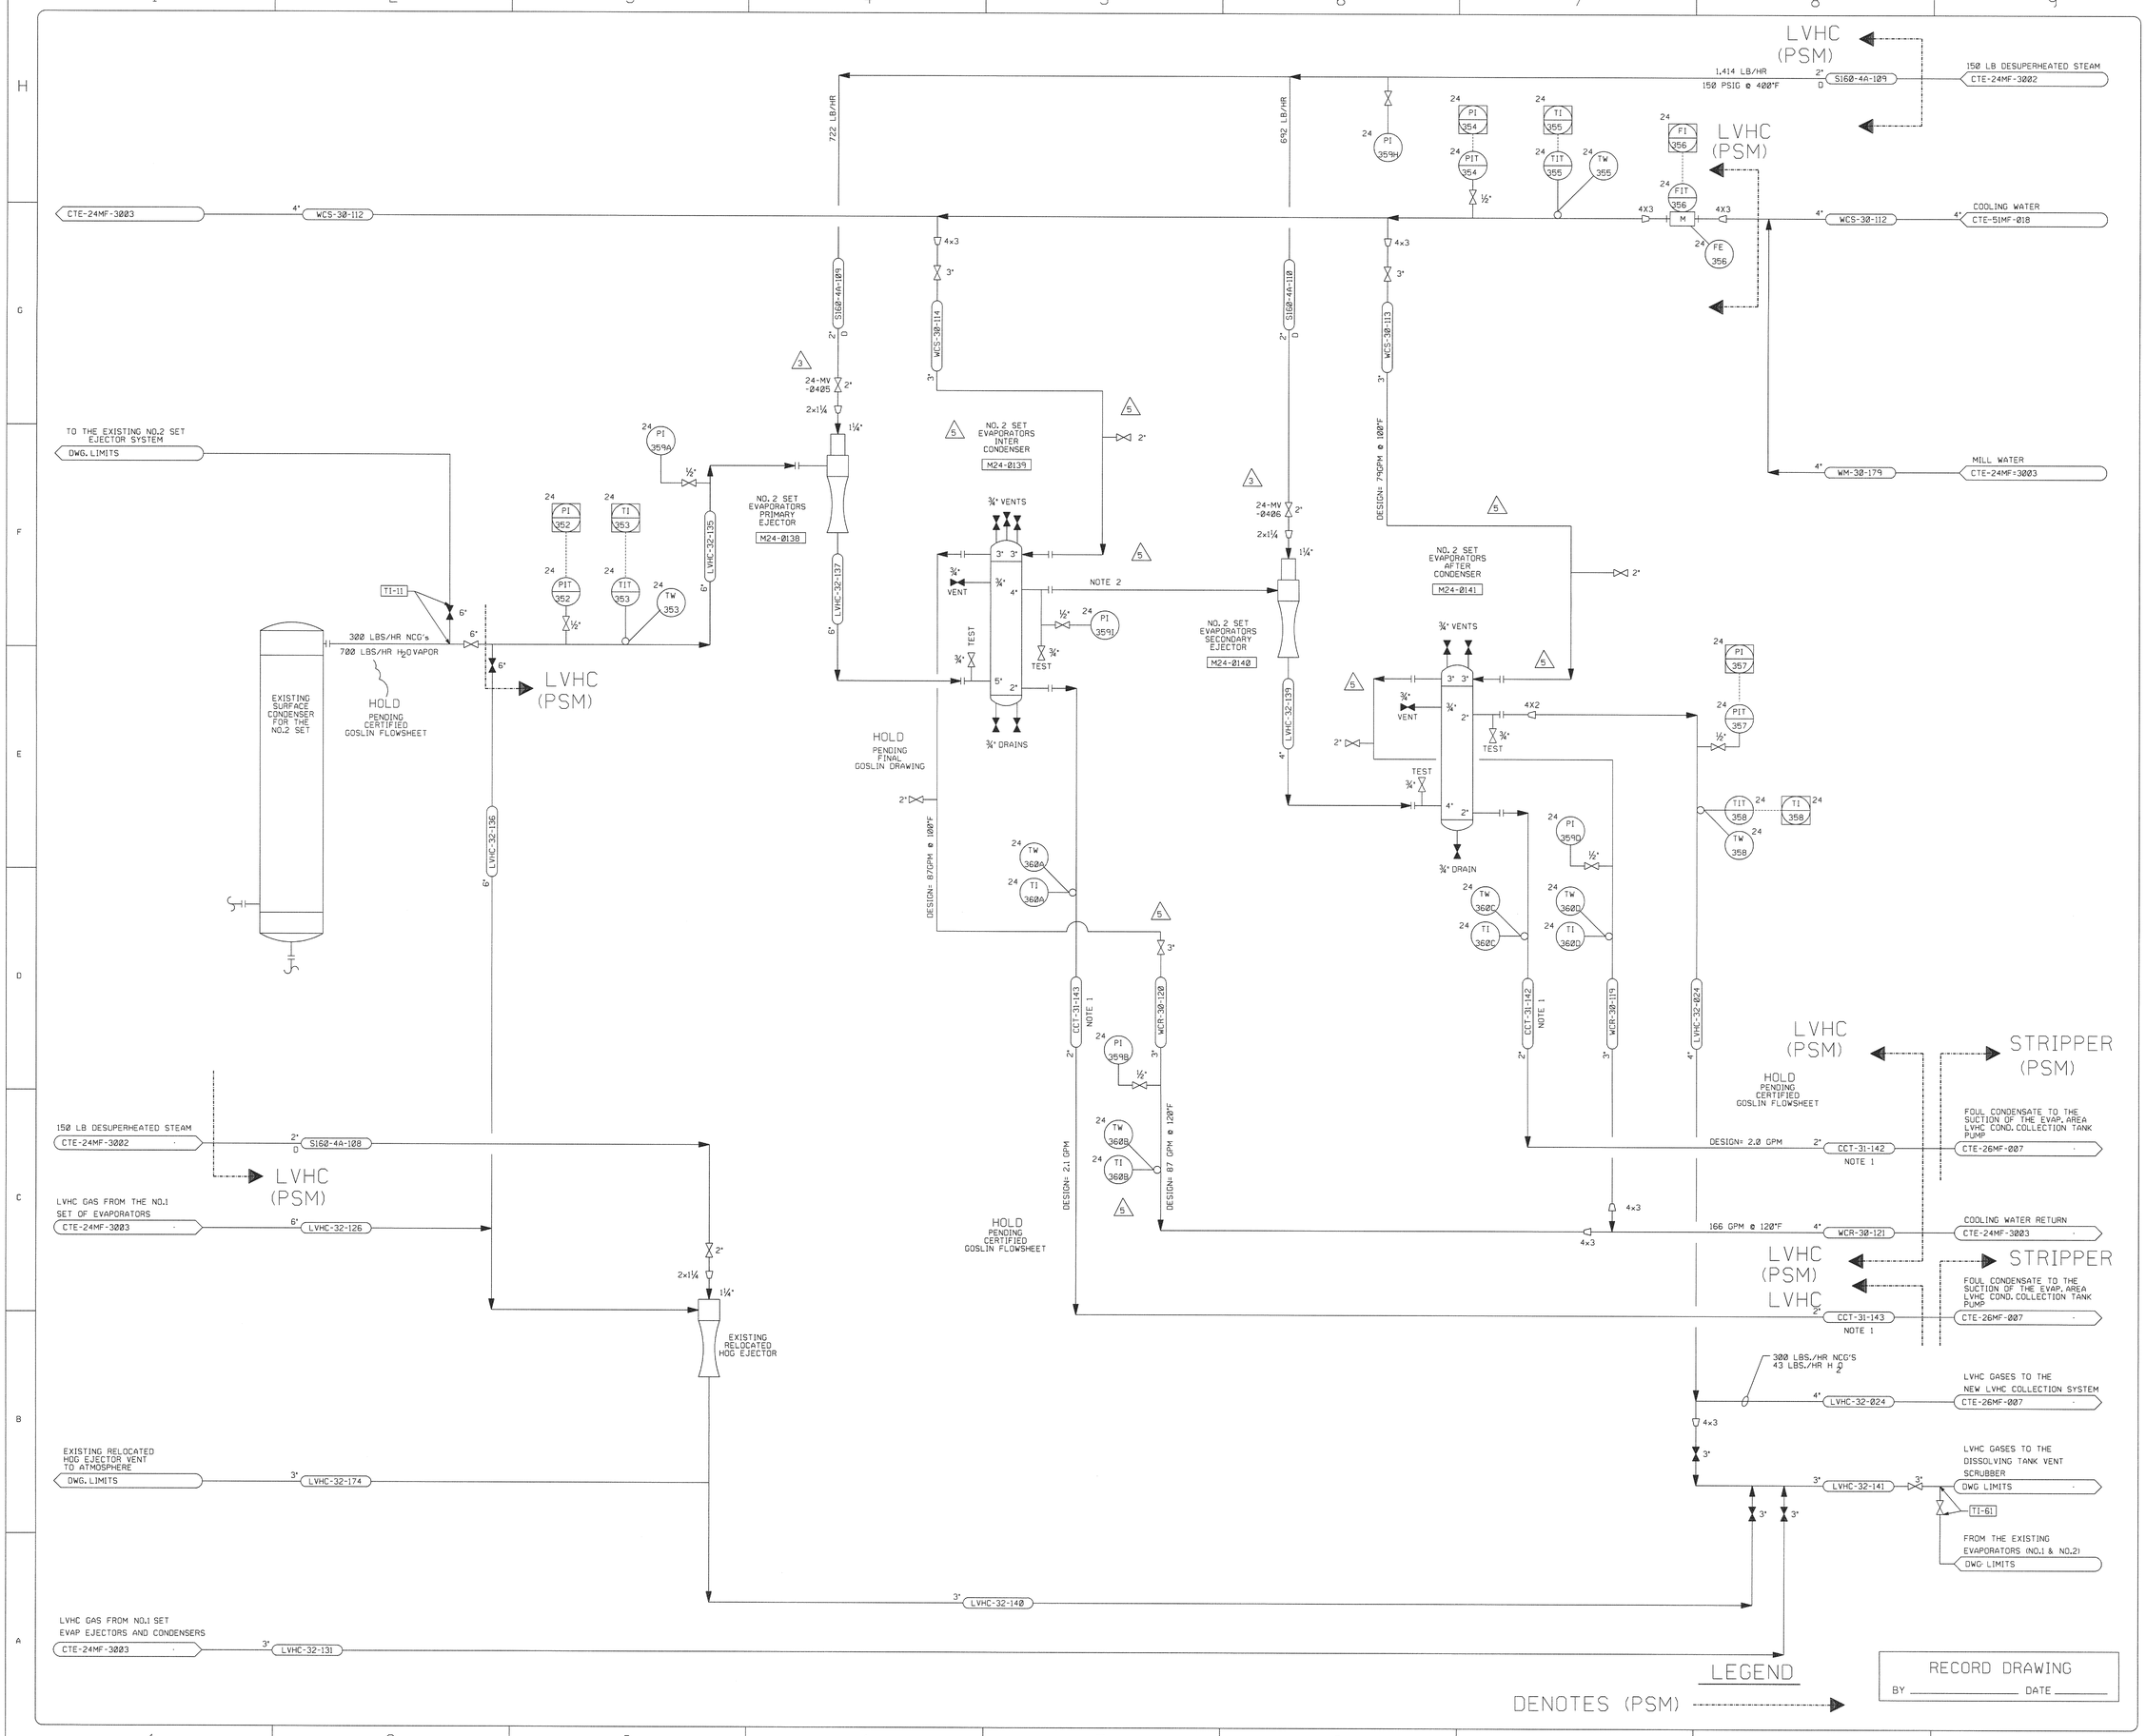


RECORD DRAWING

BY _____ DATE _____

NOTES

1. ALL VALVES ARE REMOVED ON THIS LINE TO PREVENT OVER-PRESSURE IN CONDENSER.
2. THESE TWO PIECES OF EQUIPMENT ARE SHORT-COUPLED.

| REV. NO. | CODE | CIRCLES | DATE | DESCRIPTION | CHECKED BY | APPROVED | APPROVED |
|---|---|---|---|---|---|---|---|
| 5 | LSB | | 08 11 09 | GENERAL REVISIONS | | | |
| 4 | RRE | | 09 25 02 | ADDED (PSM) PER GAH | | | |
| 3 | TTC | G - | 11 27 01 | RELEASED FOR RECORD | | | |
| 2 | TGT | B 1 | 01 26 01 | ADDED MILL WATER LINE WM-30-179 | | | |
| 1 | TGT | B 5 | 01 17 01 | ADDED LVHC-32-174; CHANGED STEAM LINES & CONDENSER DRAIN LINES | | | |
| 0 | SLC | B - | 01 04 01 | RELEASED FOR DESIGN | | | |
| A | TGT | A | 11 16 00 | RELEASED FOR CLIENT APPROVAL | | | |

NOTE: CIRCLE ALL REVISIONS, IDENTIFY WITH DIAMOND, NUMBER AND ARROW. REMOVE ONLY CIRCLE AND ARROW BEFORE NEXT REVISION.

| ISSUE CODE | | | |
|---|---|---|---|
| A | PRELIMINARY | D | MAT'L PURC. |
| B | DESIGN | E | BIDS |
| C | MAT'L T.O. | F | CONST'N |
| G | RECORD | | |

SEAL

SIGNATURE

DATE

BE&K

BE&K ENGINEERING OF NORTH CAROLINA, INC.
2000 PERIMETER PARK DRIVE, SUITE 100
MORRISVILLE, NORTH CAROLINA 27560

| | |
|---|---|
| DR. H. DODSON | DATE 10/04/00 |
| DSGN. T. TOMPKINS | FILE |
| CK. S. CURTIS | NUMBER |
| DPE T. TOMPKINS | JOB NO. 99-2069 |
| Cadfile Name: 24mf3004.dgn | |

BOWATER

DR.

COATED PAPER & PULP DIV.
P.O. Box 7, Catawba, South Carolina 29704

DRAWING TITLE
CLUSTER RULE PROJECT
LVHC COLLECTION SYS.
NO.2 EVAP. EJECT.SYS
P & I DIAGRAM

BE&K DRAWING NUMBER
069-P0-013

CLIENT DRAWING NUMBER
CTE-24MF-3004