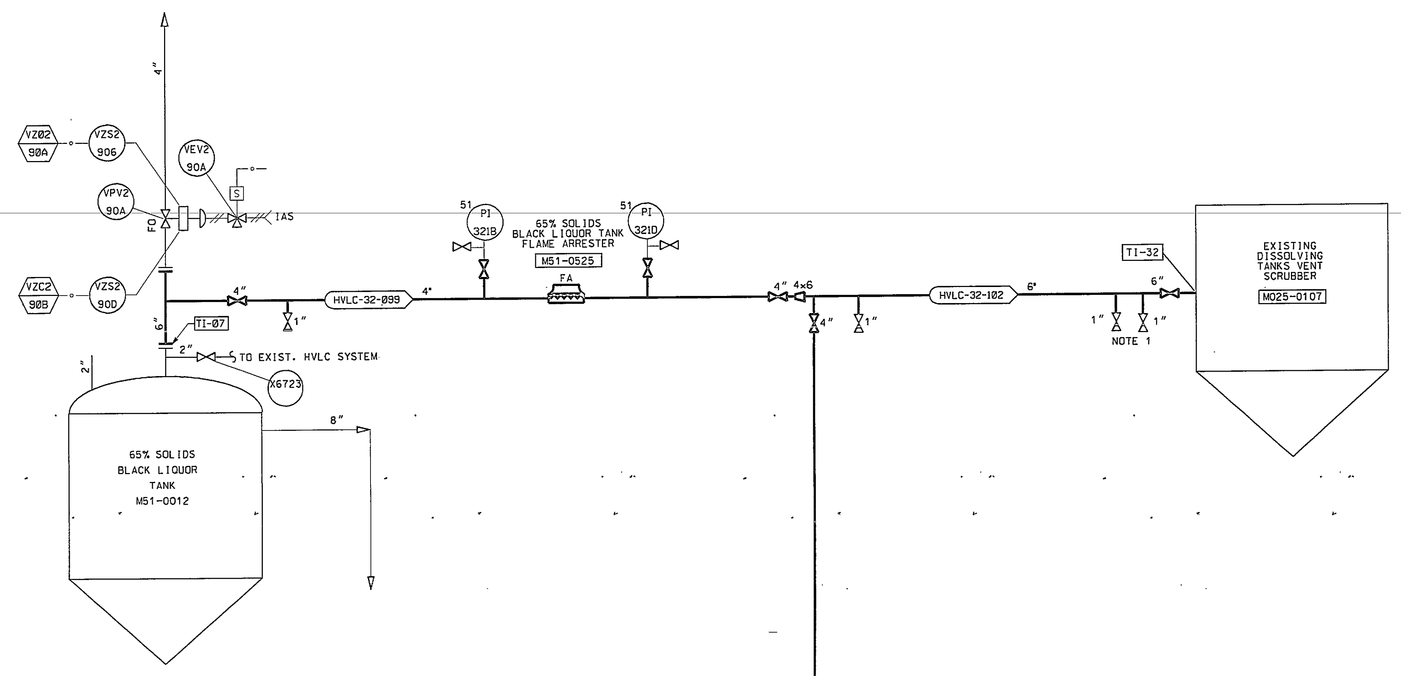

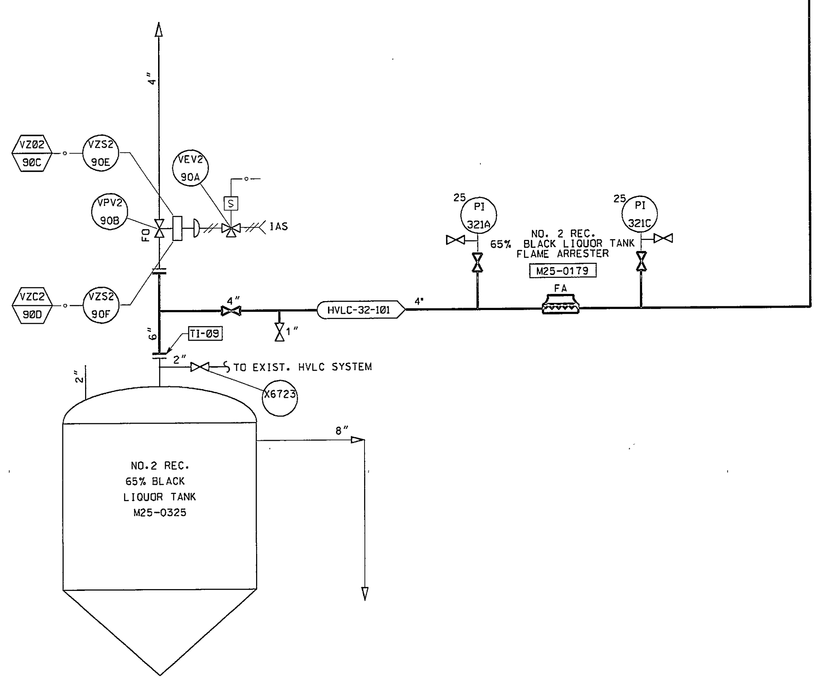

NOTES

1. THE 1" VALVED CONNECTIONS SHALL BE AT A 90° ANGLE FROM EACH OTHER.

REV. NO.	CODE	CIRCLES	DATE	DESCRIPTION	CHECKED BY	APPROVED	APPROVED
2	G	–	11 27 01	RELEASED FOR RECORD			
	TTC						
1	B	2	12 21 00	VALVES: OPEN/CLOSED			
	TGT						
0	B	–	11 16 00	RELEASED FOR DESIGN			
	TGT						
A	A		07 28 00	RELEASED FOR CLIENT	TGT		
	TGT			APPROVAL			

NOTE: CIRCLE ALL REVISIONS. IDENTIFY WITH DIAMOND, NUMBER AND ARROW. REMOVE ONLY CIRCLE AND ARROW BEFORE NEXT REVISION.

ISSUE CODE					
		C	MAT'L T.O.	F	CONST'N
A	PRELIMINARY	D	MAT'L PURC.	G	RECORD
B	DESIGN	E	BIDS		

SEAL

SIGNATURE

DATE

BE&K ENGINEERING OF NORTH CAROLINA, INC.
2020 PERIMETER PARK DRIVE, SUITE 100
MORRISVILLE, NORTH CAROLINA 27560

DR. E. HYSINGER	DATE 01/05/00
DSGN. T. TOMPKINS	FILE NUMBER
CK. D. MAXTON	
DPE T. TOMPKINS	JOB NO. 99-2069
Cadfile Name: G:#992069#26mF013.dgn	

BOWATER
COATED PAPER & PULP DIV.
P.O. Box 7, Catawba, South Carolina 29704

DRAWING TITLE
CLUSTER RULE PROJECT
LVHC COLLECTION SYS.
BLACK LIQUOR TANKS
P & I DIAGRAM

BE&K DRAWING NUMBER
069-P0-007

CLIENT DRAWING NUMBER
CTE-26MF-013

THIS ORIGINAL DRAWING RELEASED TO Bowater ON 12/13/01 FOR USE ONLY FOR WORK SHOWN. BE&K DOES NOT REPRESENT OR WARRANT CHANGES MADE AFTER THE ABOVE DATE OR THAT ALL CHANGES MADE DURING CONSTRUCTION ARE SHOWN.

RECORD DRAWING
BY _____ DATE _____

Wed Nov 21 16:06:41 2001