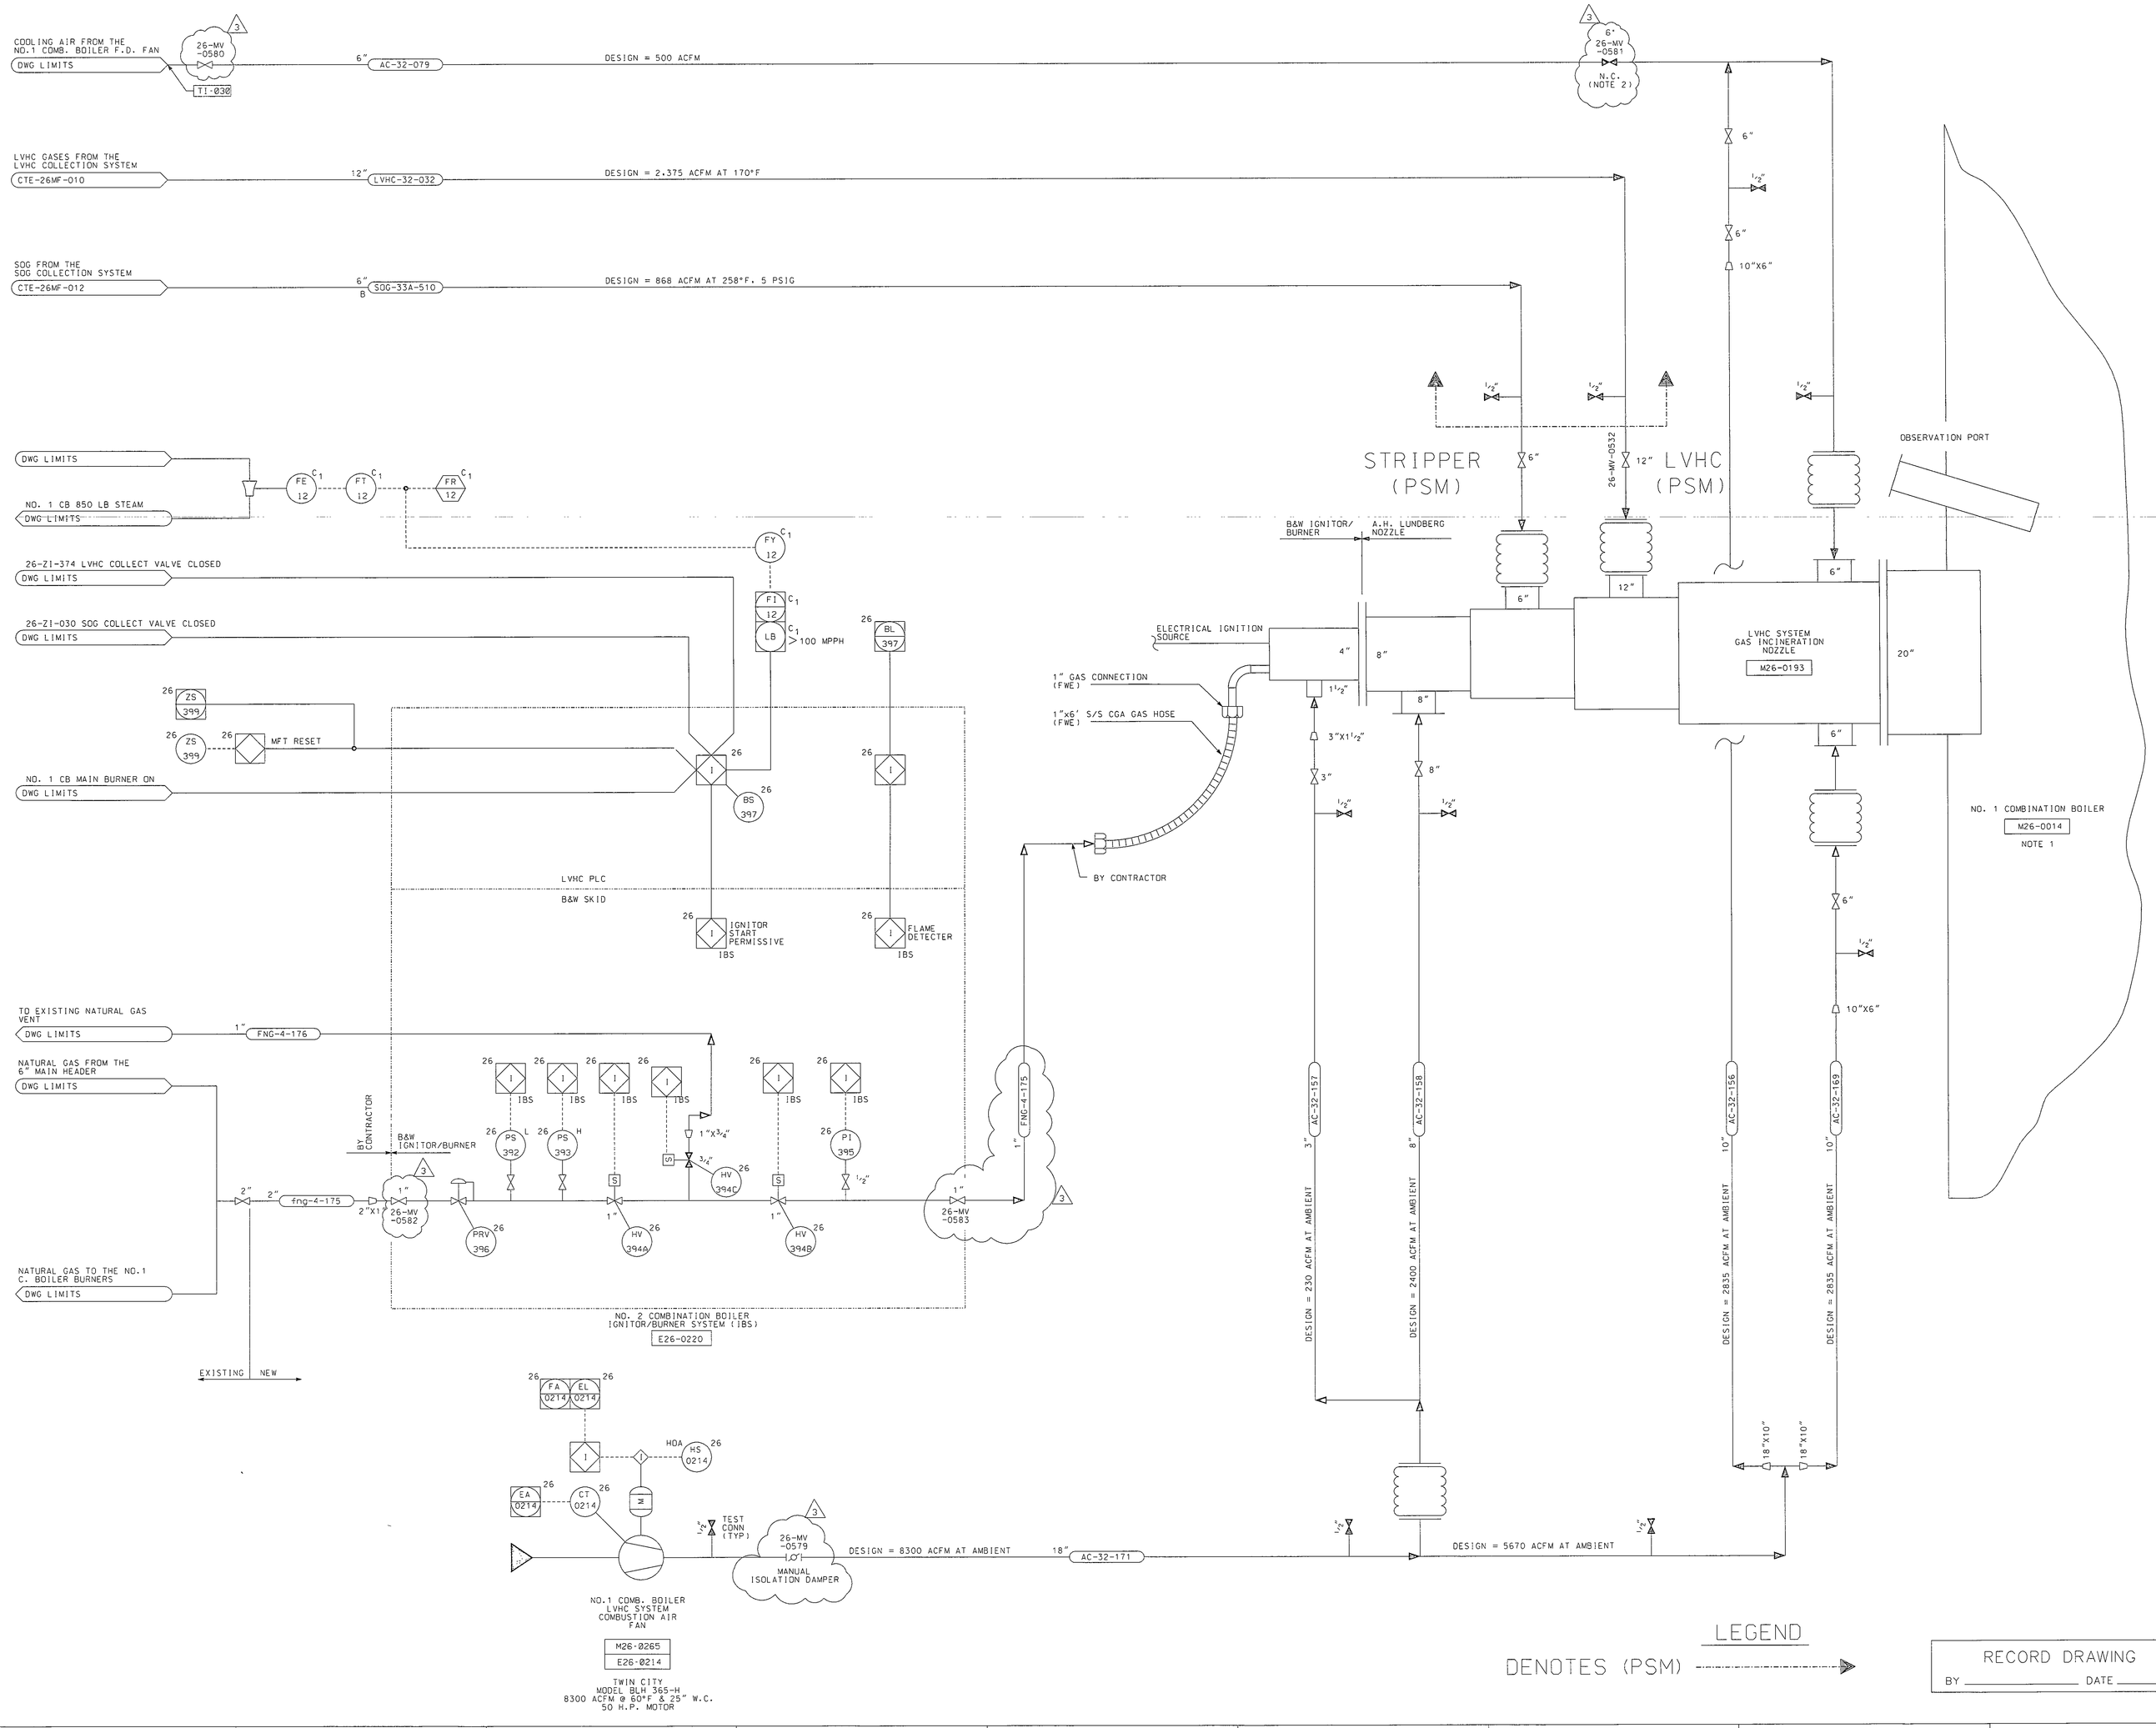

RECORD DRAWING
BY _____ DATE _____

NOTES

1. THE NO. 1 COMBINATION BOILER MODIFICATIONS AND LVHC GAS INCINERATION NOZZLE INSTALLATION WILL BE BY OTHERS.
2. VALVE IS CLOSED WHEN GASES ARE BEING BURNED IN BOILER. VALVE IS OPEN WHEN GASES ARE NOT BEING BURNED IN BOILER.
3. SEE LOOP SHEETS FOR INTERLOCK NOTES 26-397 & 26-399

REV. NO.	CODE / CIRCLES / REV. BY	DATE	DESCRIPTION	CHECKED BY / APPROVED / APPROVED
4	RRB	09 25 02	ADDED (PSM) PER GAH	
3	G - TTC	11 27 01	RELEASED FOR RECORD	
2	B TGT	10 01 26 01	ADDED MANUAL ISOLATION DAMPER & CLOSED TEST VALVES	
1	B SLC	10 01 04 01	CHG. SO. DUCT TO PIPE: ADDED REDUCERS & TEST CONN.	
0	B - SLC	12 20 00	RELEASED FOR DESIGN	
A	A - TGT		RELEASED FOR APPROVAL	SC

NOTE: CIRCLE ALL REVISIONS. IDENTIFY WITH DIAMOND. NUMBER AND ARROW. REMOVE ONLY CIRCLE AND ARROW BEFORE NEXT REVISION.

ISSUE CODE			
A	PRELIMINARY	C	MAT'L T.O.
B	DESIGN	D	MAT'L PURC.
		E	BIDS
		F	CONST'N
		G	RECORD

SEAL
SIGNATURE
DATE

BE&K ENGINEERING OF NORTH CAROLINA, INC.
2106 PERIMETER PARK DRIVE, SUITE 100
MORRISVILLE, NORTH CAROLINA 27560

DR. T. STABLES	DATE 11/16/00
DSGN. T. TOMPKINS	FILE NUMBER
CK. S. CHANDRA	
DPE T. TOMPKINS	JOB NO. 99-2069
Cadfile Name: 26mf016.dgn	

BOWATER
COATED PAPER & PULP DIV.
P O Box 7, Catawba, South Carolina 29704

DRAWING TITLE
CLUSTER RULE PROJECT
LVHC COLLECTION SYS.
NO.1 COMB. BOILER
P & I DIAGRAM

BE&K DRAWING NUMBER
N/A

CLIENT DRAWING NUMBER
CTE-26MF-016