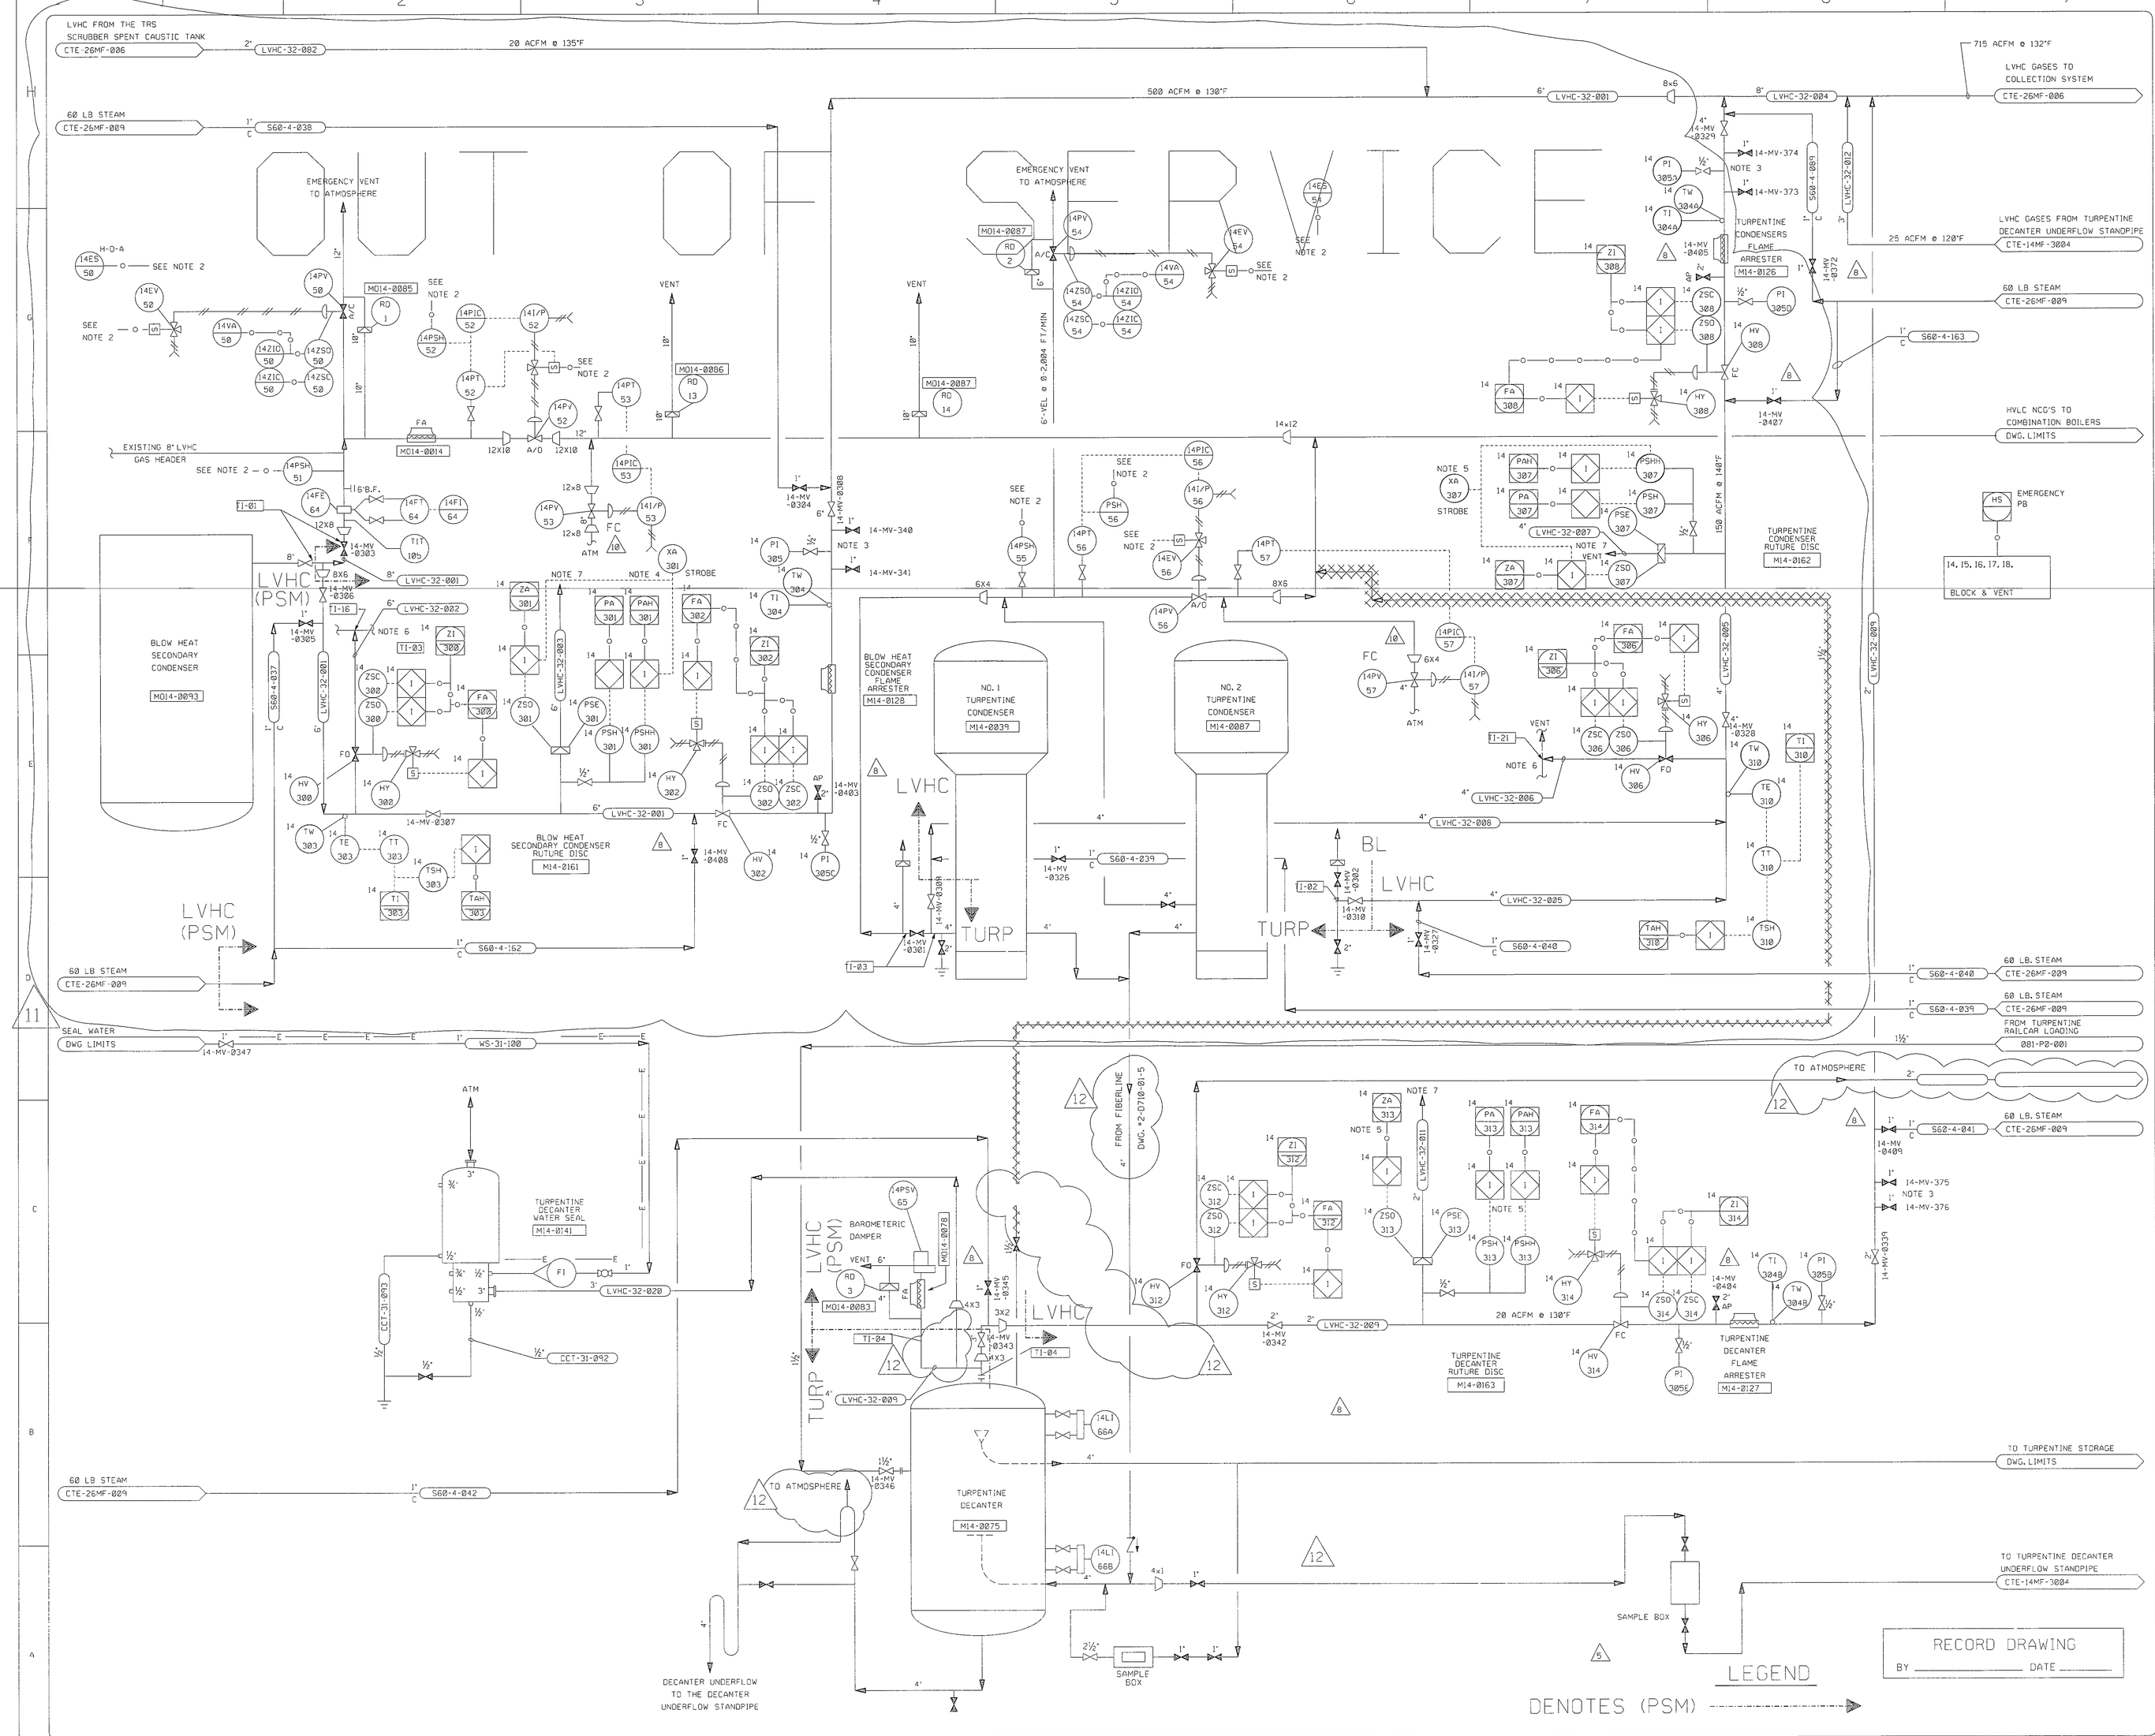

NOTES

1. FOR MORE DETAILED INFORMATION ON THE EXISTING SYSTEM SEE DRAWING CTE-26MP-10.
2. FOR DETAILED INTERLOCK INFORMATION IN THE EXISTING SYSTEM, SEE DRAWING CTE-26MP-21.
3. THE 1" VALVED CONNECTIONS SHALL BE AT A 90° ANGLE FROM EACH OTHER.
4. ACVTIVATES RUPTURE DISC STROBE LIGHT 14-XA-301. LOCA'ED IN THE PULP MILL AREA, BETWEEN BHA AND DIGESTER #9.
5. ACVTIVATES RUPTURE DISC STROBE LIGHT 14-XA-307. LOCATED IN THE PULP MILL AREA, NEAR COL. 1.1A1.
6. THIS VENT LINE TIES INTO THE EXISTING HIGH VENT. THE VENT WILL DIRECT ALL GASES AWAY FROM PERSONNEL. 12
7. THIS VENT WILL BE DIRECTED AWAY FROM PERSONNEL
8. MOC 04-28-03 11

REFERENCE DWG.
CTE-26MP-10
CTE- 14MF-3004

REV. NO.	CODE	CIRCLES	DATE	DESCRIPTION	CHECKED BY	APPROVED	APPROVED
10	RRB		12 15 02	ADDED VALVE FAIL POSITION			
9	RRB	-	09 25 02	ADDED (PSM) PER GAH			
8	TTC	G -	11 27 01	RELEASED FOR RECORD			
7	TGT	B 13	01 26 01	CHANGED INSTRUMENT TAGS & INSTRUMENT CONNECTION ADDED VALVE NUMBERS	TGT	JOC	
6	TGT	B 6	12 21 00	ADDED STEAM OUTS; REMOVED VALVES & DRAIN			
5	TGT	B 9	11 16 00	GENERAL REVISION			
4	TGT	B 31	07 28 00	INCORPORATED HAZOP COMMENTS RELEASED FOR DESIGN	TGT	JOC	
3	TGT	B 29	05 12 00	ADDED LINE NO.S	TGT	JOC	
2	TGT	B 12	05 04 00	GENERAL REVISIONS	TGT	JOC	
1	TGT	B 3	23 27 00	GENERAL REVISIONS			
12	LSJ	B 0	02 20 06	RELEASED FOR DESIGN			
11	LSJ		04 21 04	RELEASED FOR CLIENT APPROVAL	DWR		

NOTE: CIRCLE ALL REVISIONS. IDENTIFY WITH DIAMOND NUMBER AND ARROW. REMOVE ONLY CIRCLE AND ARROW BEFORE NEXT REVISION.

ISSUE CODE			
A	PRELIMINARY	C	MAT'L T.O.
B	DESIGN	D	MAT'L PURC.
		E	BIDS
		F	CONST'N
		G	RECORD

SEAL

SIGNATURE

DATE

BE&K ENGINEERING OF NORTH CAROLINA, INC.
2000 PERIMETER PARK DRIVE, SUITE 100
MORRISVILLE, NORTH CAROLINA 27560

DR. E. HYSINGER	DATE 2-7-00
DSGN. T.TOMPKINS	FILE
CK. D.MAXTON	NUMBER
DPE T.TOMPKINS	JOB NO. 99-2069
Cadfile Name: 26mf005.dgn	

abitibi bowater

DRAWING TITLE
CLUSTER RULE PROJECT
LVHC COLLECTION SYS
BHR AND TURP. REC.
P & I DIAGRAM

BE&K DRAWING NUMBER
069-P0-001

CLIENT DRAWING NUMBER
CTE-26MF-005

RECORD DRAWING
BY _____ DATE _____