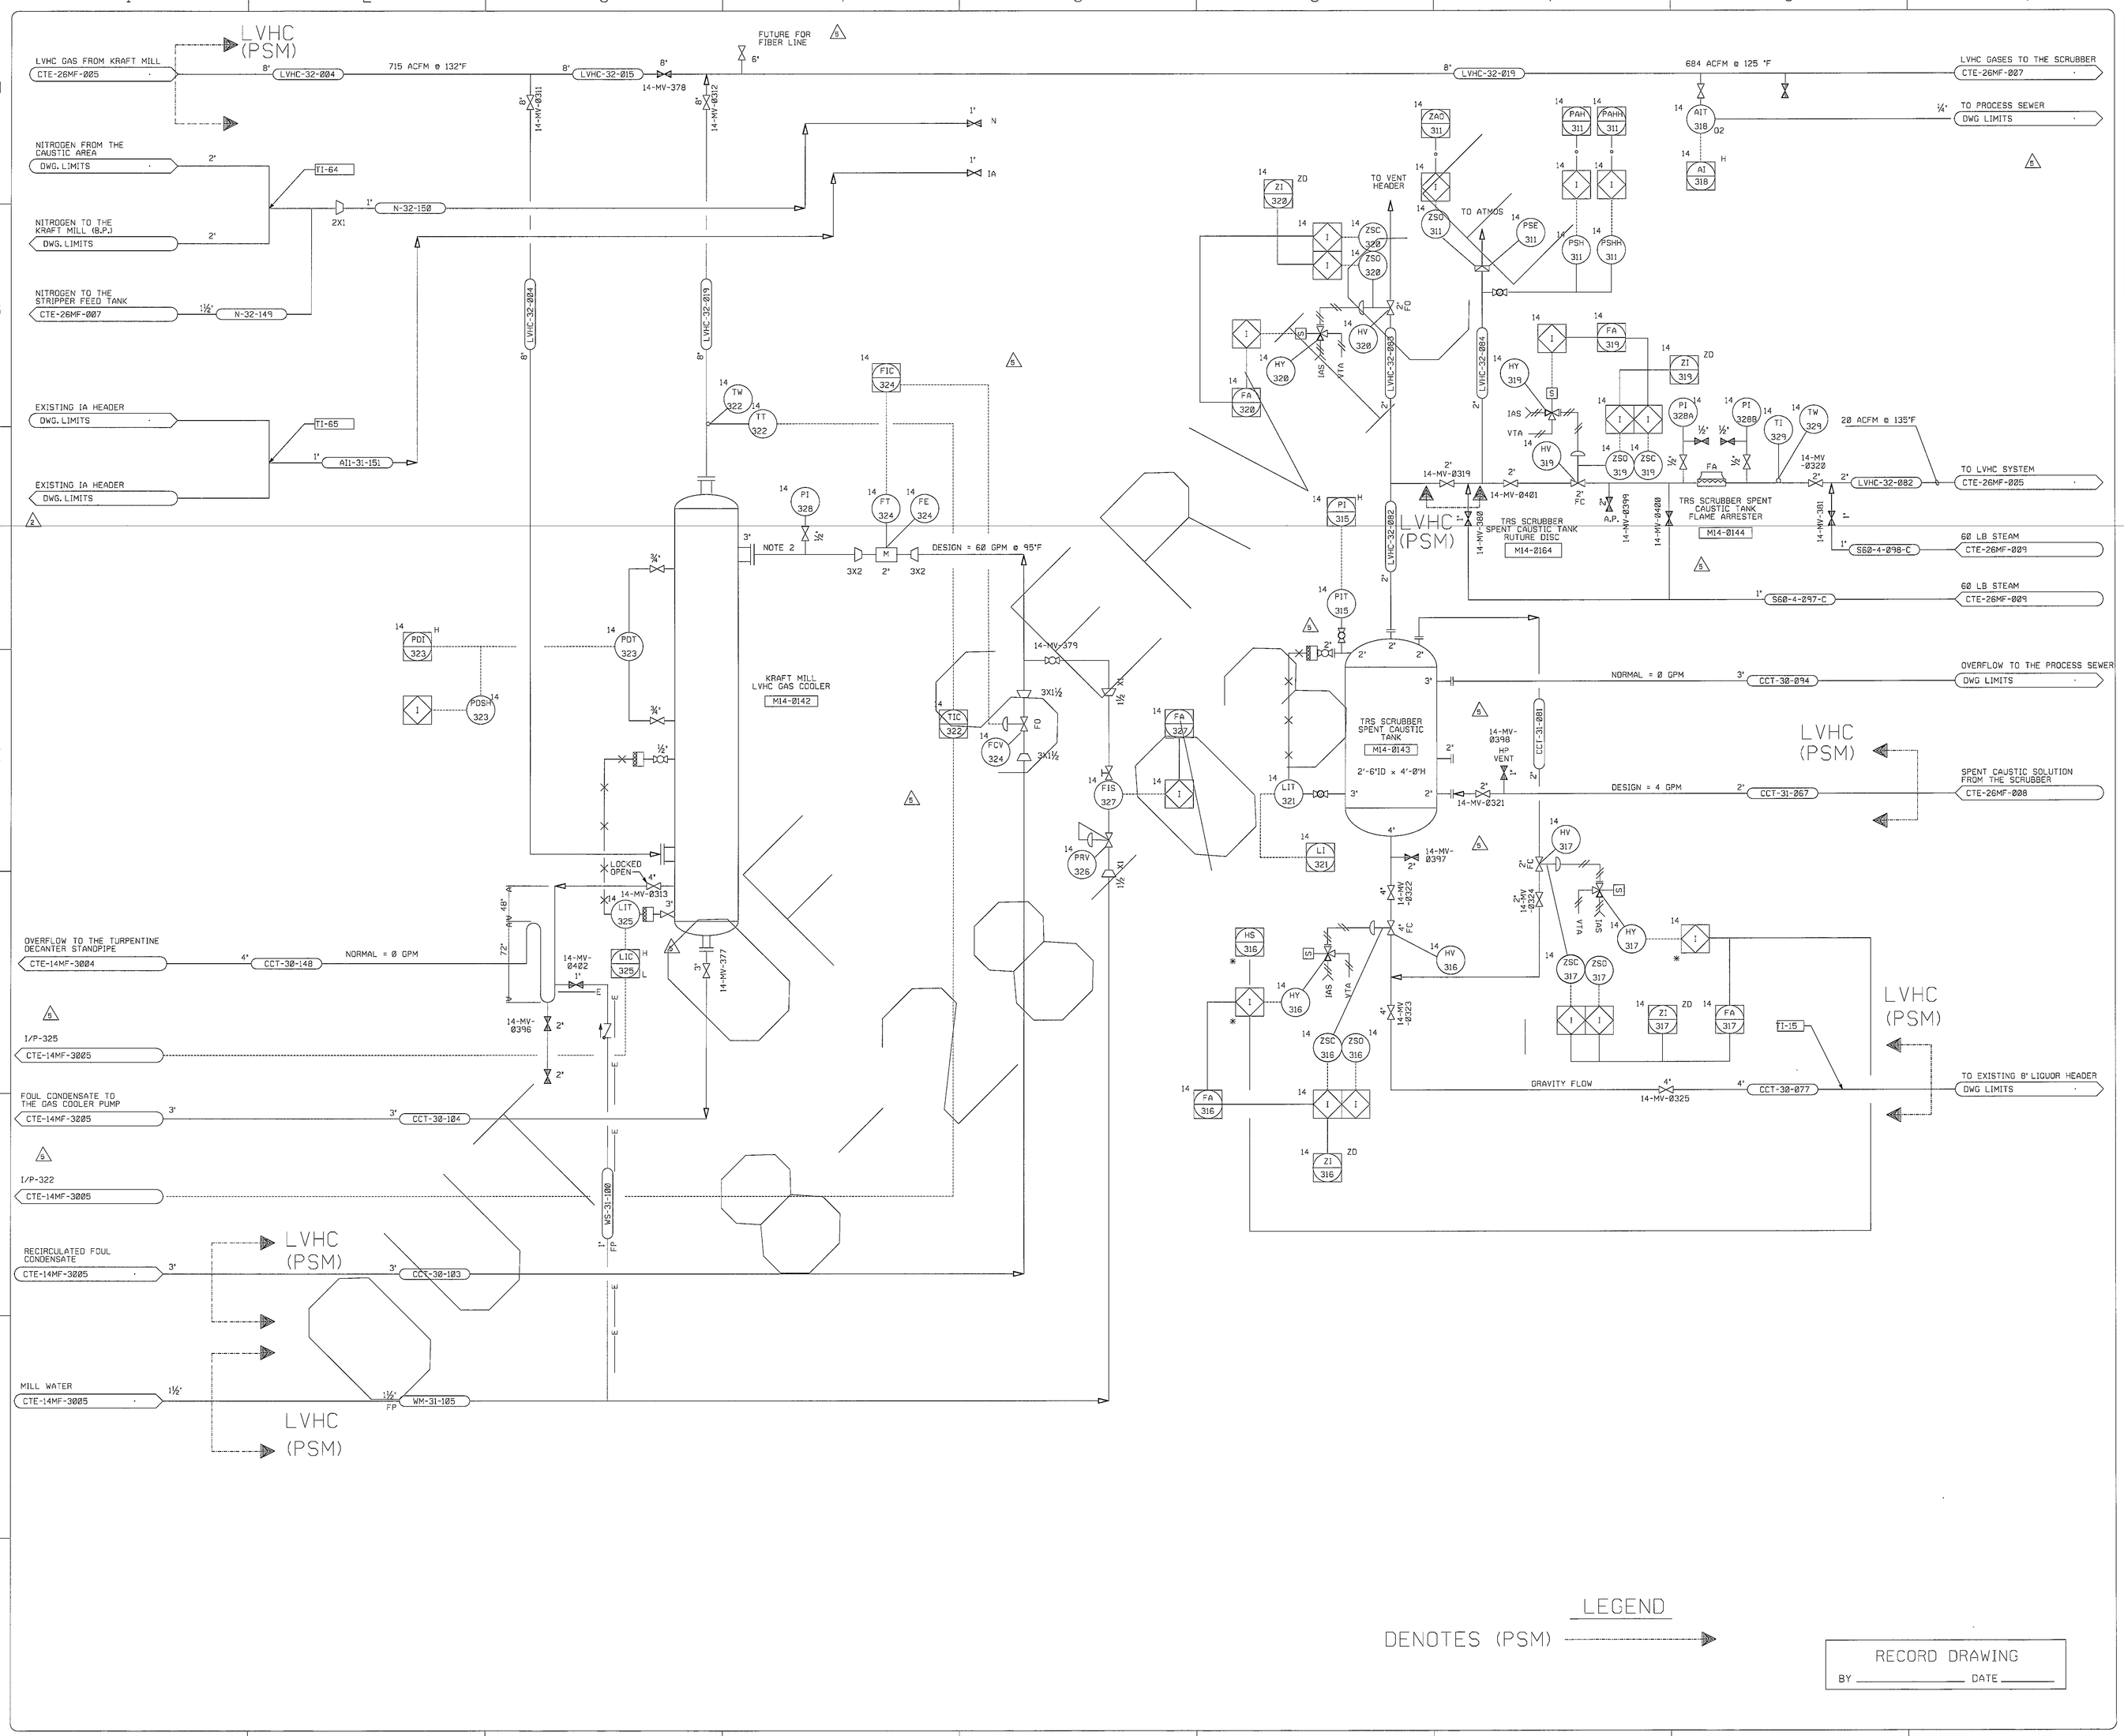

RECORD DRAWING

BY _____ DATE _____

NOTES

1. REFERENCE P&ID CTE-26MP-21
2. MINIMUM INLET PRESSURE = 10 PSIG AT 60 GPM.
3. MOC 04-28-02 (7)

* TIE TO BATCH DIGESTER CONTROLS.

REV. NO.	CODE / REV. BY	CIRCLES	DATE	DESCRIPTION	CHECKED BY	APPROVED	APPROVED
7	LSJ		04 21 04	OUT OF SERVICE 8-28-03 MOC 04-28-02			
6	RRB		09 25 02	ADDED (PSM) PER GAH			
5	G - RDT		11 27 01	RELEASED FOR RECORD			
4	B TGT	14	01 26 21	CHANGED INSTRUMENT TAGS 14-TCV-322 SIZE AND ADDED VALVE NUMBERS			
3	B - TGT		12 21 00	ADDED VALVES, DRAIN & LINE NUMBERS; REMOVED HOLD			
2	B TGT	4	11 16 00	ADDED FLOWS AND TEMPERATURES			
1	B TGT		12 07 28 00	INCORPORATED HAZOP COMMENTS RELEASED FOR DESIGN			
0	B TGT		06 30 00	RELEASED FOR DESIGN AND HAZOP REVIEW	TGT	JGC	
A	A TGT		06 12 00	RELEASED FOR CLIENT APPROVAL			

NOTE: CIRCLE ALL REVISIONS. IDENTIFY WITH DIAMOND, NUMBER AND ARROW. REMOVE ONLY CIRCLE AND ARROW BEFORE NEXT REVISION.

ISSUE CODE			
A	PRELIMINARY	C	MAT'L T.O.
B	DESIGN	D	MAT'L PURC.
		E	BIDS
		F	CONST'N
		G	RECORD

SEAL

SIGNATURE

DATE

BE&K ENGINEERING OF NORTH CAROLINA, INC.
2000 PERIMETER PARK DRIVE, SUITE 100
MORRISVILLE, NORTH CAROLINA 27560

DR. E. HYSINGER	DATE 01/05/00
DSGN. T. TOMPKINS	FILE NUMBER
CK.	
DPE T. TOMPKINS	JOB NO. 99-2069
Cadfile Name: **DGN**	

BOWATER
COATED PAPER & PULP DIV.
P.O. Box 7, Catawba, South Carolina 29704

DRAWING TITLE
CLUSTER RULE PROJECT
LVHC COLLECTION SYS.
KRAFT MILL
P & I DIAGRAM

BE&K DRAWING NUMBER
069-P0-006

CLIENT DRAWING NUMBER
CTE-26MF-006

SYTIME