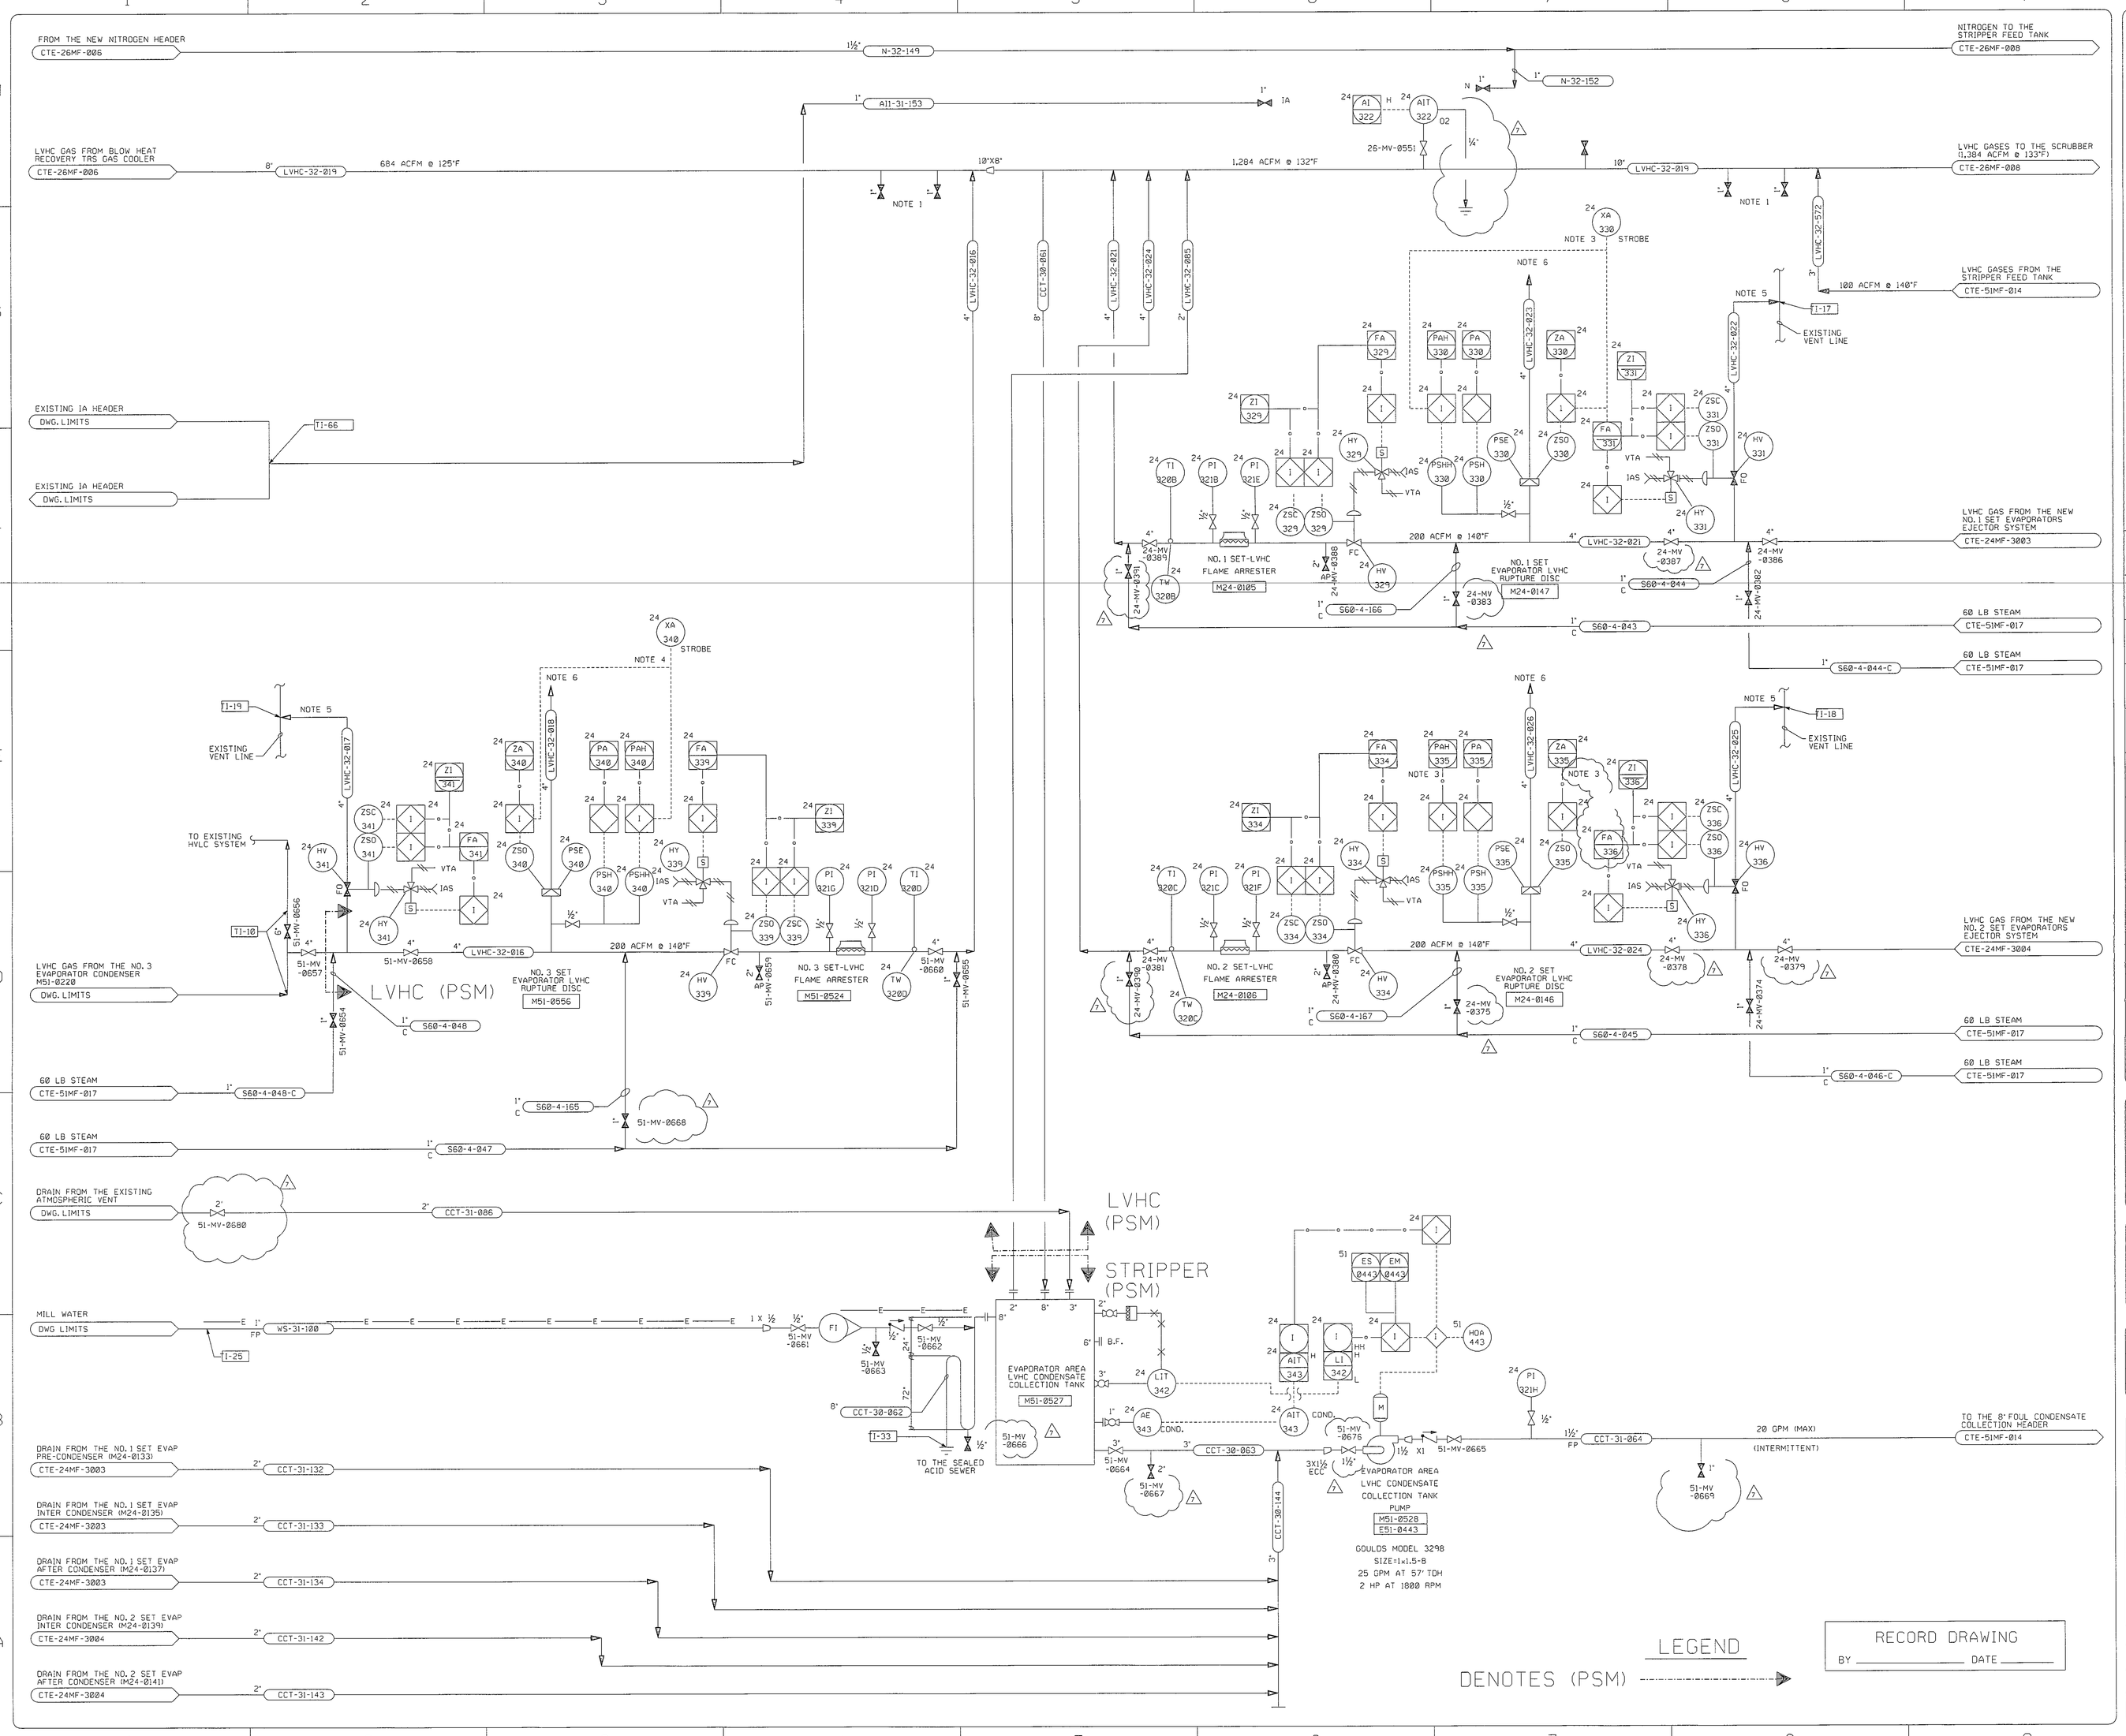

RECORD DRAWING
BY _____ DATE _____

NOTES

1. THE 1" VALVED CONNECTIONS SHALL BE AT A 90° ANGLE FROM EACH OTHER.
2. THE POTENTIAL VACUUM OF THE EVAPORATOR EJECTORS WILL BE CONSIDERED DURING THE PIPING DESIGN.
3. ACTIVATES RUPTURE DISC STROBE LIGHT 24-XA-330, LOCATED IN EVAPORATOR AREA, NEAR COL. DB24.
4. ACTIVATES RUPTURE DISC STROBE LIGHT 24-XA-340, LOCATED IN EVAPORATOR AREA, NEAR COL. B20.
5. THIS VENT LINE TIES INTO THE EXISTING "HIGH" VENT. THE VENT WILL DIRECT ALL GASES AWAY FROM PERSONNEL.
6. THIS VENT WILL BE DIRECTED AWAY FROM PERSONNEL

REV. NO.	CODE	CIRCLES	DATE	DESCRIPTION	CHECKED BY	APPROVED	APPROVED
8	-		09	ADDED (PSM)			
	RRB		25	PER GAH			
			02				
7	G	-	01	RELEASED FOR RECORD			
	RDT		27				
			01				
6	B	7	01	CHANGED INSTRUMENT TAG			
	TGT		26	ADDED DRAIN LINES			
			01				
5	B	11	12	ADDED STEAM OUTS &			
			21	DRAINS; REMOVED			
	TGT		00	CCT-30-088 & CCT-30-068			
4	B	12	11	ADDED FLOWS AND			
			16	TEMPERATURES			
	TGT		00				
3	B	21	07	INCORPORATED HAZOP			
			28	COMMENTS			
	TGT		00	RELEASED FOR DESIGN			
2	B	24	06	RELEASED FOR DESIGN			
			12				
	TGT		00				TGT JOC
1	B	3	03	ADDED INSTRUMENT NO.'S			
			27				
	TGT		00			TGT JOC	
0	B	0	03	RELEASED FOR DESIGN	BHH		
			02			TGT	
	TGT		00			TGT JOC	
A	A		02	RELEASED FOR CLIENT			
			07	APPROVAL		TGT	
	TGT		00			TGT JOC	

NOTE: CIRCLE ALL REVISIONS. IDENTIFY WITH DIAMOND, NUMBER AND ARROW. REMOVE ONLY CIRCLE AND ARROW BEFORE NEXT REVISION.

ISSUE CODE			
A	PREL(M)NARY	C	MAT'L T.O.
B	DESIGN	D	MAT'L PURC.
		E	BIDS
		F	CONST'N
		G	RECORD

SEAL

SIGNATURE

DATE

BE&K

BE&K ENGINEERING OF NORTH CAROLINA, INC.
3000 PERIMETER PARK DRIVE, SUITE 100
MORRISVILLE, NORTH CAROLINA 27560

DR. E. HYSINGER	DATE 01/05/00
DSGN. T. TOMPKINS	FILE
CK. D.MAXTON	NUMBER
DPE T. TOMPKINS	JOB NO. 99-2069
Cadfile Name: 26mf007.dgn	

BOWATER

DR. COATED PAPER & PULP DIV.
P.O. Box 7, Catawba, South Carolina 29704

DRAWING TITLE
CLUSTER RULE PROJECT
LVHC COLLECTION SYS.
POWER HOUSE
P & I DIAGRAM

BE&K DRAWING NUMBER
069-P0-002

CLIENT DRAWING NUMBER
CTE-26MF-007