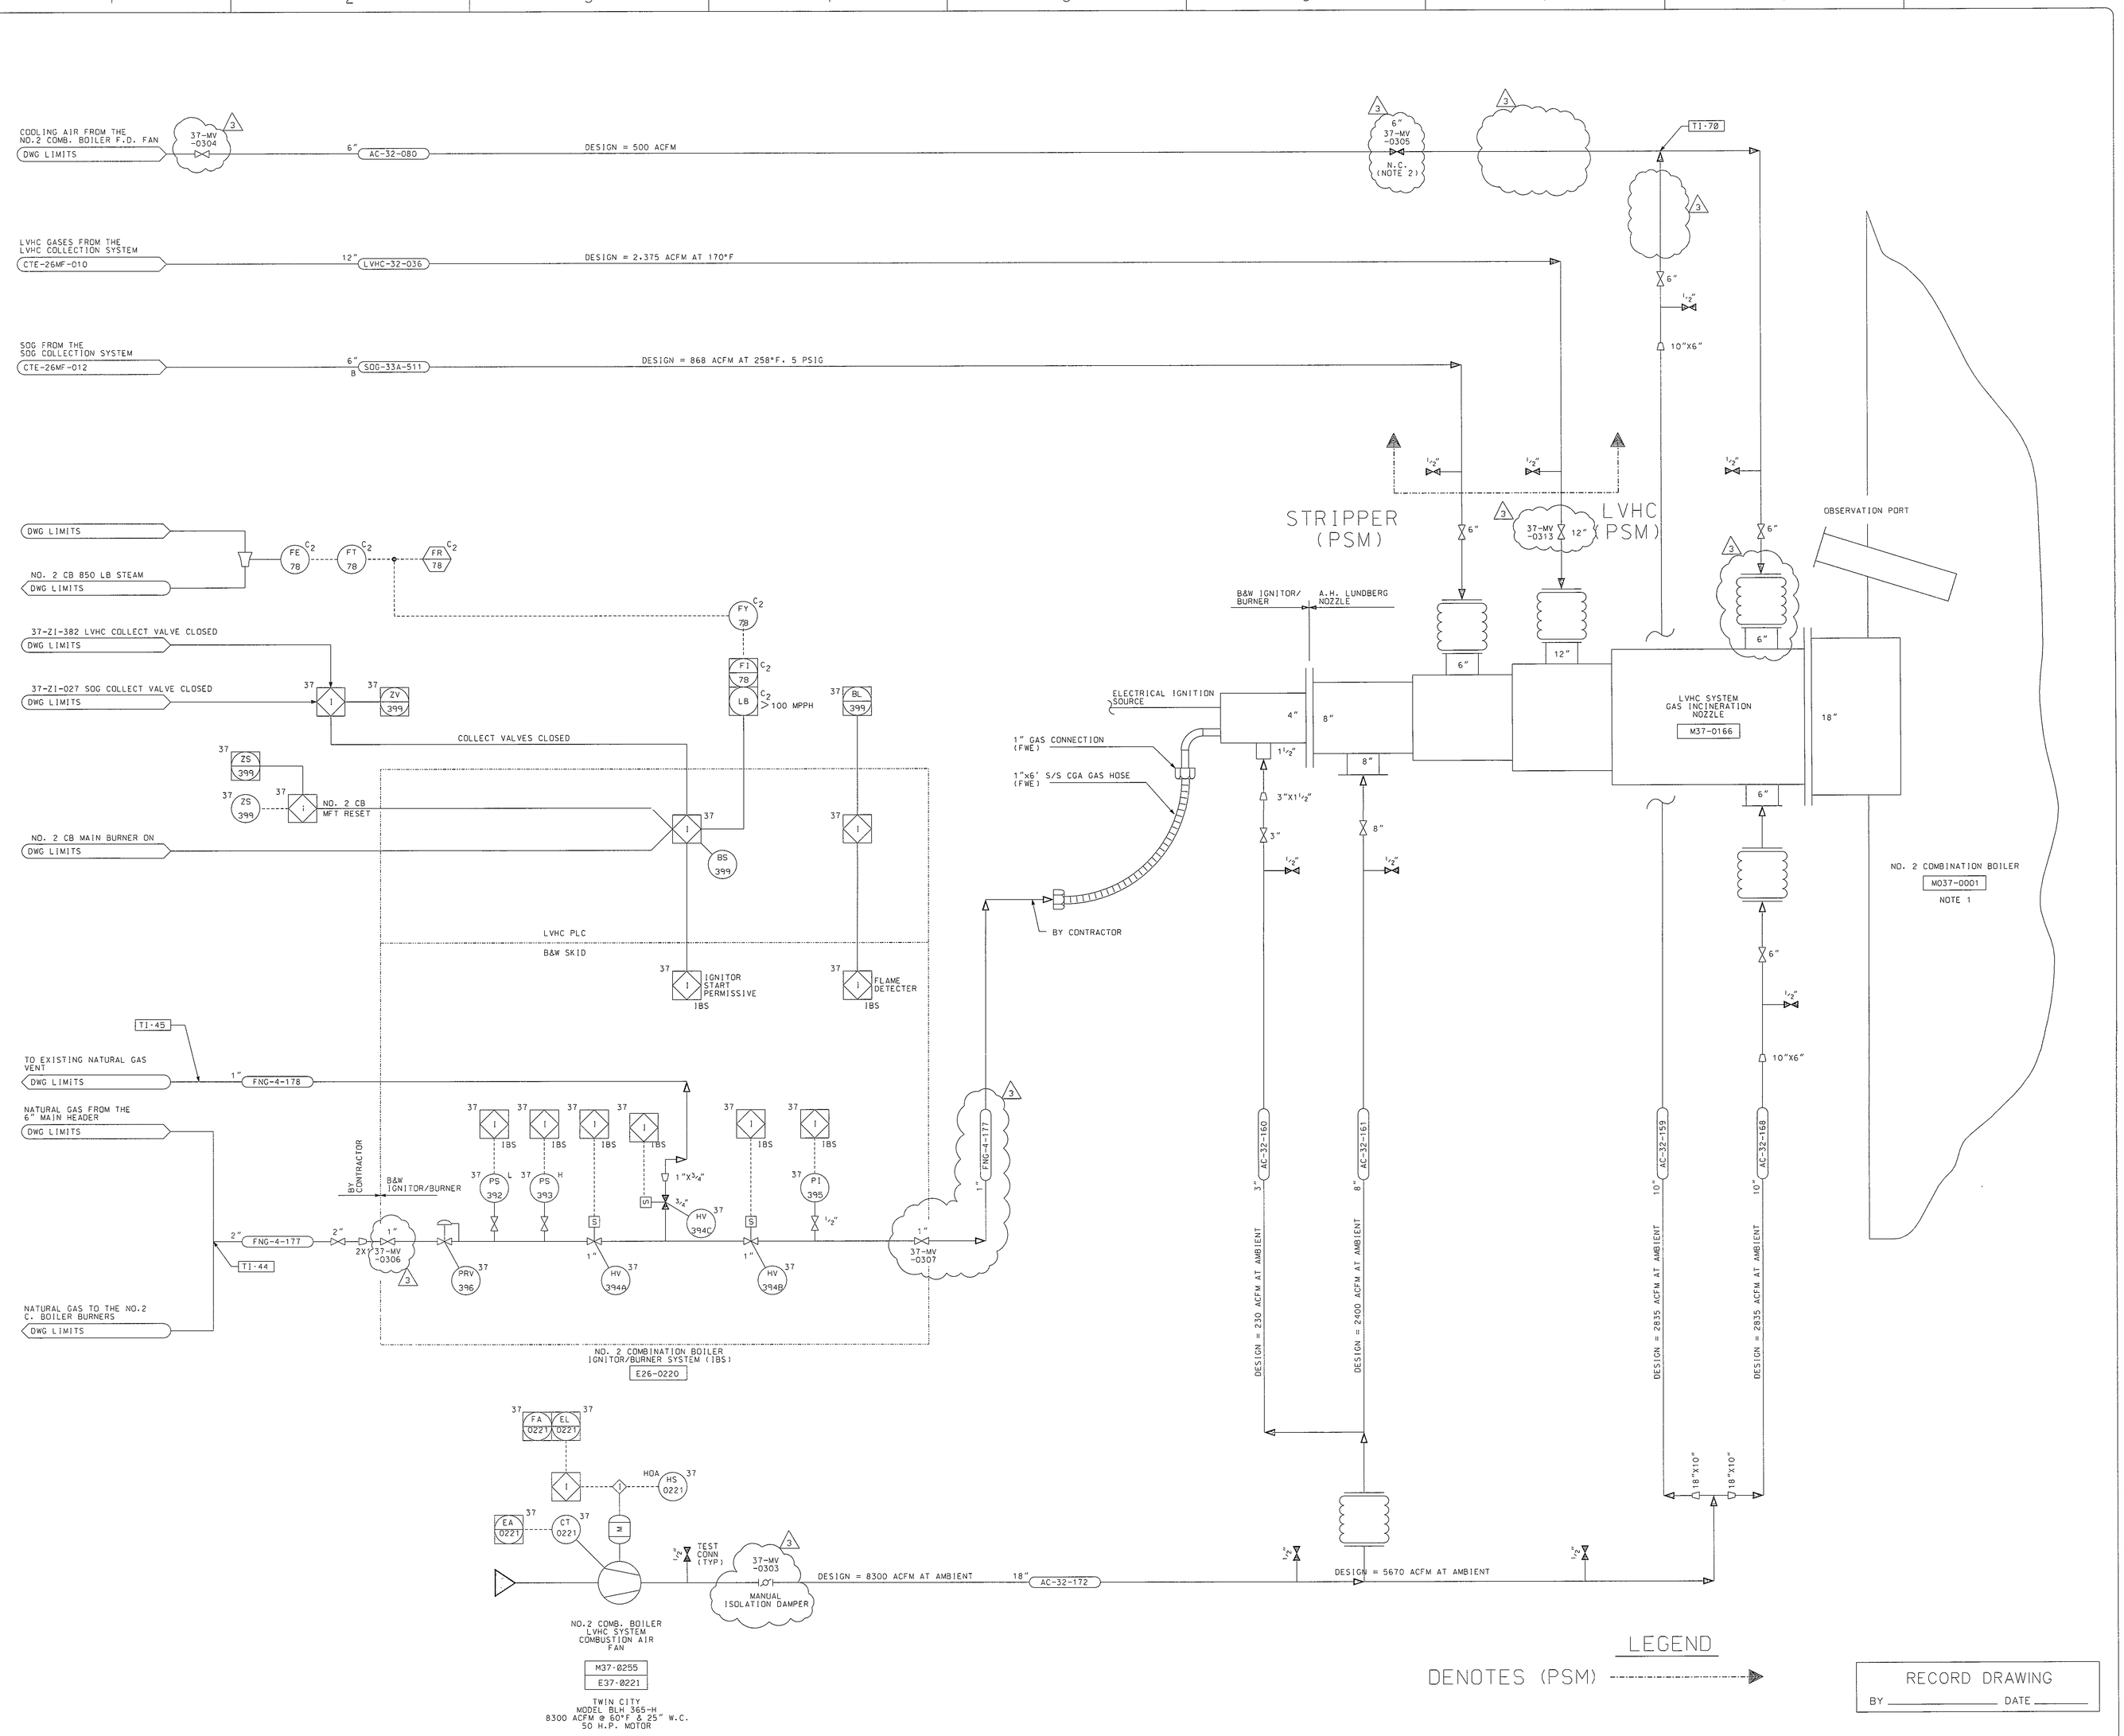

NOTES

1. THE NO. 2 COMBINATION BOILER MODIFICATIONS AND LVHC GAS INCINERATION NOZZLE INSTALLATION WILL BE BY OTHERS.
2. VALVE IS CLOSED WHEN GASES ARE BEING BURNED IN BOILER. VALVE IS OPEN WHEN GASES ARE NOT BEING BURNED IN BOILER.
3. SEE LOOP SHEETS FOR INTERLOCK NOTES 37-397 & 37-399

REV. NO.	CODE	CIRCLES	DATE	DESCRIPTION	CHECKED BY	APPROVED	APPROVED
4	RRB		09 25 02	ADDED (PSM) PER GAH			
3	G TTC	–	11 27 01	RELEASED FOR RECORD			
2	B TGT	15	01 26 01	ADDED ISOLATION DAMPER CLOSED TEST VALVES & REMOVED HOLD			
1	B SLC	11	01 04 01	CHANGED SO. DUCT TO ROUND PIPE; ADDED RED. AND TEST CONN.			
0	B SLC	–	12 20 00	RELEASED FOR DESIGN			
A	A TGT	–		RELEASED FOR APPROVAL	SC		

NOTE: CIRCLE ALL REVISIONS. IDENTIFY WITH DIAMOND, NUMBER AND ARROW. REMOVE ONLY CIRCLE AND ARROW BEFORE NEXT REVISION.

ISSUE CODE					
A	PRELIMINARY	C	MAT'L T.O.	F	CONST'N
B	DESIGN	D	MAT'L PURC.	G	RECORD
		E	BIDS		

SEAL

SIGNATURE

DATE

BE&K ENGINEERING OF NORTH CAROLINA, INC.
2000 PERIMETER PARK DRIVE, SUITE 100
MORRISVILLE, NORTH CAROLINA 27560

DR. T. STABLES	DATE 11/16/00
DSGN. T. TOMPKINS	FILE NUMBER
CK. S. CHANDRA	
DPE T. TOMPKINS	JOB NO. 99-2069
Codfile Name: **DGN**	

BOWATER
COATED PAPER & PULP DIV.
P.O. Box 7, Catawba, South Carolina 29704

DRAWING TITLE
CLUSTER RULE PROJECT
LVHC COLLECTION SYS.
NO. 2 COMB. BOILER
P & I DIAGRAM

BE&K DRAWING NUMBER
N/A

CLIENT DRAWING NUMBER
CTE-37MF-007

RECORD DRAWING
BY _____ DATE _____