CAD FILE No. 047P0002.DGN

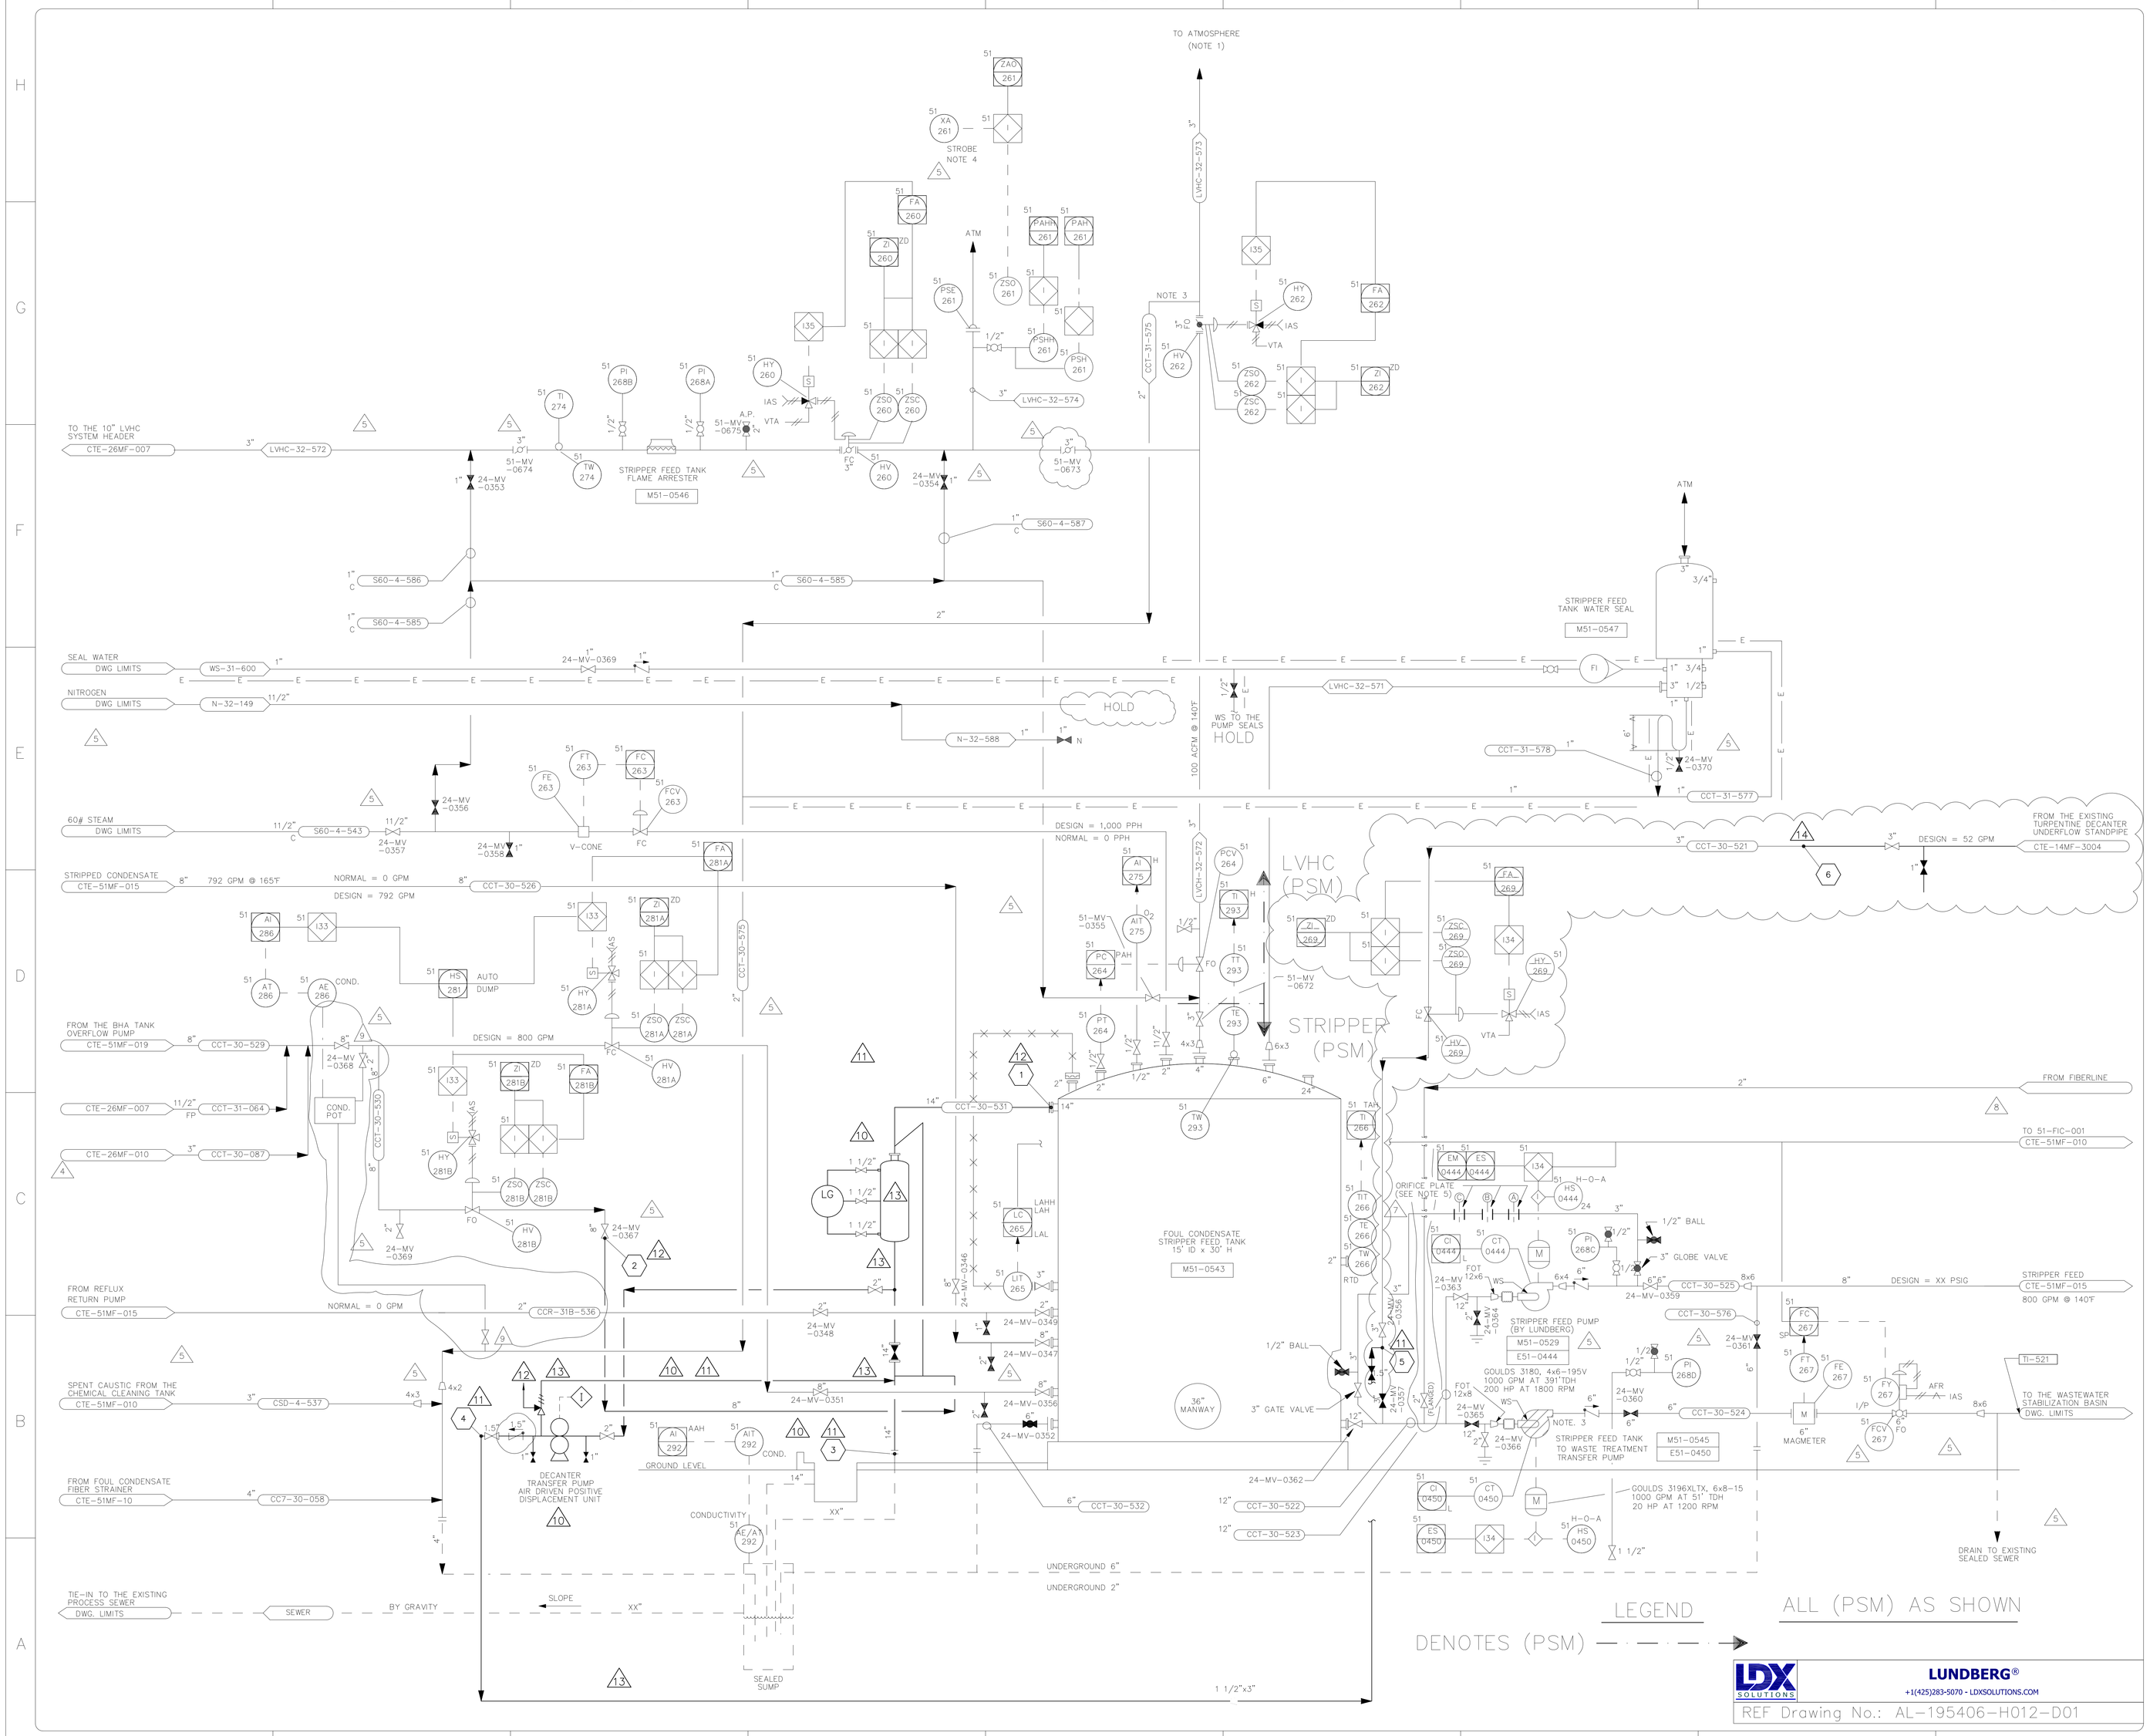

NOTES

1. THE PIPING DRAWINGS WILL SHOW THE LOCATION OF THIS VENT.
2. THIS PUMP WAS THE HARD PIPE FOUL CONDENSATE DELIVERY PUMP NO. 1 – SOUTH
   EQ. NUMBER M24-0093
   MOTOR NUMBER E24-0040
   GOULDS 3196XLTX
   SIZE = 6x8 – 15
   ORIGINAL MOTOR = 75HP AT 1800 RPM
   * A NEW 25 HP/1200 RPM MOTOR MUST BE INSTALLED ON THE EXISTING PUMP BASE.
3. THIS VENT WILL BE DRAINED INTO THE SEALED SUMP.
4. ACTIVATES RUPTURE DISC STROBE LIGHT 26-EA-261, LOCATED IN STRIPPER ISLAND, NEAR BRIDGE CQL AT M51-0538.
5. ORIFICE PLATE BORES:
   A = 1.0066"
   B = 1.1798"
   C = 1.3750"

I34 — IF CONDENSATE PUMP IS OFF, CLOSE DECANTER VALVE AND SHUT DOWN DECANTER PUMP. IF DECANTER PUMP IS OFF, CLOSE DECANTER VALVE.

AP = AIR PURGE

REV. NO.	CODE CIRCLES	REV. BY	DATE	DESCRIPTION	CHECKED BY	APPROVED	APPROVED
13	–	09		REMOVED LT			
		16		REMOVED & ADDED VALVES			
	AAM	19		ADDED LINE			
12	–	09		MODIFIED TIE-IN LOCATION,			
		16		ADDED PRV AT DECANTER			
	KMC	19		TRANSFER PUMP			
11	–	08		ADDED OVERFLOW PIPE AND			
		27		DECANTER, ADDED PIPING			
	KMC	19					
10	–	08		ADDED 36" STANDPIPE AND			
		15		DECANTER TRANSFER			
	RJB	19					
9	–	02		ADDED COND. POT			
		06					
	LSJ	06					
8	1	3		ADDED 2" LINE FROM			
		20		FIBERLINE			
	KHM	03					
7		10		ADDED 3" RECIRCULATION LINE			
	KHM	08		WITH MINIMUM FLOW ORIFICE			
		02		PLATES			
6		9		ADDED (PSM)			
		25		PER GAH			
	RRB	02					
5	G –	11		RELEASED FOR RECORD			
		27					
	TTC	01					
4	B 16	01		ADDED NITROGEN, WATER			
		17		AND STEAM LINES			
	TGT	01					
3	B 10	10		RELEASED FOR			
		20		DESIGN WITH			
	TGT	00		PIPING DWGS.			
2	B 19	09		INCORPORATED VALVE			
		18		NUMBERS			
	TGT	00					
1	B 14	07		INCORPORATED HAZOP			
		28		COMMENTS & RELEASED FOR			
	TGT	00		DESIGN			
0	B –	07		RELEASED FOR DESIGN			
		07		AND HAZOP REVIEW			
	EEH	00					
14	A –	08		RESTORED DECANTER UNDER-			
		12		FLOW INCL L51-269L			
	AFW	21		GEN REV FOR AS-BUILT			

NOTE: CIRCLE ALL REVISIONS, IDENTIFY WITH DIAMOND, NUMBER AND ARROW. REMOVE ONLY CIRCLE AND ARROW BEFORE NEXT REVISION.

ISSUE CODE			
A	PRELIMINARY	C	MAT'L T.O.
B	DESIGN	D	MAT'L PURC.
		E	BIDS
		F	CONST'N
		G	RECORD

SEAL

SIGNATURE

DATE

DR. C. WARE	DATE 06/08/99
DSGN. T. TOMPKINS	FILE NUMBER
CK. D. BROWN	
DPE T. TOMPKINS	JOB NO. 99-2047
Cadfile Name: CTE-51MF-014 R14.DWG	

NEW INDY CONTAINERBOARD

DRAWING TITLE
CLUSTER RULE PROJECT
COND. STRIPPER SYS.
STRIPPER FEED TANK
P & I DIAGRAM

BE&K DRAWING NUMBER

CLIENT DRAWING NUMBER
CTE-51MF-014

SYTIME