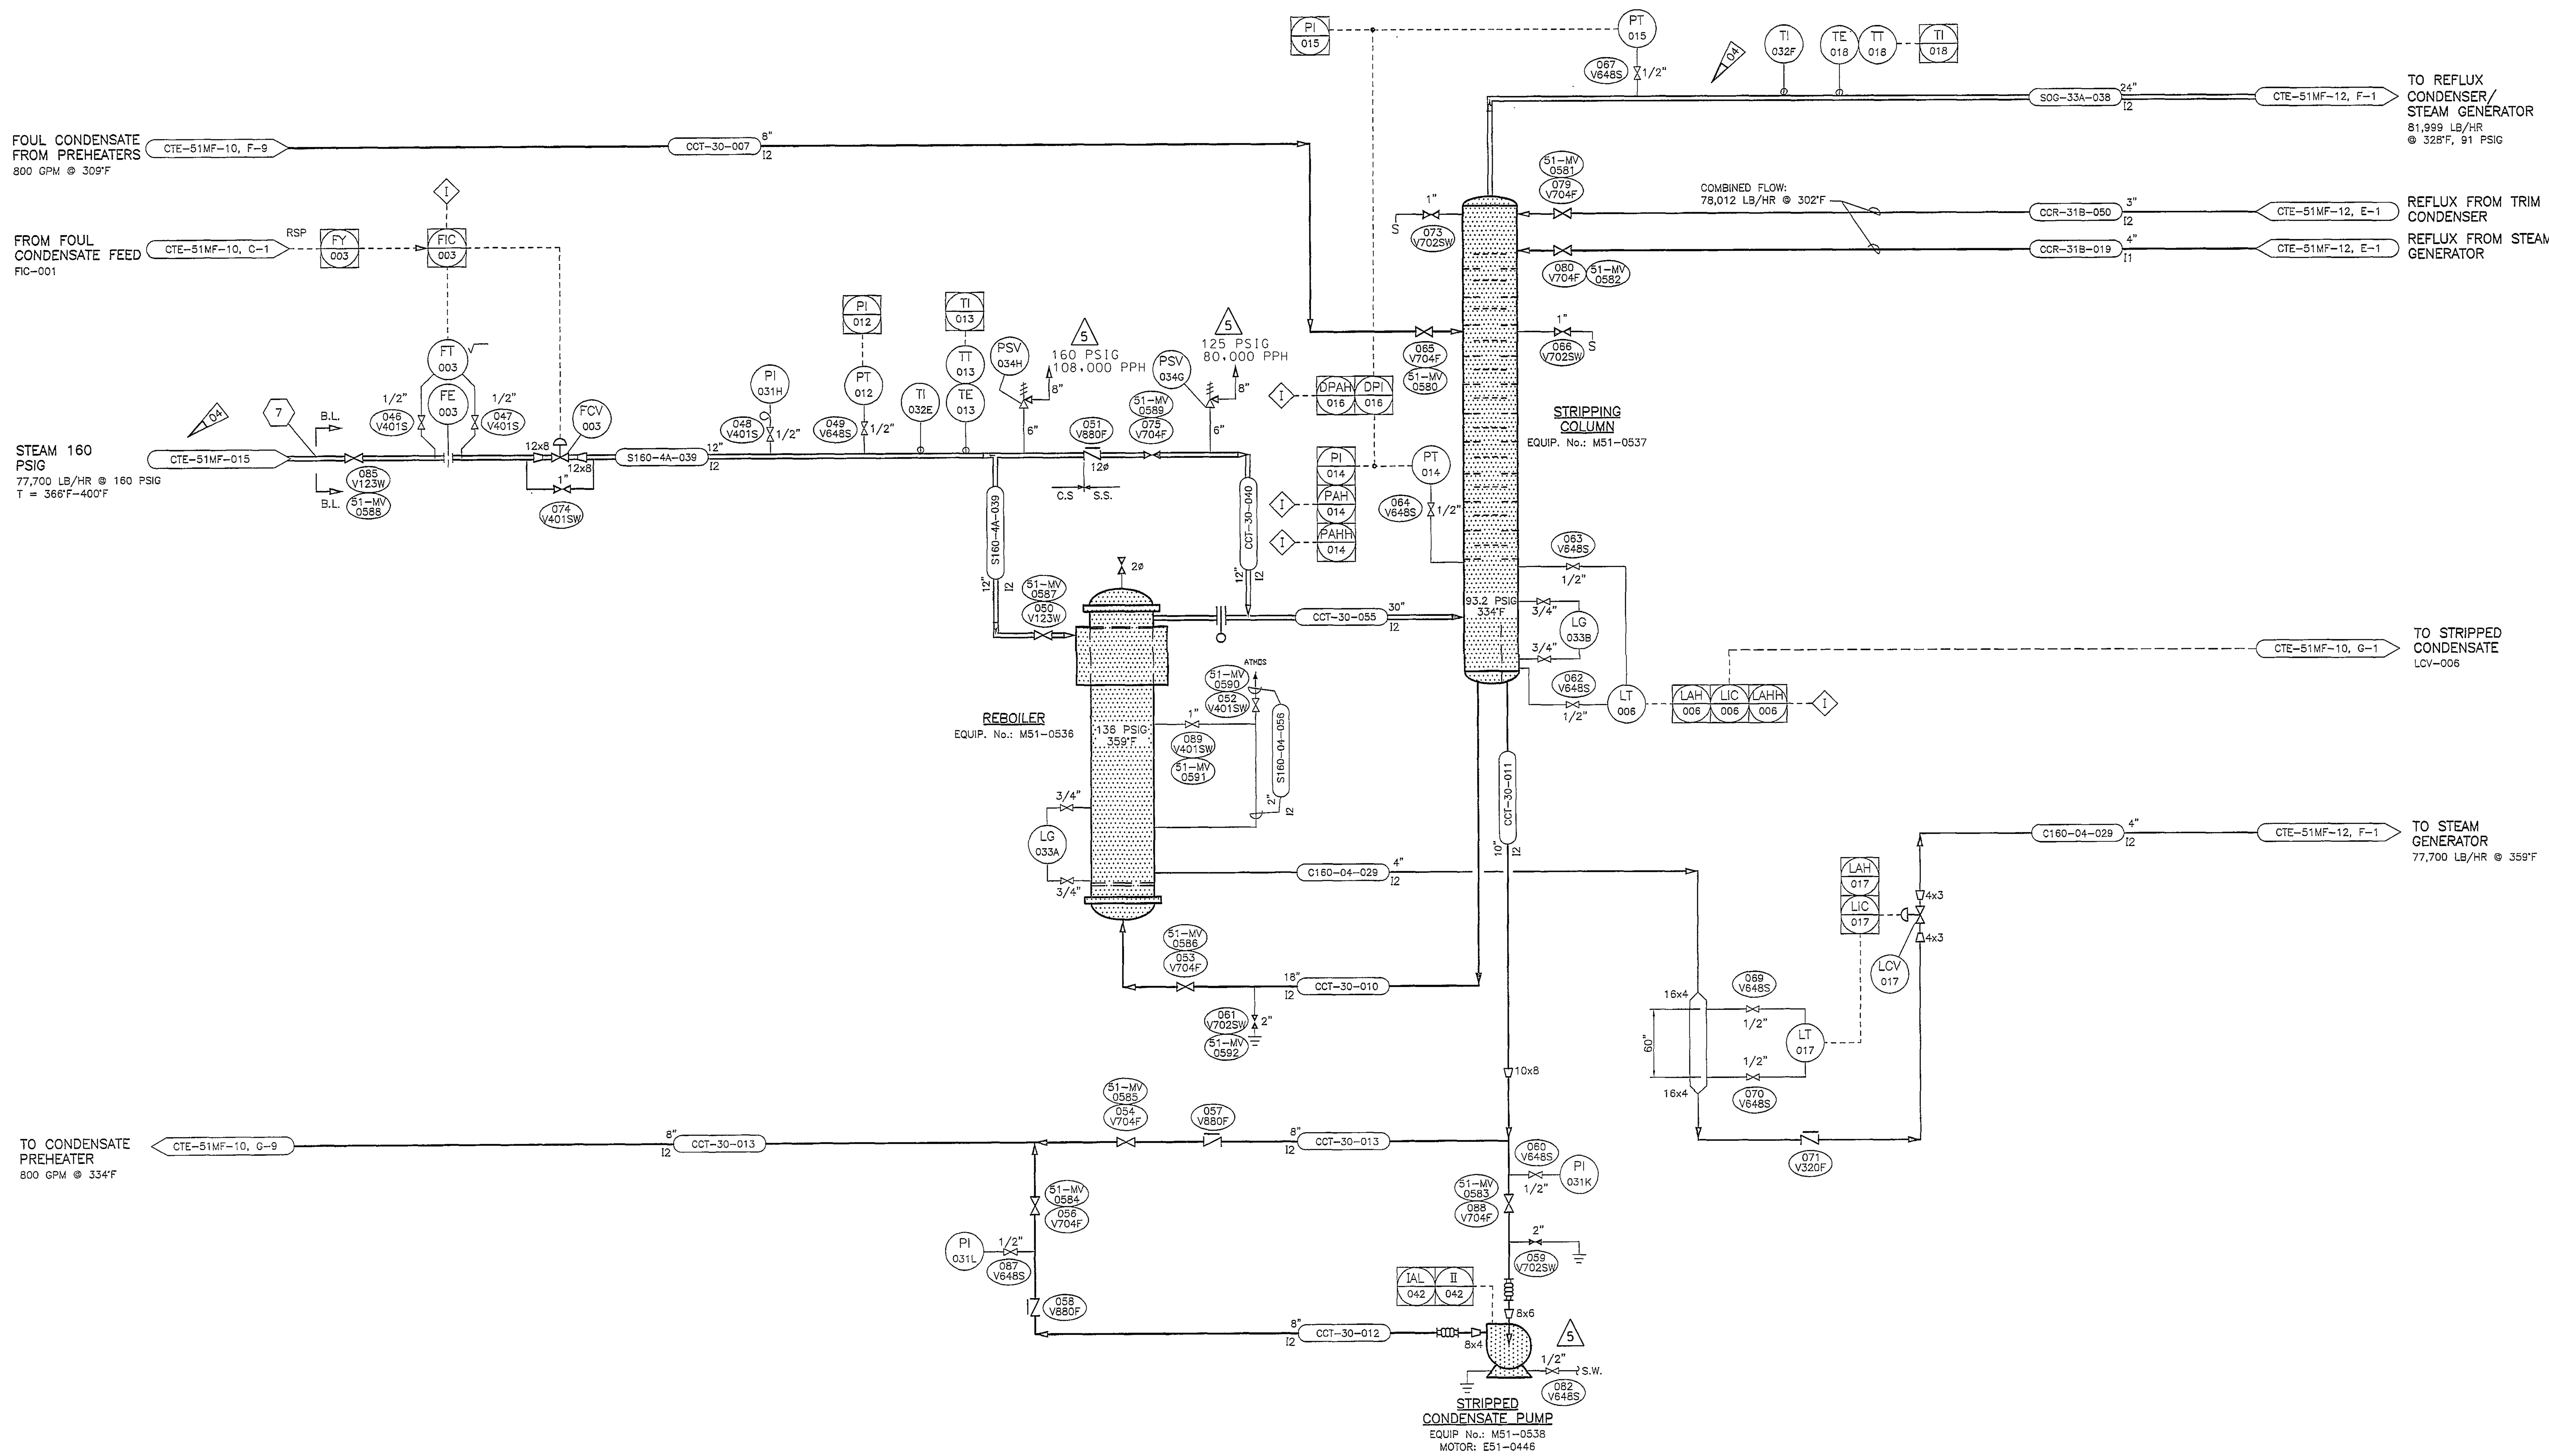

RECEIVED
MAR 2 3 2006
BOWATER CAROLINA ENGINEERING

CADFILE: 51MF-11.DGN
51MF-11.CIT

THIS DRAWING IS THE PROPERTY OF A.H. LUNDBERG ASSOCIATES AND IS TO BE RETURNED UPON REQUEST. IT IS LOANED UPON CONDITION THAT IT WILL NOT BE REPRODUCED IN WHOLE OR IN PART, OR USED TO FURNISH INFORMATION TO OTHERS, OR FOR ANY PURPOSE OTHER THAN WORK AUTHORIZED BY A.H. LUNDBERG ASSOCIATES.

NOTES

GENERAL REVISIONS

REV. NO.	REV. BY	DATE	DESCRIPTION	CHECKED BY	DATE
5	LSJ			KHM	
04	DJ	12/3/01	REVISED AS BUILT		
03	EH	8/7/00	ADDED DUAL VALVE No.s', PSV-034H & I I-042. REVISED STEAM PSIG.	JLS	8/10/00
02	AAM	5/24/00	REVISED LINE & VALVE NUMBERS TO MEET CUSTOMER REQUIREMENTS. ADDED BOWATER DWG. NO.	JLS	5/24/00
01	AT	4/07/00	ADDED EQUIP. NO'S. REVISED INSTR. NO'S & LINE NO'S. ADDED VALVE NO'S	JLS	4/25/00

NOTE: CIRCLE ALL REVISIONS, IDENTIFY WITH DIAMOND, NUMBER AND ARROW. REMOVE ONLY CIRCLE AND ARROW BEFORE NEXT REVISION.

ISSUE CODE		
A PRELIMINARY	C MAT'L T.O.	F CONST'N
B DESIGN	D MAT'L PURC.	G
	E BIDS	

SEAL

SIGNATURE

DATE

A.H. LUNDBERG ASSOCIATES,INC.
P.O. Box 597 Bellevue, Washington 98009

SPEC. NO.	PURCHASE ORDER NO.	DRAWING NO.	SHT.	REV.
ODOR 0.04	SV-155414-JP	RL-995228-01	2/3	03

		SCALE:
DWN. BY/DATE:	AAM 2/28/00	NONE
CHK. BY/DATE:	BWB 3/01/00	
APP. BY/DATE:	JLS 3/02/00	

BOWATER
COATED PAPER & PULP DIV.
P.O. Box 7, Catawba, South Carolina 29704

DRAWING TITLE
FOUL CONDENSATE STRIPPING SYSTEM P&ID

DRAWING NUMBER
CTE-51MF-11