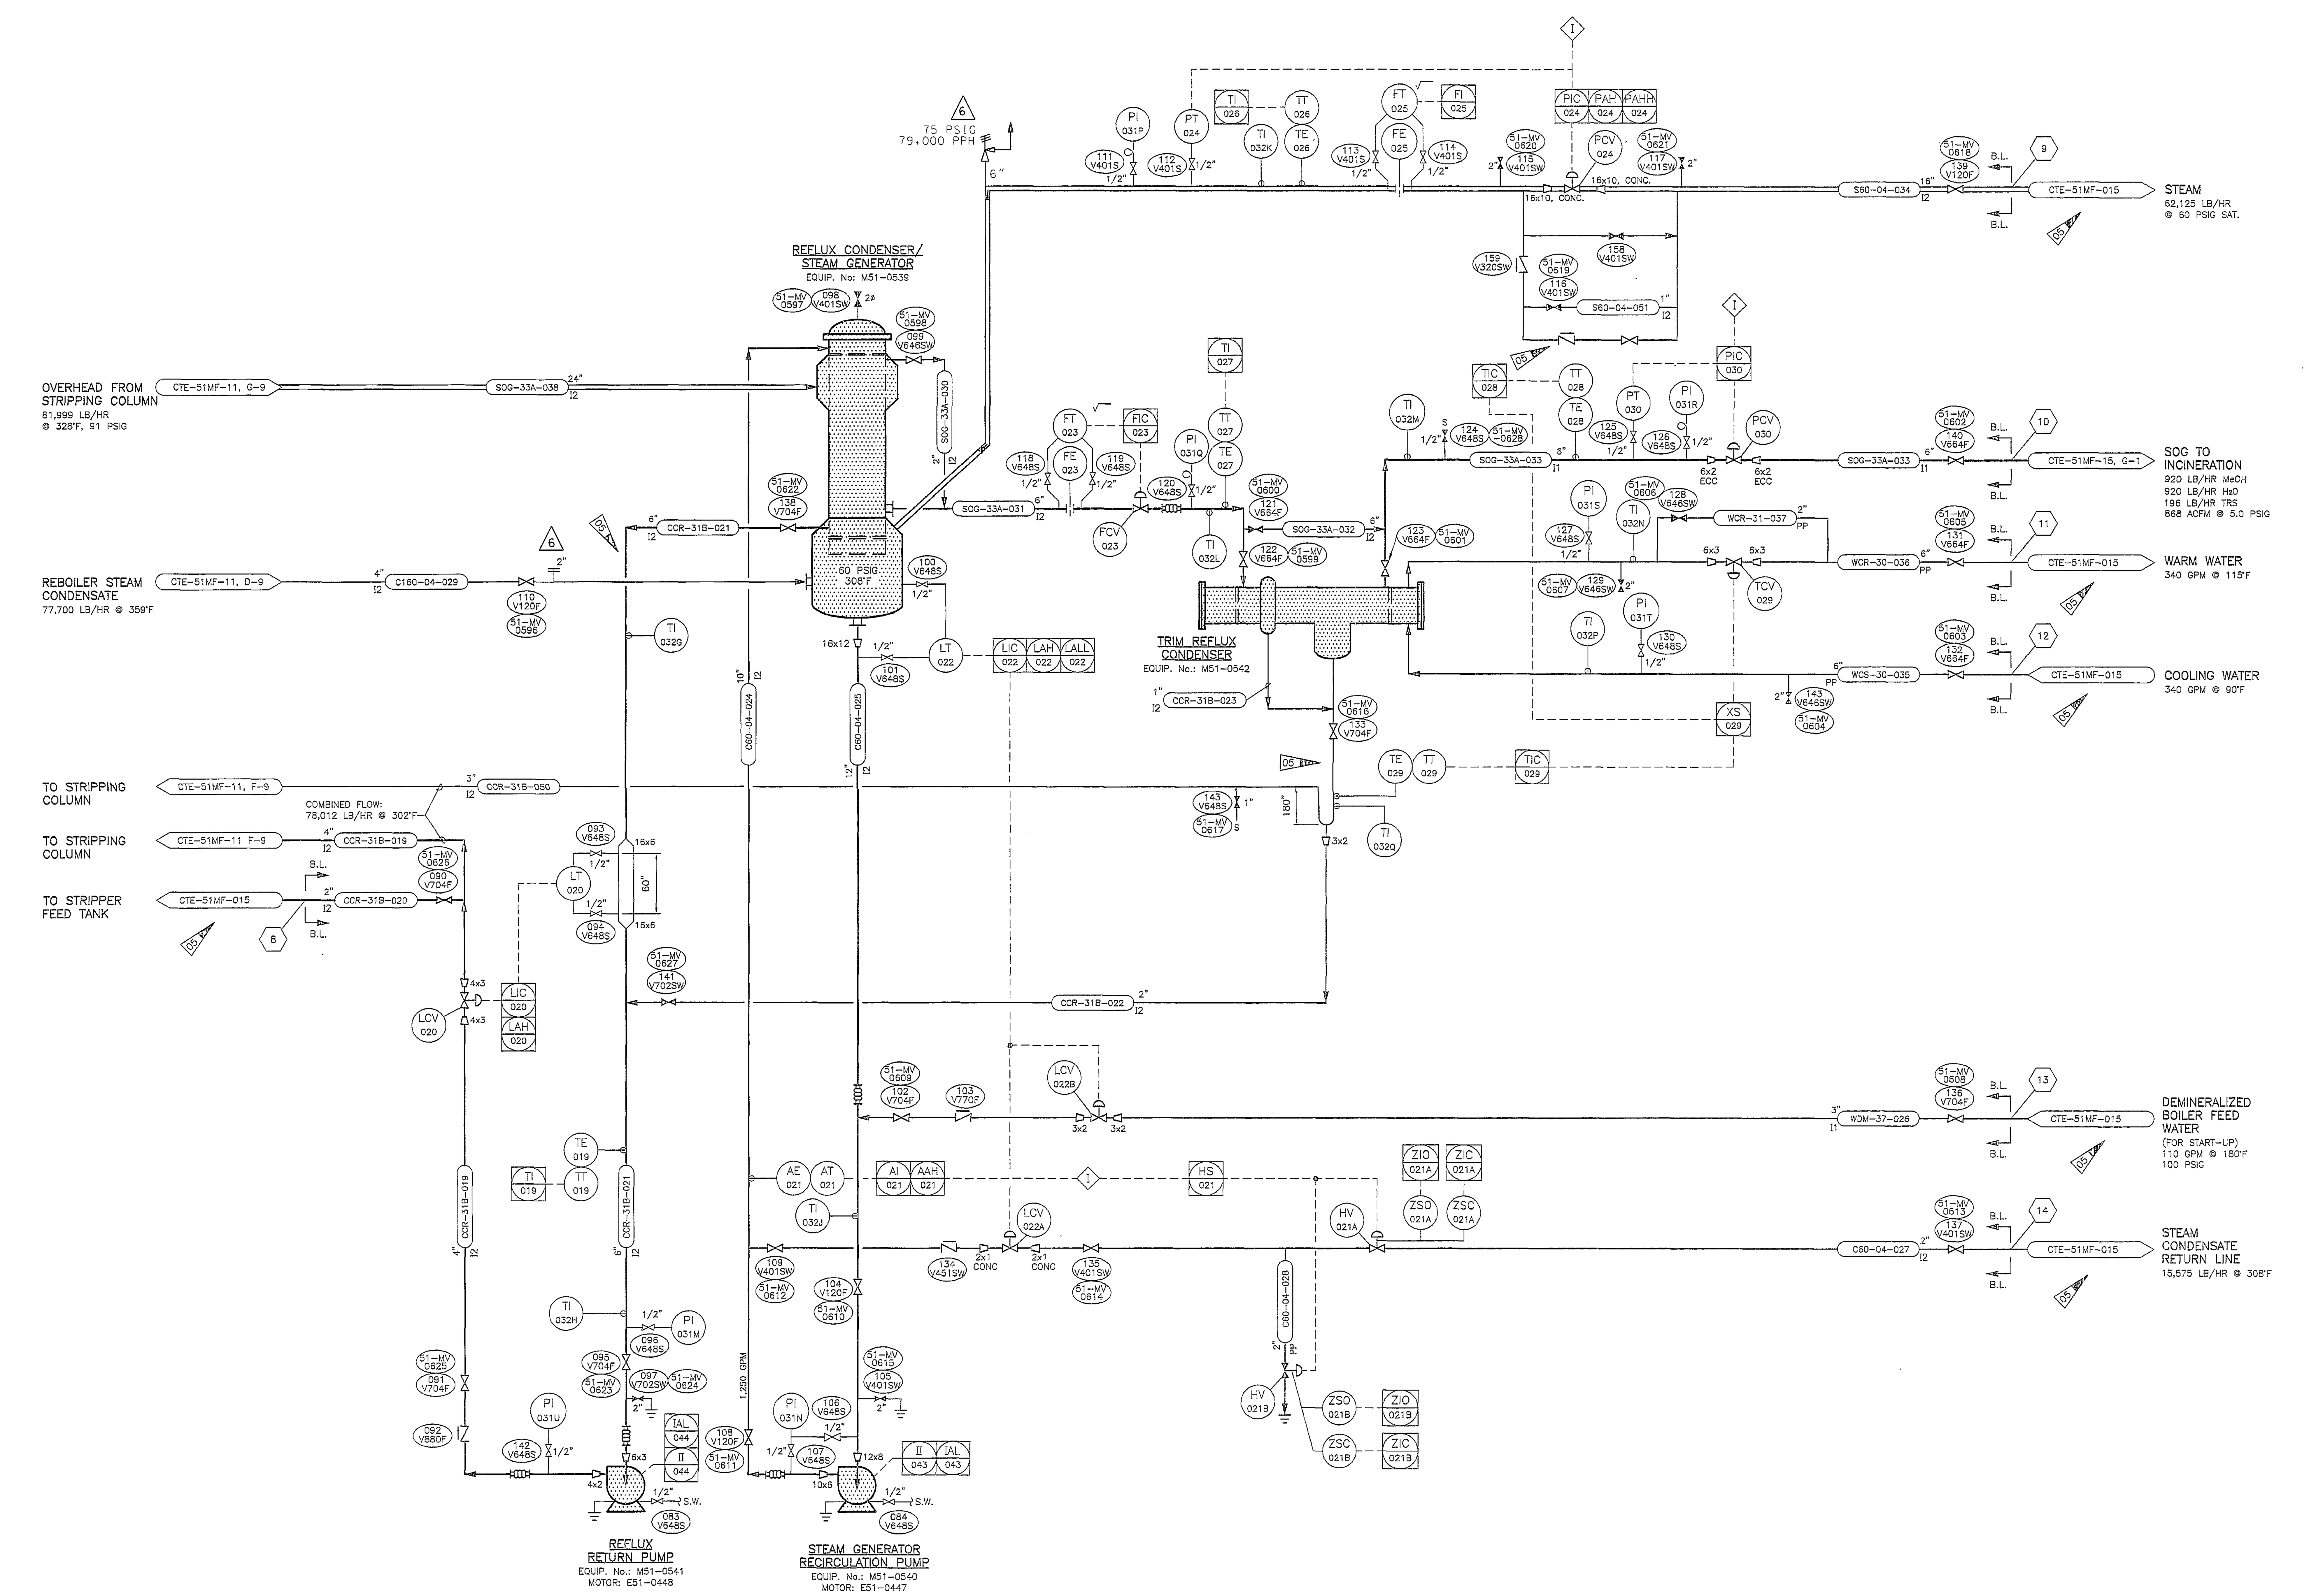

NOTES

REV. NO.	REV. BY	CIRCLES	DATE	DESCRIPTION	CHECKED BY	DATE
01	AT		4/07/00	ADDED VALVE NO'S. INSTR. NO'S & LINE NO'S. ADDED EQUIP. NO'S. REVISED	JLS	4/25/00
02	AAM		5/24/00	ADDED BOWATER DWG. NO. TO MEET CUSTOMER REQUIREMENTS. REVISED LINE & VALVE NUMBERS	JLS	5/24/00
03	EH		8/7/00	& 044. RELOCATED EX. JT. PSV-034J, EX. JT. & II-043 ADDED DUAL VALVE No.s',	JLS	8/10/00
04	GS		10/18/00	INTERLOCKS. PSV034J WAS 4"; REMOVE (2) REV LINE DIA AROUND CV's;	JLS	10/20/00
05	DJ		12/3/01	REVISED AS BUILT		
6	LSJ		3/21/06	GENERAL REVISIONS	KHM	

NOTE: CIRCLE ALL REVISIONS, IDENTIFY WITH DIAMOND, NUMBER AND ARROW. REMOVE ONLY CIRCLE AND ARROW BEFORE NEXT REVISION.

ISSUE CODE		
A PRELIMINARY	D MAT'L PURC.	G
B DESIGN	E BIDS	
C MAT'L T.O.	F CONST'N	

SEAL

SIGNATURE

DATE

A.H. LUNDBERG ASSOCIATES, INC.
P.O. Box 597 Bellevue, Washington 98009

SPEC. NO.	PURCHASE ORDER NO.	DRAWING NO.	SHT.	REV.
ODOR 0.04	SV-155414-JP	RL-995228-01	3/3	05

DWN. BY/DATE: AAM 2/28/00
CHK. BY/DATE: BWB 3/01/00
APP. BY/DATE: JLS 3/02/00
SCALE: NONE

BOWATER
COATED PAPER & PULP DIV.
P.O. Box 7, Catawba, South Carolina 29704

DRAWING TITLE
FOUL CONDENSATE STRIPPING SYSTEM P&ID

DRAWING NUMBER
CTE-51MF-12

RECEIVED
MAR 2 3 2006
BOWATER CAROLINA
ENGINEERING

CADFILE: 51MF-12.DGN
51MF-12.CIT

THIS DRAWING IS THE PROPERTY OF A.H. LUNDBERG ASSOCIATES AND IS TO BE RETURNED UPON REQUEST. IT IS LOANED UPON CONDITION THAT IT WILL NOT BE REPRODUCED IN WHOLE OR IN PART, OR USED TO FURNISH INFORMATION TO OTHERS, OR FOR ANY PURPOSE OTHER THAN WORK AUTHORIZED BY A.H. LUNDBERG ASSOCIATES.