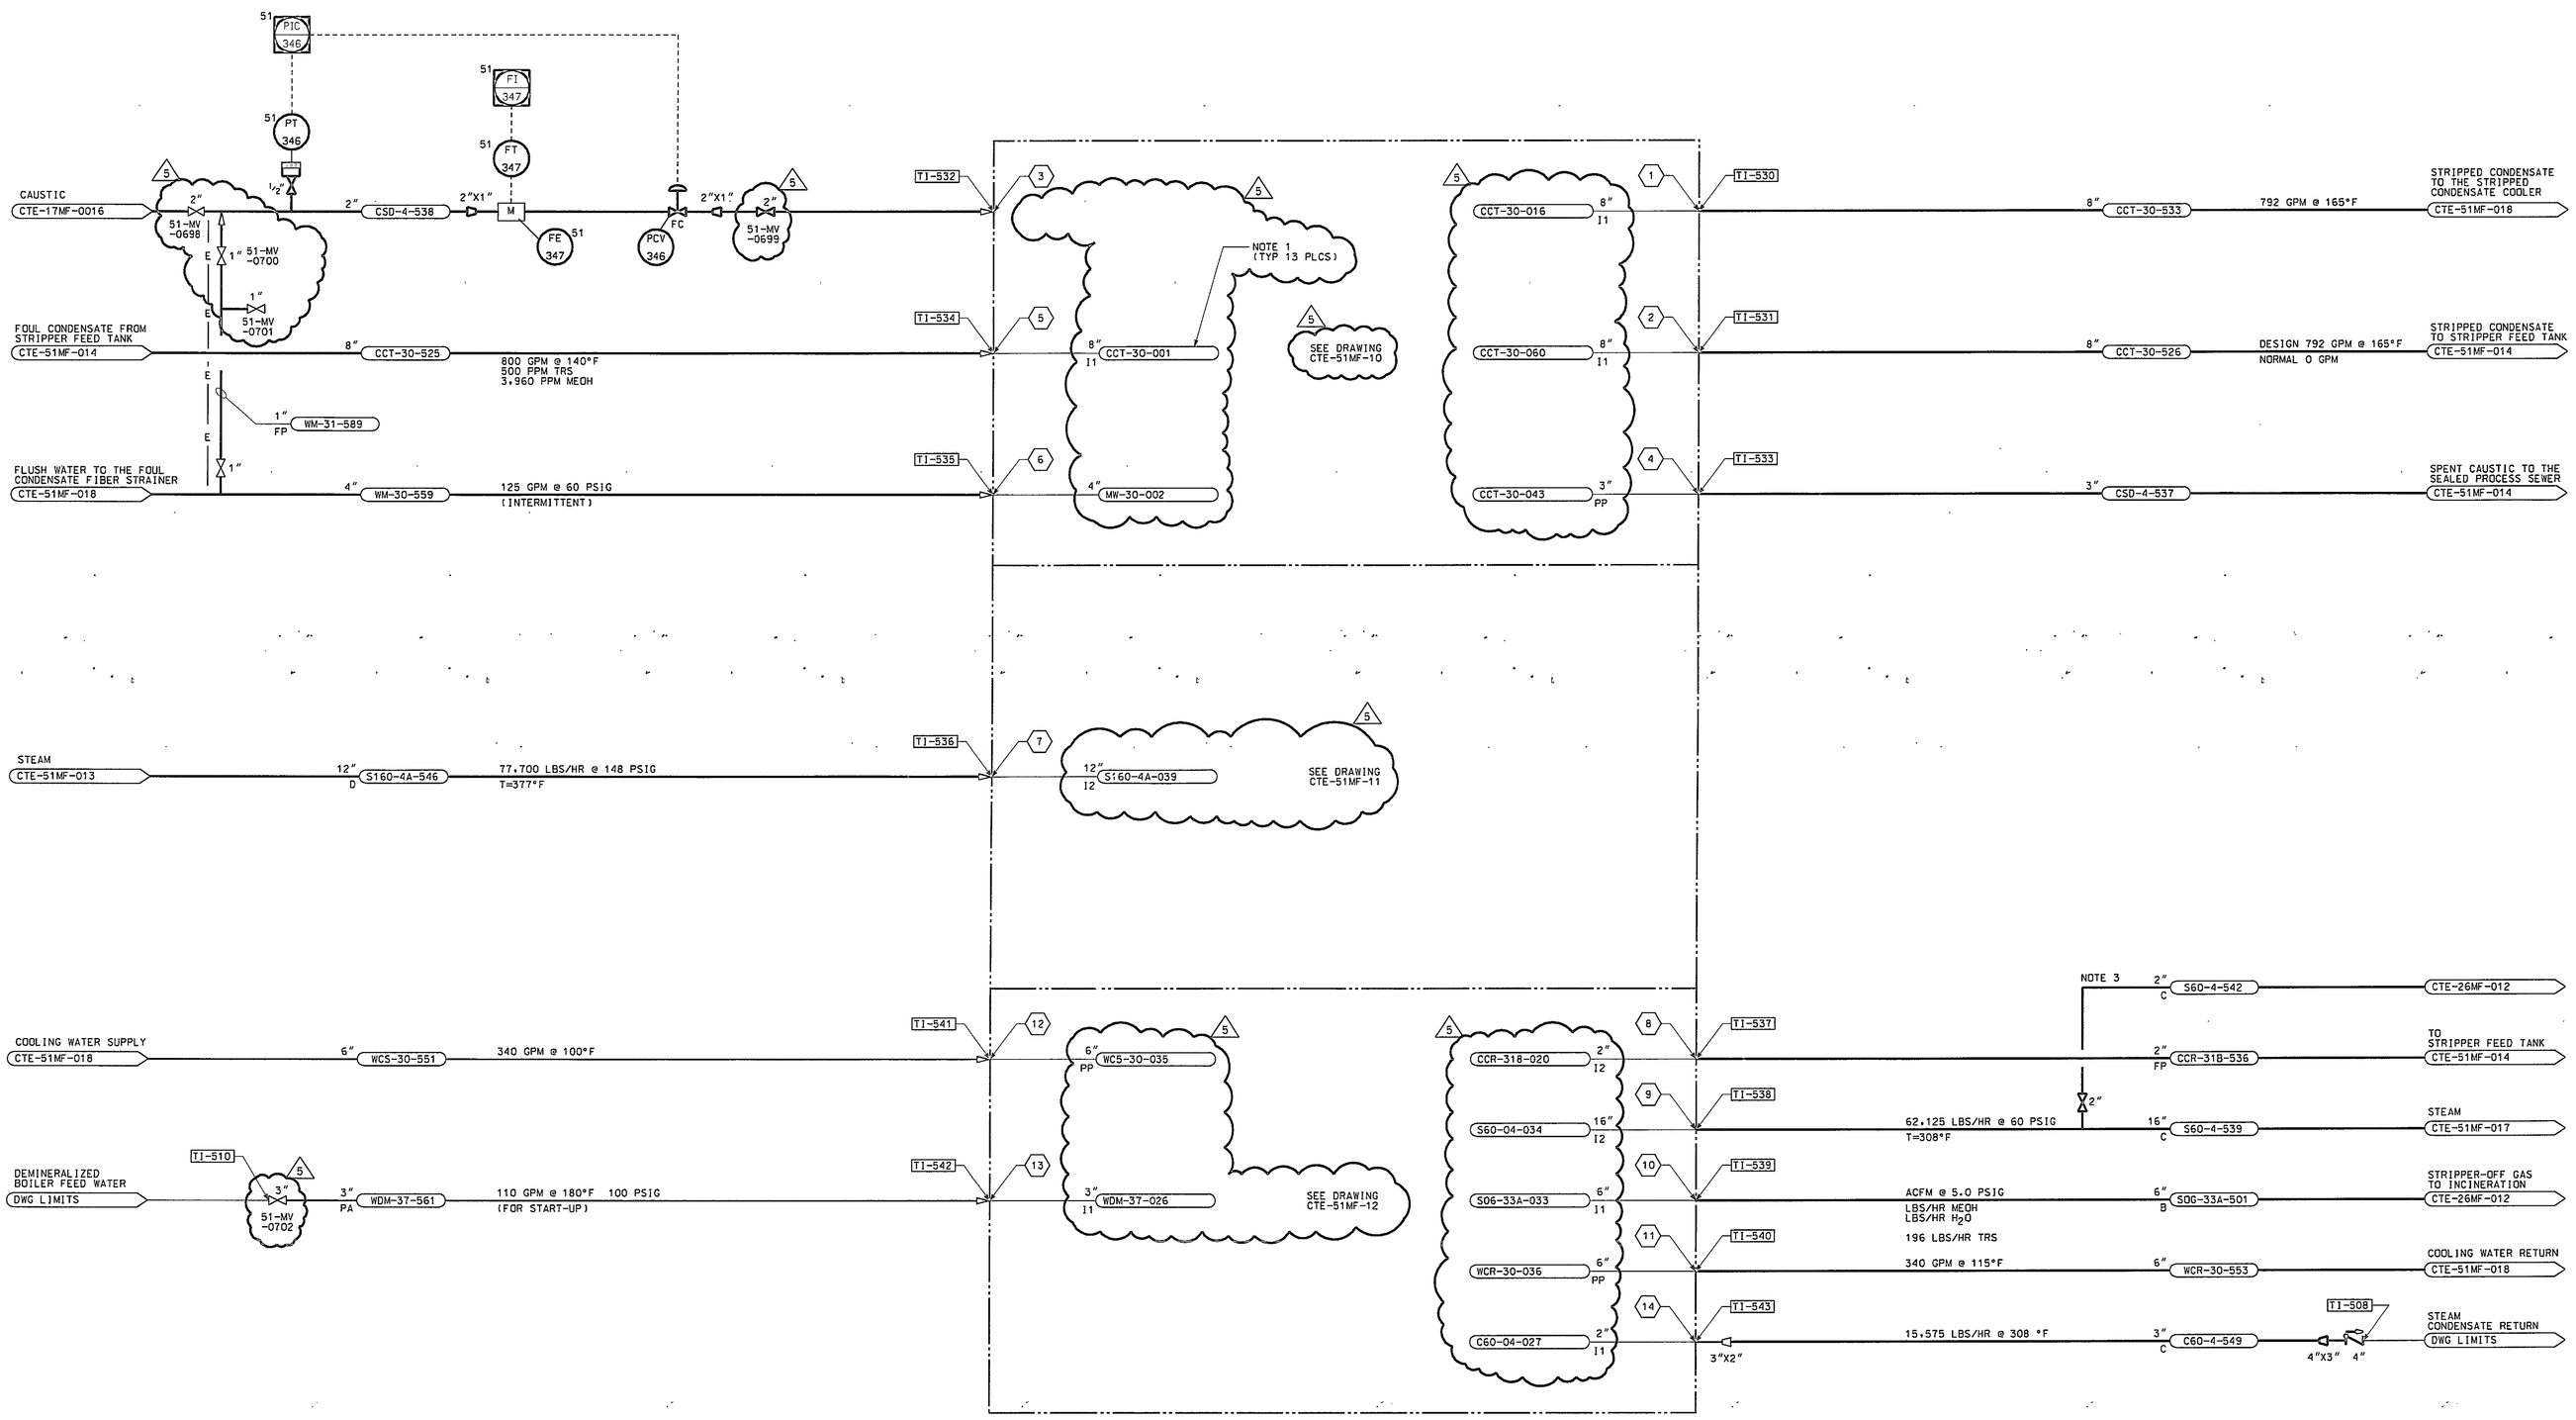

THIS ORIGINAL DRAWING RELEASED TO Donna ON 12/13/01 FOR USE ONLY FOR WORK SHOWN. BE&K DOES NOT REPRESENT OR WARRANT CHANGES MADE AFTER THE ABOVE DATE OR THAT ALL CHANGES MADE DURING CONSTRUCTION ARE SHOWN.

RECORD DRAWING
BY [signature] DATE 12/13/01

NOTES

1. A. H. LUNDBERG LINE NUMBERS SHOWN INSIDE BATTERY LIMITS.
2. THIS LINE DESIGNATES BOTH DRAWING AND BATTERY LIMITS.
3. THIS LINE MAY REQUIRE A TRAP. PIPING WILL MAKE THIS DETERMINATION.

REV. NO.	CODE	CIRCLES	DATE	DESCRIPTION	CHECKED BY	PROJECT APPROVED
5	G	–	11	RELEASED FOR RECORD		
	TTC		27			
			01			
4	B	3	01	ADDED 1"-WM-31-589,		
	TGT		26	PT. AND VALVES		
			01			
3	B	8	10	RELEASED FOR		
	TGT		20	DESIGN WITH		
			00	PIPING DWGS.		
2	B	12	09	ADDED LINE NUMBERS		
	TGT		18			
			00			
1	B	8	07	INCORPORATED HAZOP		
	TGT		28	COMMENTS & RELEASED FOR		
			00	DESIGN		
0	B	–	07	RELEASED FOR DESIGN		
	EEH		07	AND HAZOP REVIEW		
			00			
A	A	–	06	RELEASED FOR CLIENT	TGT	TGT
	JZC		12	APPROVAL		
			00			

NOTE: CIRCLE ALL REVISIONS. IDENTIFY WITH DIAMOND, NUMBER AND ARROW. REMOVE ONLY CIRCLE AND ARROW BEFORE NEXT REVISION.

ISSUE CODE					
A	PRELIMINARY	C	MAT'L T.O.	F	CONST'N
B	DESIGN	D	MAT'L PURC.	G	RECORD
		E	BIDS		

SEAL

SIGNATURE

DATE

BE&K ENGINEERING OF NORTH CAROLINA, INC.
2203 PERIMETER PARK DRIVE, SUITE 3C1
MORRISVILLE, NORTH CAROLINA 27560

DR. J. CARPENTER	DATE 06/06/00
DSGN. T. TOMPKINS	FILE
CK. D. BROWN	NUMBER
DPE T. TOMPKINS	JOB NO. 99-2047
Cadfile Name: G:\992047\51mf015.dgn	

BOWATER
COATED PAPER & PULP DIV.
P.O. Box 7, Catawba, South Carolina 29704

DRAWING TITLE
CLUSTER RULE PROJECT
COND. STRIPPER SYS.
STRIPPER SERVICES
P & I DIAGRAM

BE&K DRAWING NUMBER
047-PO-003

CLIENT DRAWING NUMBER
CTE-51MF-015

Wed Nov 21 15:59:22 2001