CAD FILE No. 047P0004.DGN

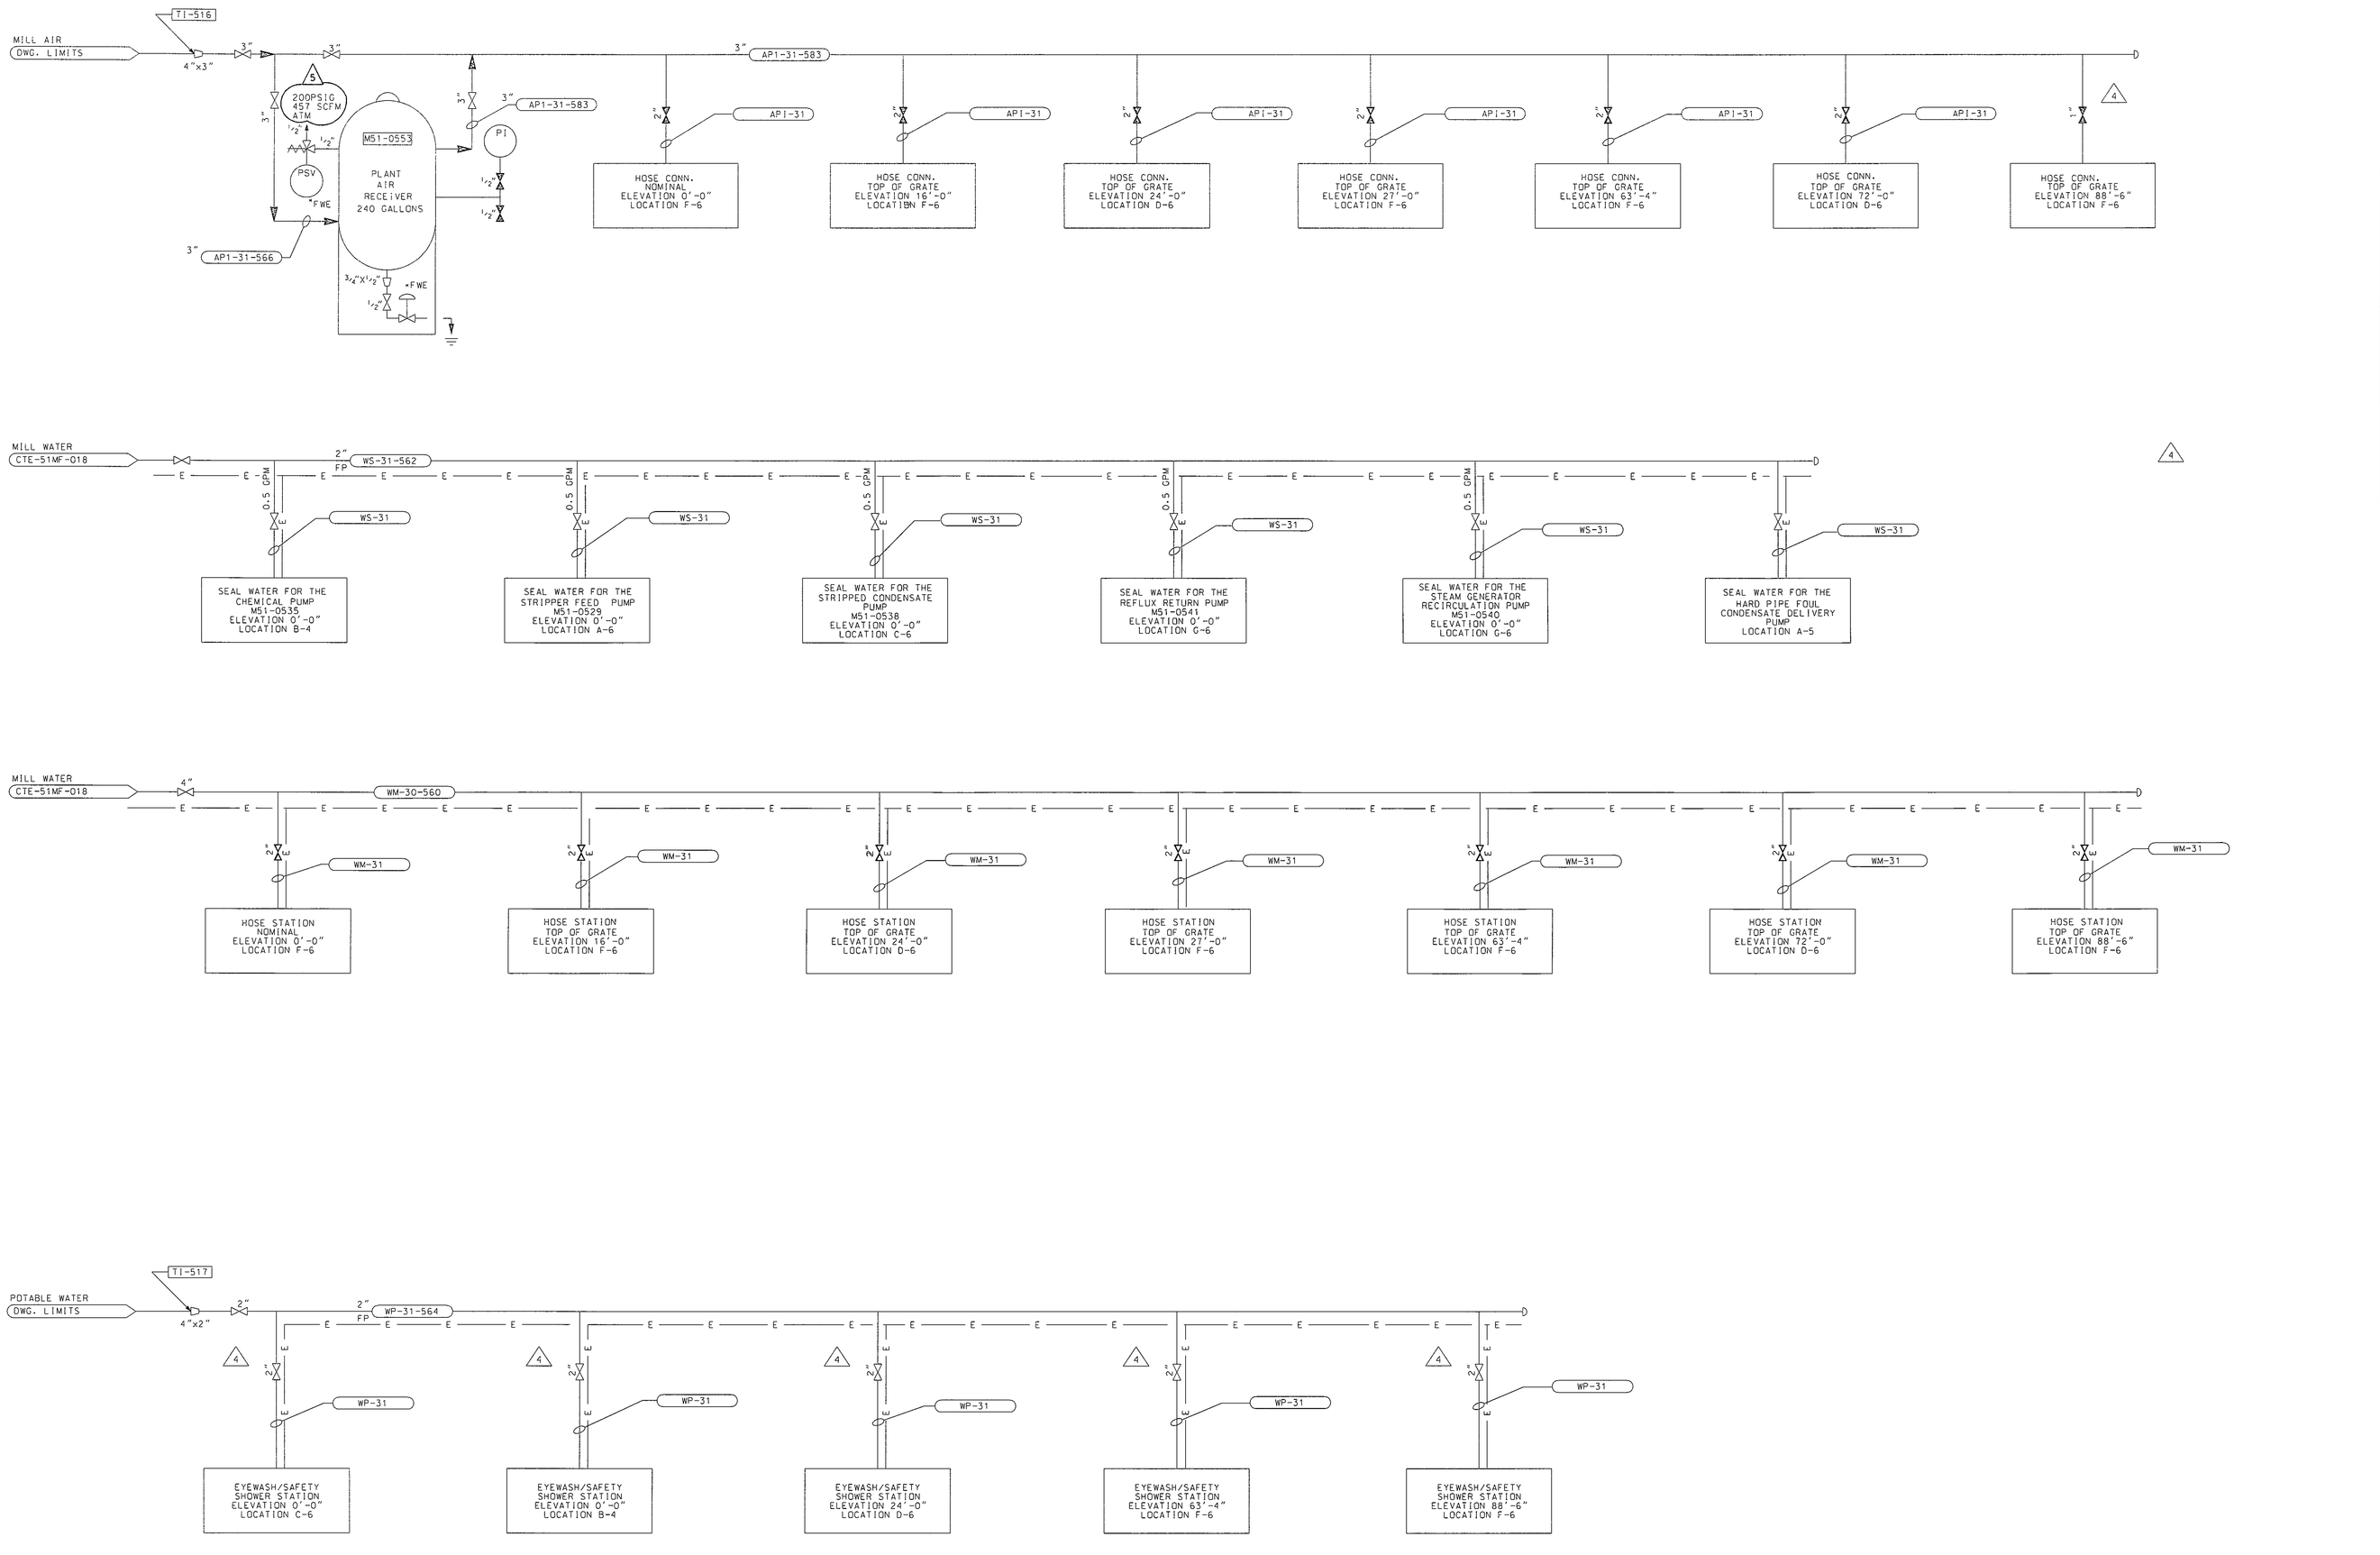

NOTES

1. FOR ALL GRID (LETTER - NUMBER) LOCATIONS SEE A.H. LUNDBERG DRAWING NUMBER RL-995228-03.
2. ELEVATIONS ASSUME THAT GRADE IS AT 0'-0".

REV. NO.	CODE / REV. BY	CIRCLES	DATE	DESCRIPTION	CHECKED BY	APPROVED	APPROVED
5	LSJ		02 06 06	ADDED NOTE PRESS. RELIEF VALVES E51-0553 & E51-0554			
4	TTC	G –	11 27 01	RELEASED FOR RECORD			
3	TGT	B 2	01 26 01	ADDED LINE NUMBERS CORRECTED EQUIPMENT NAME			
2	TGT	B 2	10 20 00	RELEASED FOR DESIGN WITH PIPING DWGS.			
1	TGT	B 5	09 18 00	GENERAL REVISION			
0	TGT	B –	07 28 00	INCORPORATED HAZOP COMMENTS & RELEASED FOR DESIGN			
A	JZC	A –	06 12 00	RELEASED FOR CLIENT APPROVAL		TGT	

NOTE: CIRCLE ALL REVISIONS. IDENTIFY WITH DIAMOND, NUMBER AND ARROW. REMOVE ONLY CIRCLE AND ARROW BEFORE NEXT REVISION.

ISSUE CODE					
A	PRELIMINARY	C	MAT'L T.O.	F	CONST'N
B	DESIGN	D	MAT'L PURC.	G	RECORD
		E	BIDS		

SEAL

SIGNATURE

DATE

BE&K ENGINEERING OF NORTH CAROLINA, INC.
2000 PERIMETER PARK DRIVE,SUITE 100
MORRISVILLE,NORTH CAROLINA 27560

DR. J. CARPENTER	DATE 06/06/00
DSGN. T. TOMPKINS	FILE
CK. D. BROWN	NUMBER
DPE T. TOMPKINS	JOB NO. 99-2047
Cadfile Name: CADFILE: 51MF016.DGN	

BOWATER
COATED PAPER & PULP DIV.
P O Box 7, Catawba, South Carolina 29704

DRAWING TITLE
CLUSTER RULE PROJECT
COND. STRIPPER SYS.

UTILITY FLOW DIAGRAM

BE&K DRAWING NUMBER
047-PO-004

CLIENT DRAWING NUMBER
CTE-51MF-016

RECEIVED
MAR 23 2006
BOWATER CAROLINA
ENGINEERING

RECORD DRAWING
BY _____ DATE _____